
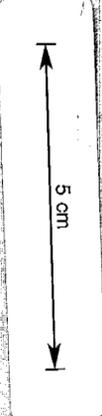


217-01

— MT BISCHOFF T.M.CO.REG —

— NORTH EAST LODGE —

— SCALE 25 FT TO 1 INCH —

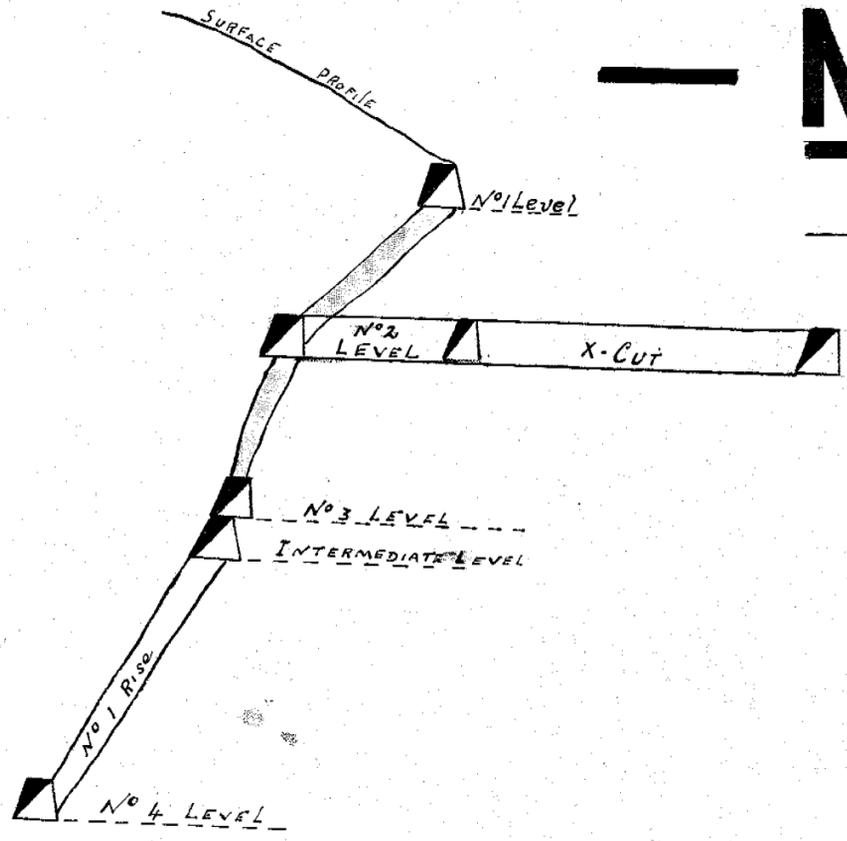

TRANSVERSE SECTION

Work 1934
Surveyor W. D. ...
Just used 5" theod and compass

217-01