


MT. BISCHOFF T M CO. REG.

Nº 1 NORTH-EAST LODE

217-02

SCALE 25 FT = 1 IN.

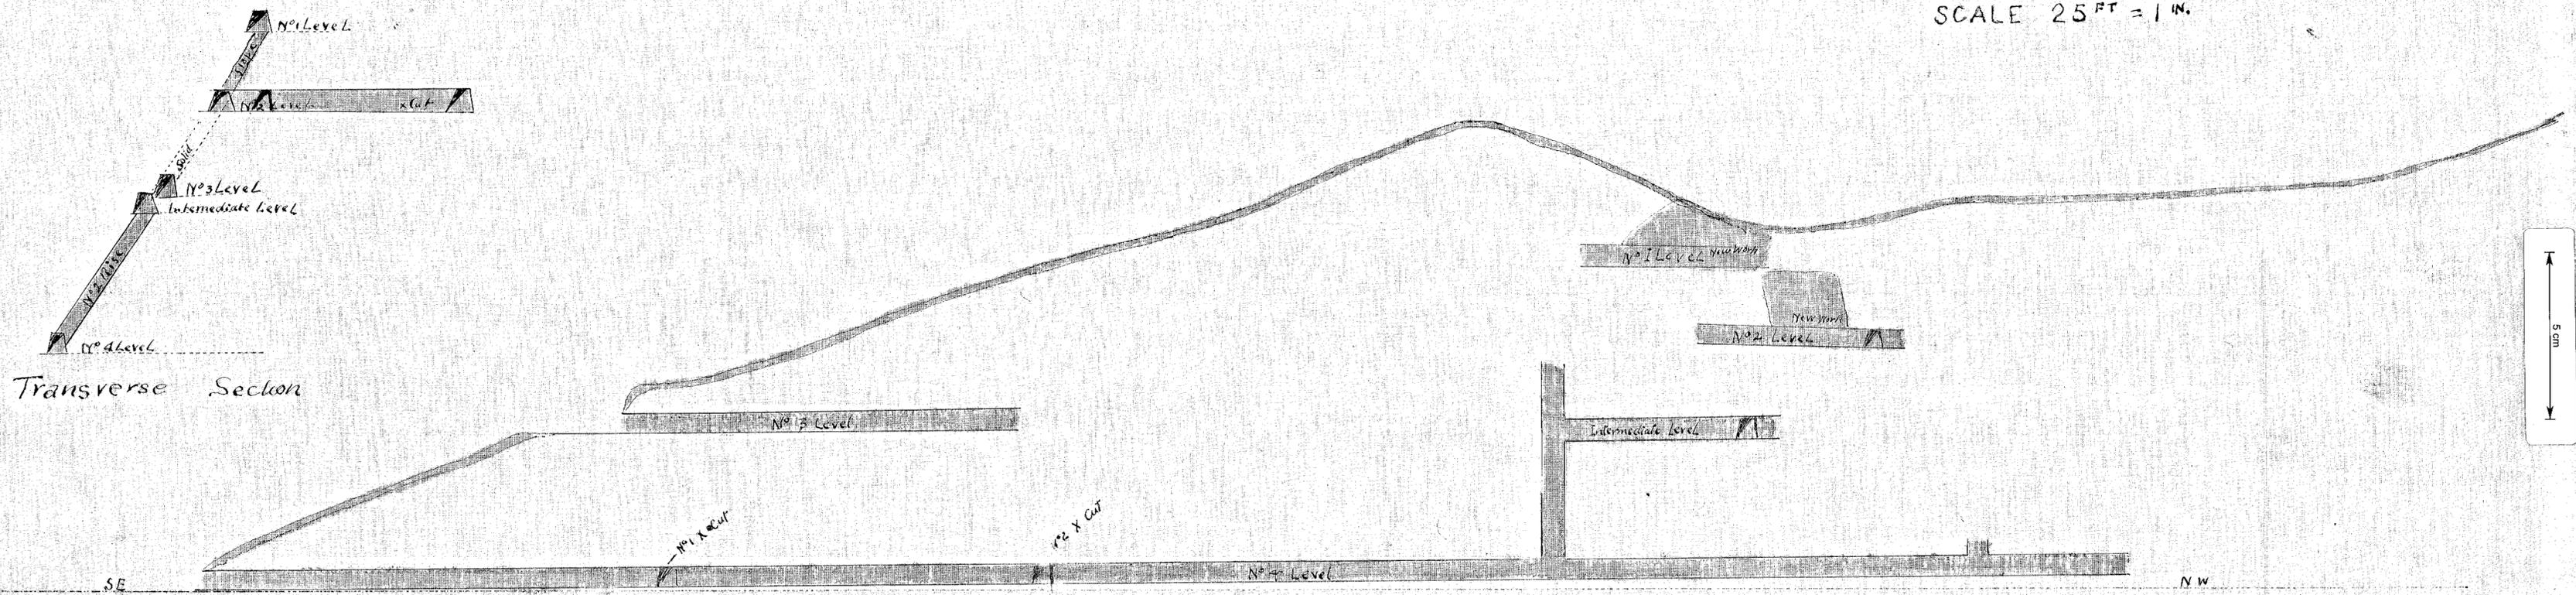

Transverse Section

5 cm

Surveyor W. D. Tate
Sut and G. Woodruff
11/3/32

217-02