



217-03

500E
600E
700E
800E
900E
1000N
1100N
1200N
1300N
1400N

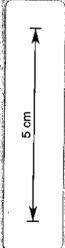

217-03

Surveyor W. Post
Int and 4th Throblott
11/3/32

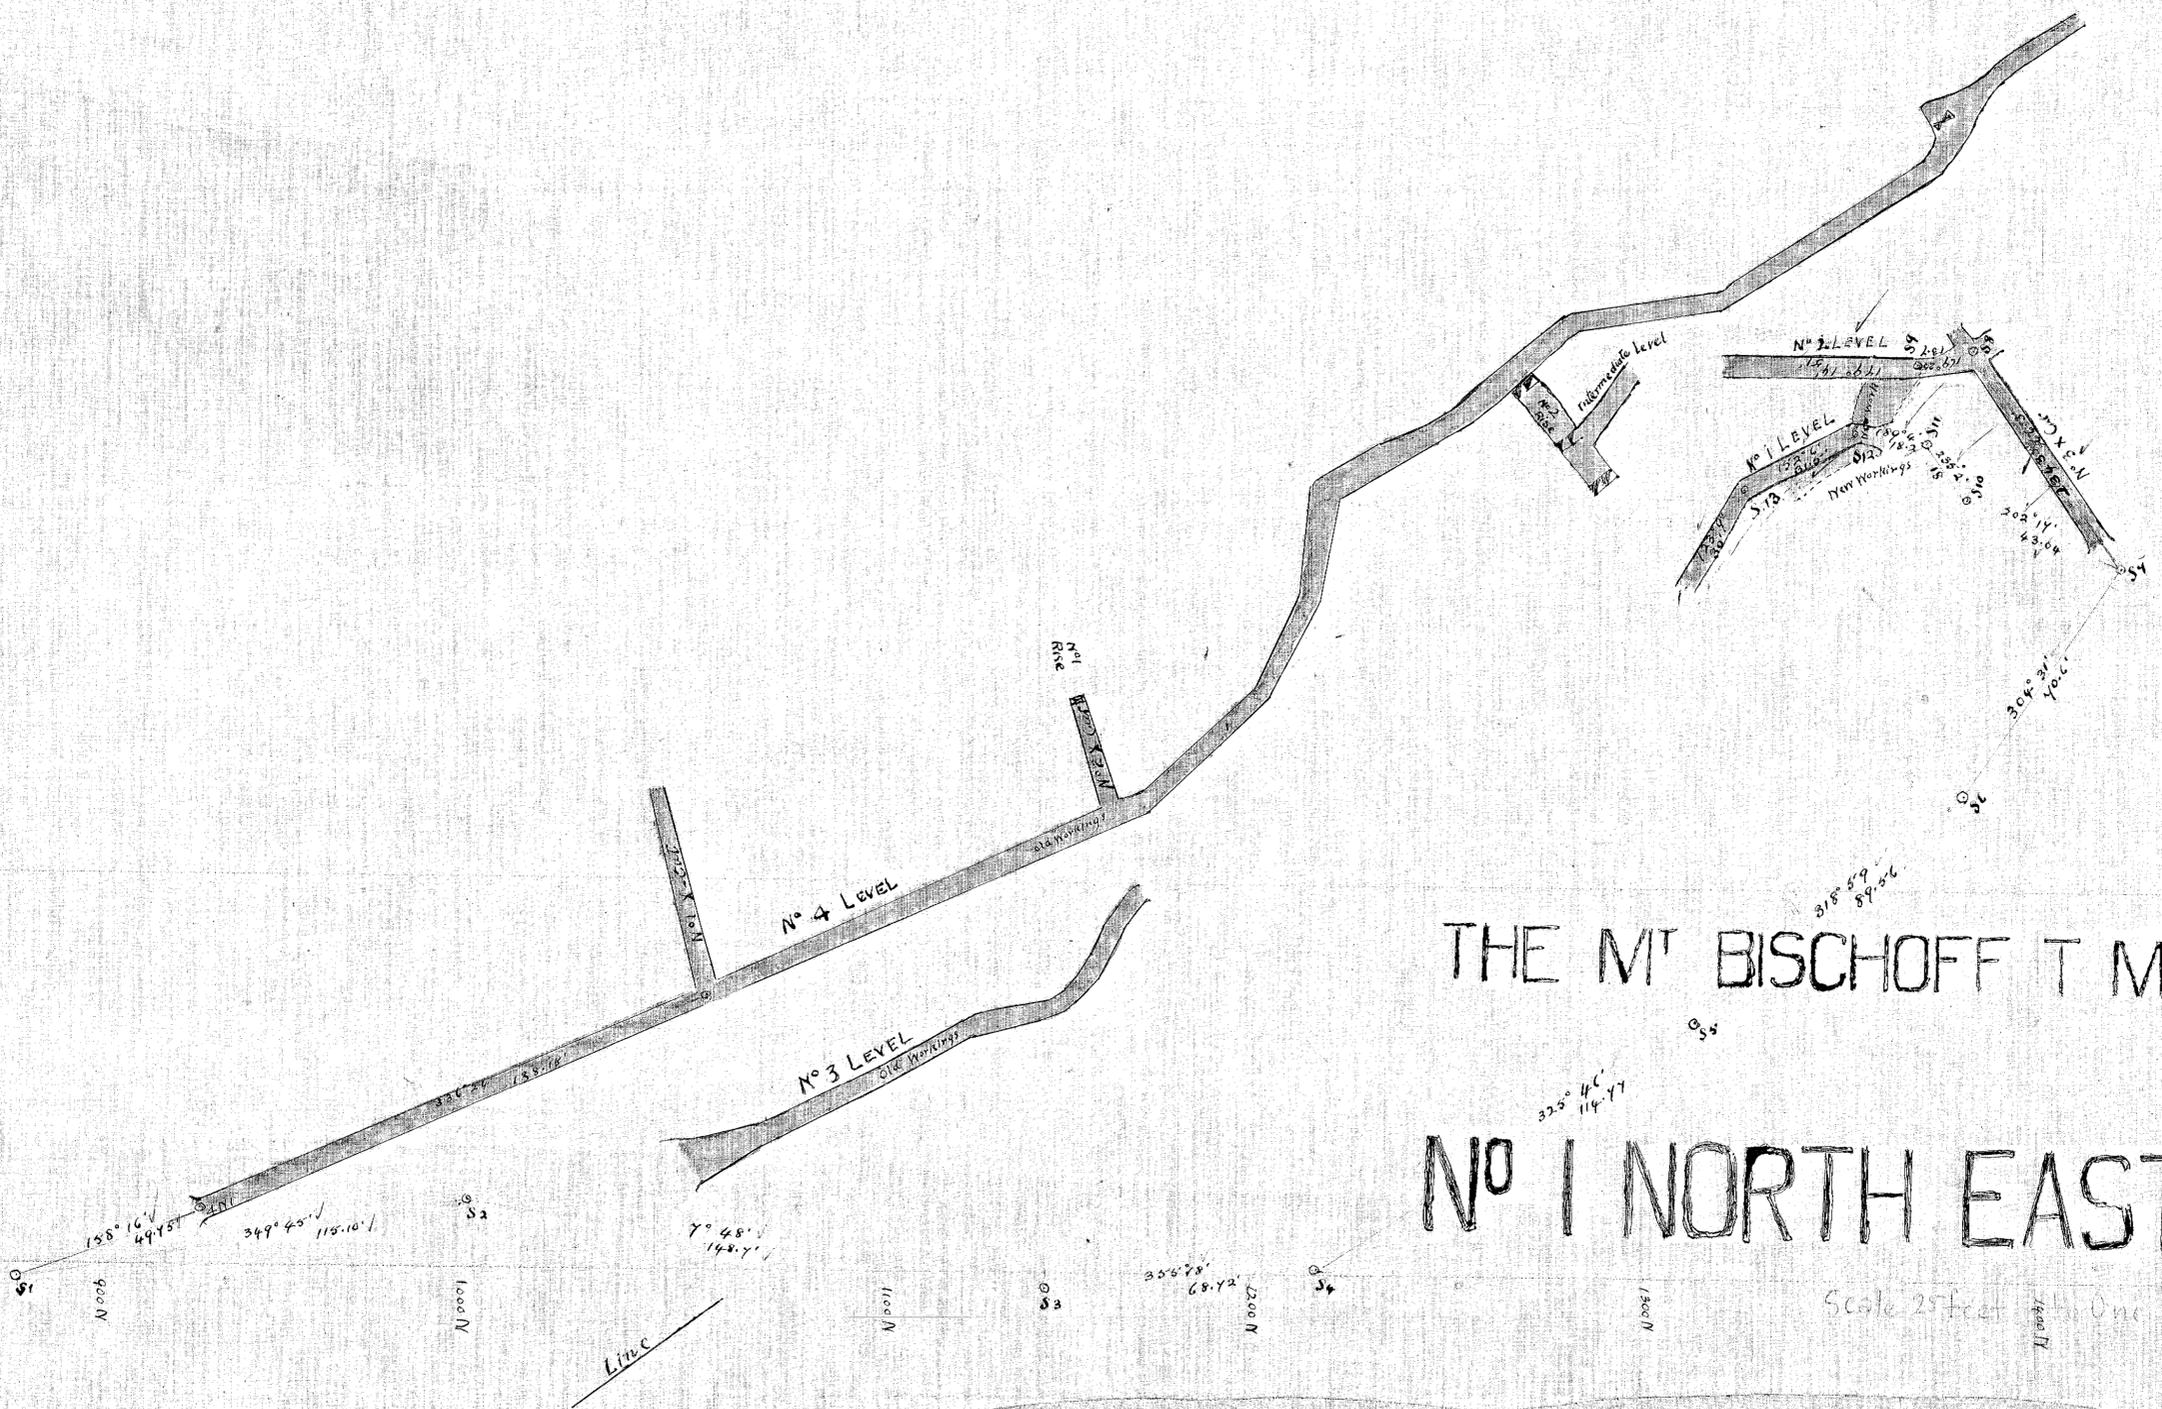

THE M^r BISCHOFF T M COY REG

N^o 1 NORTH EAST LODGE

Scale 25 feet to One Inch

Ed
11/3/32