


THE MT BISCHOFF T. M. COY REG

- NO 1 NORTH EAST LODGE -

217-04

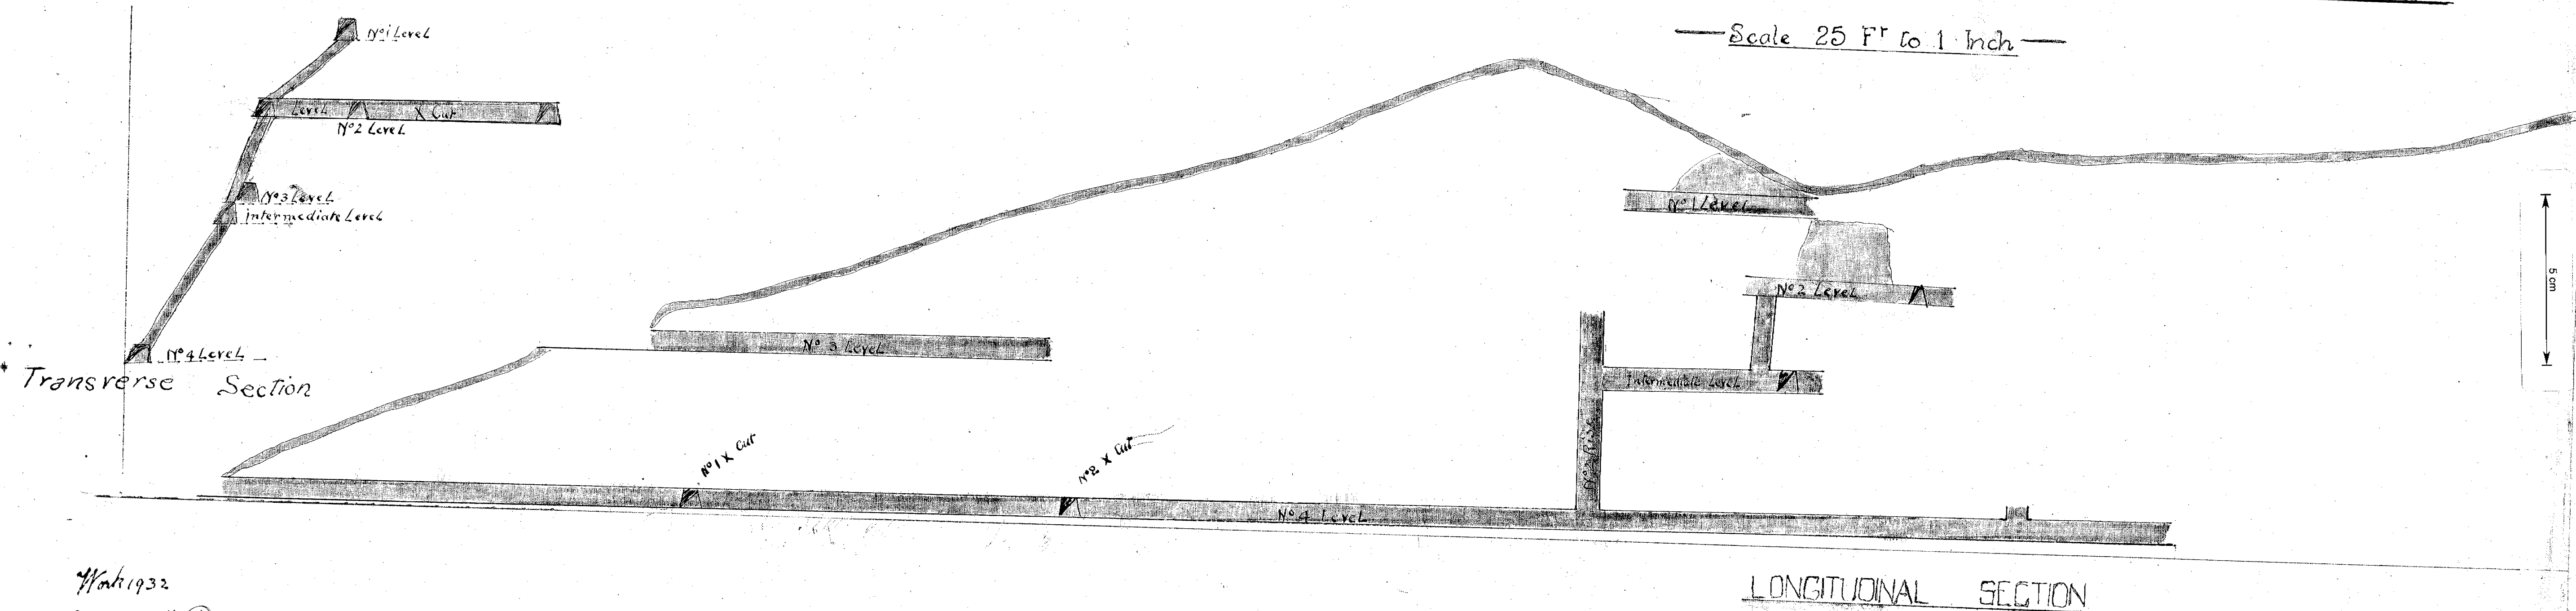

Work 1932

Surveyor W. Porter used 4" theodolite

10/4/33

217-04