


— MT BISCHOFF T.M.CO.REG —
— NORTH EAST LODGE —

— LONGITUDINAL SECTION —

— SCALE 25 FT TO 1 INCH —

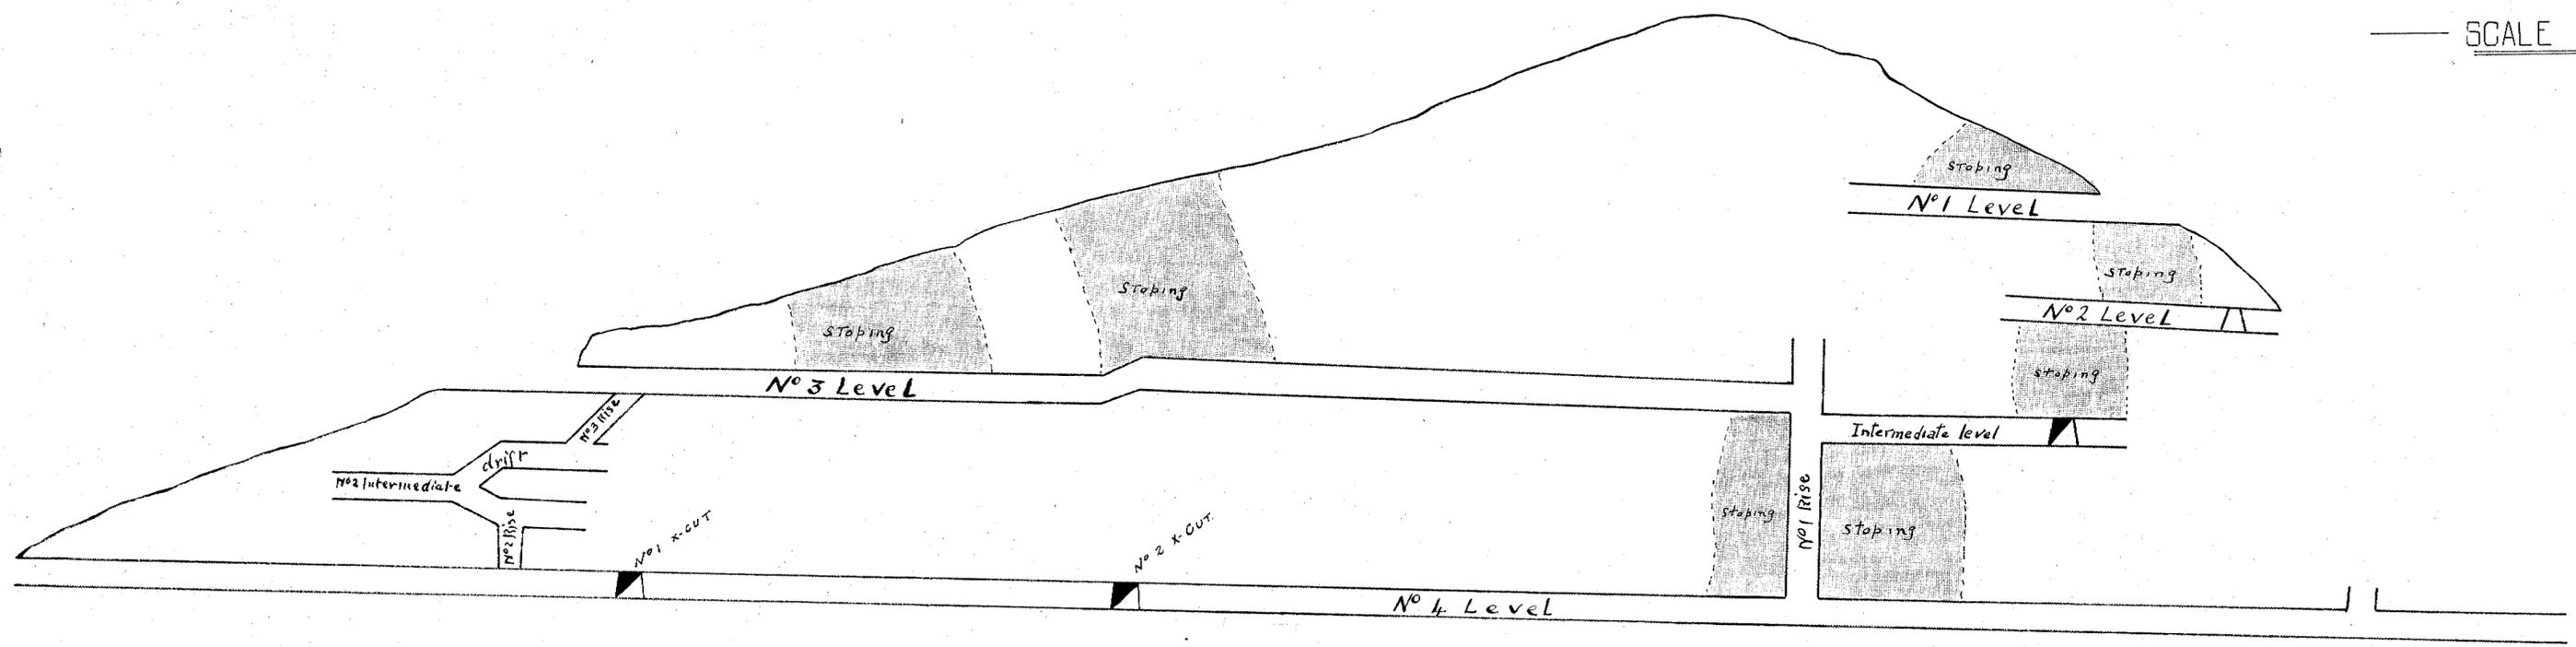

Work 1934
Surveyor W.D. Doherty
but used 5" theodolite and compass

217-05

5 cm

217-05