


MT BISCHOFF T. M. COMPANY'S,



UNDER GROUND WORKS.

Scale 50 feet to one Inch

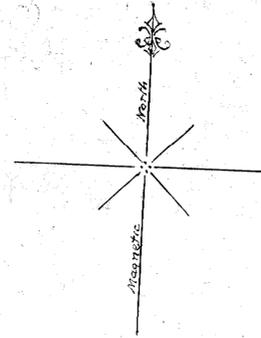

Section 35

80 Acres

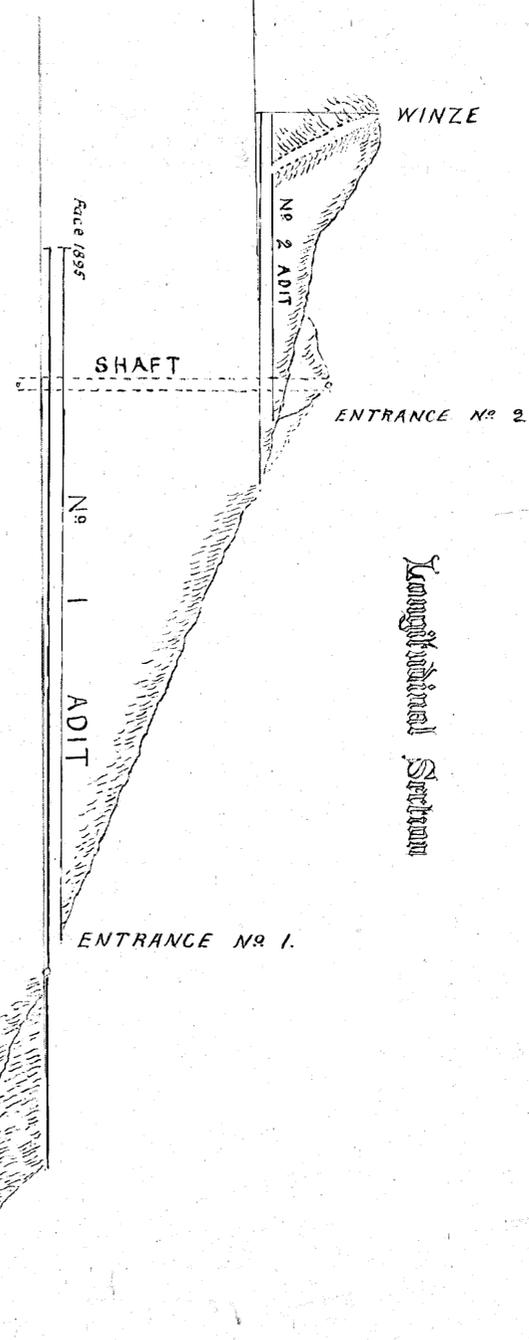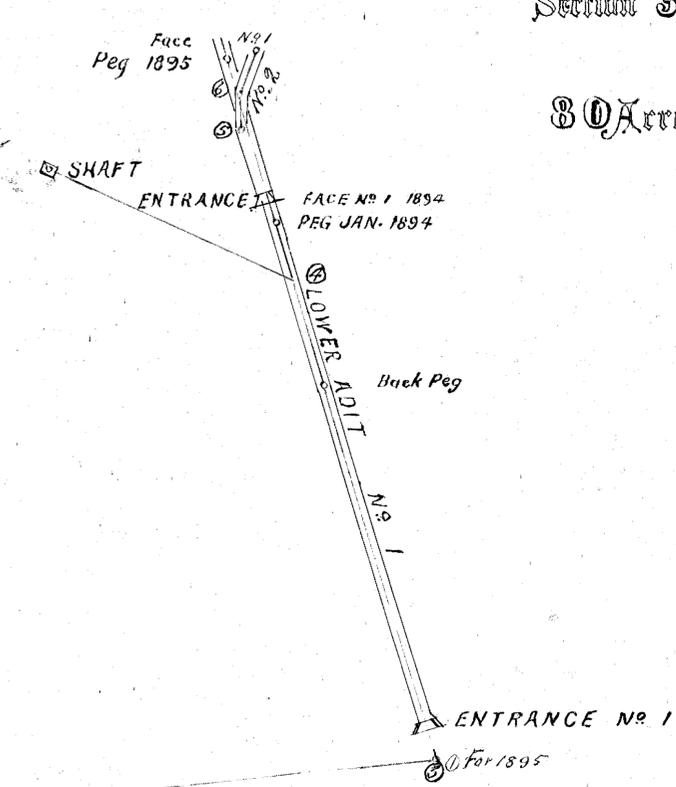

Sec. 7

80 Acres

WARATAH

FEBRUARY 16<sup>TH</sup> 1895

*David Jones*

DISTRICT SURVEYOR.

27-07

27-07

1895