


1896

MT BISCHOFF T. M. COMPANY'S,  
UNDER GROUND WORKS.  
Scale 50 feet to one Inch

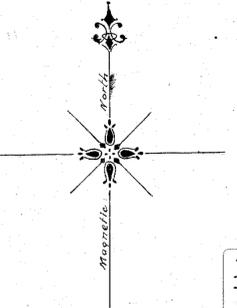

21708


3960 LINKS  
90°

Section 7


80 Acres.

Section 35

80 Acres.

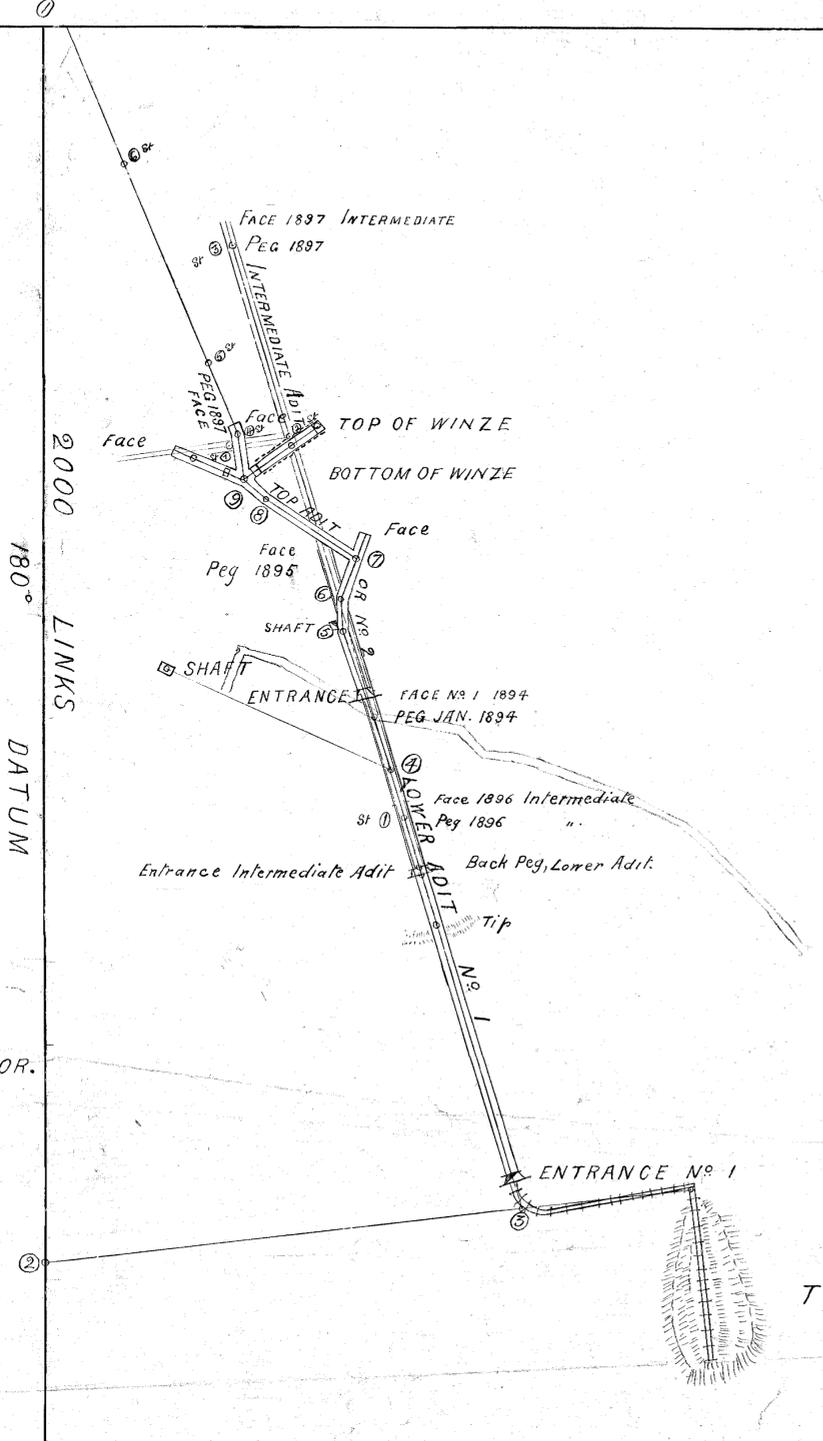

Plan

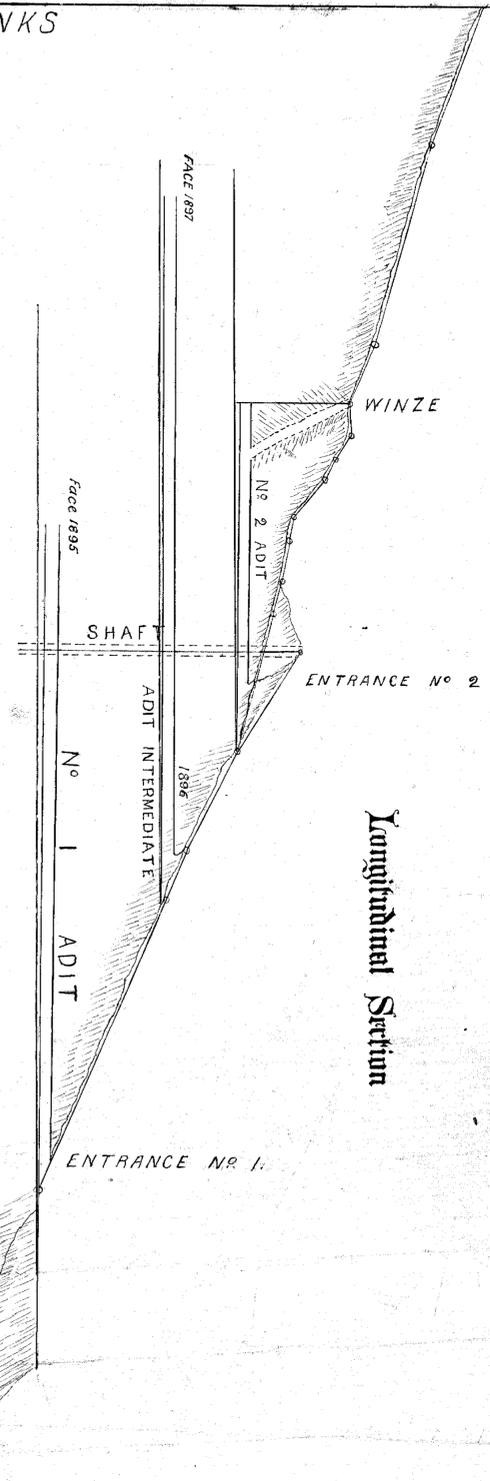

Longitudinal Section

WARATAH  
JANUARY 22<sup>nd</sup> 1897

*L. M. Jones*  
DISTRICT SURVEYOR.

217-08