


217-09

# MT BISCHOFF T.M. COMPANY

## UNDERGROUND WORKINGS

Scale 50 Feet to an inch

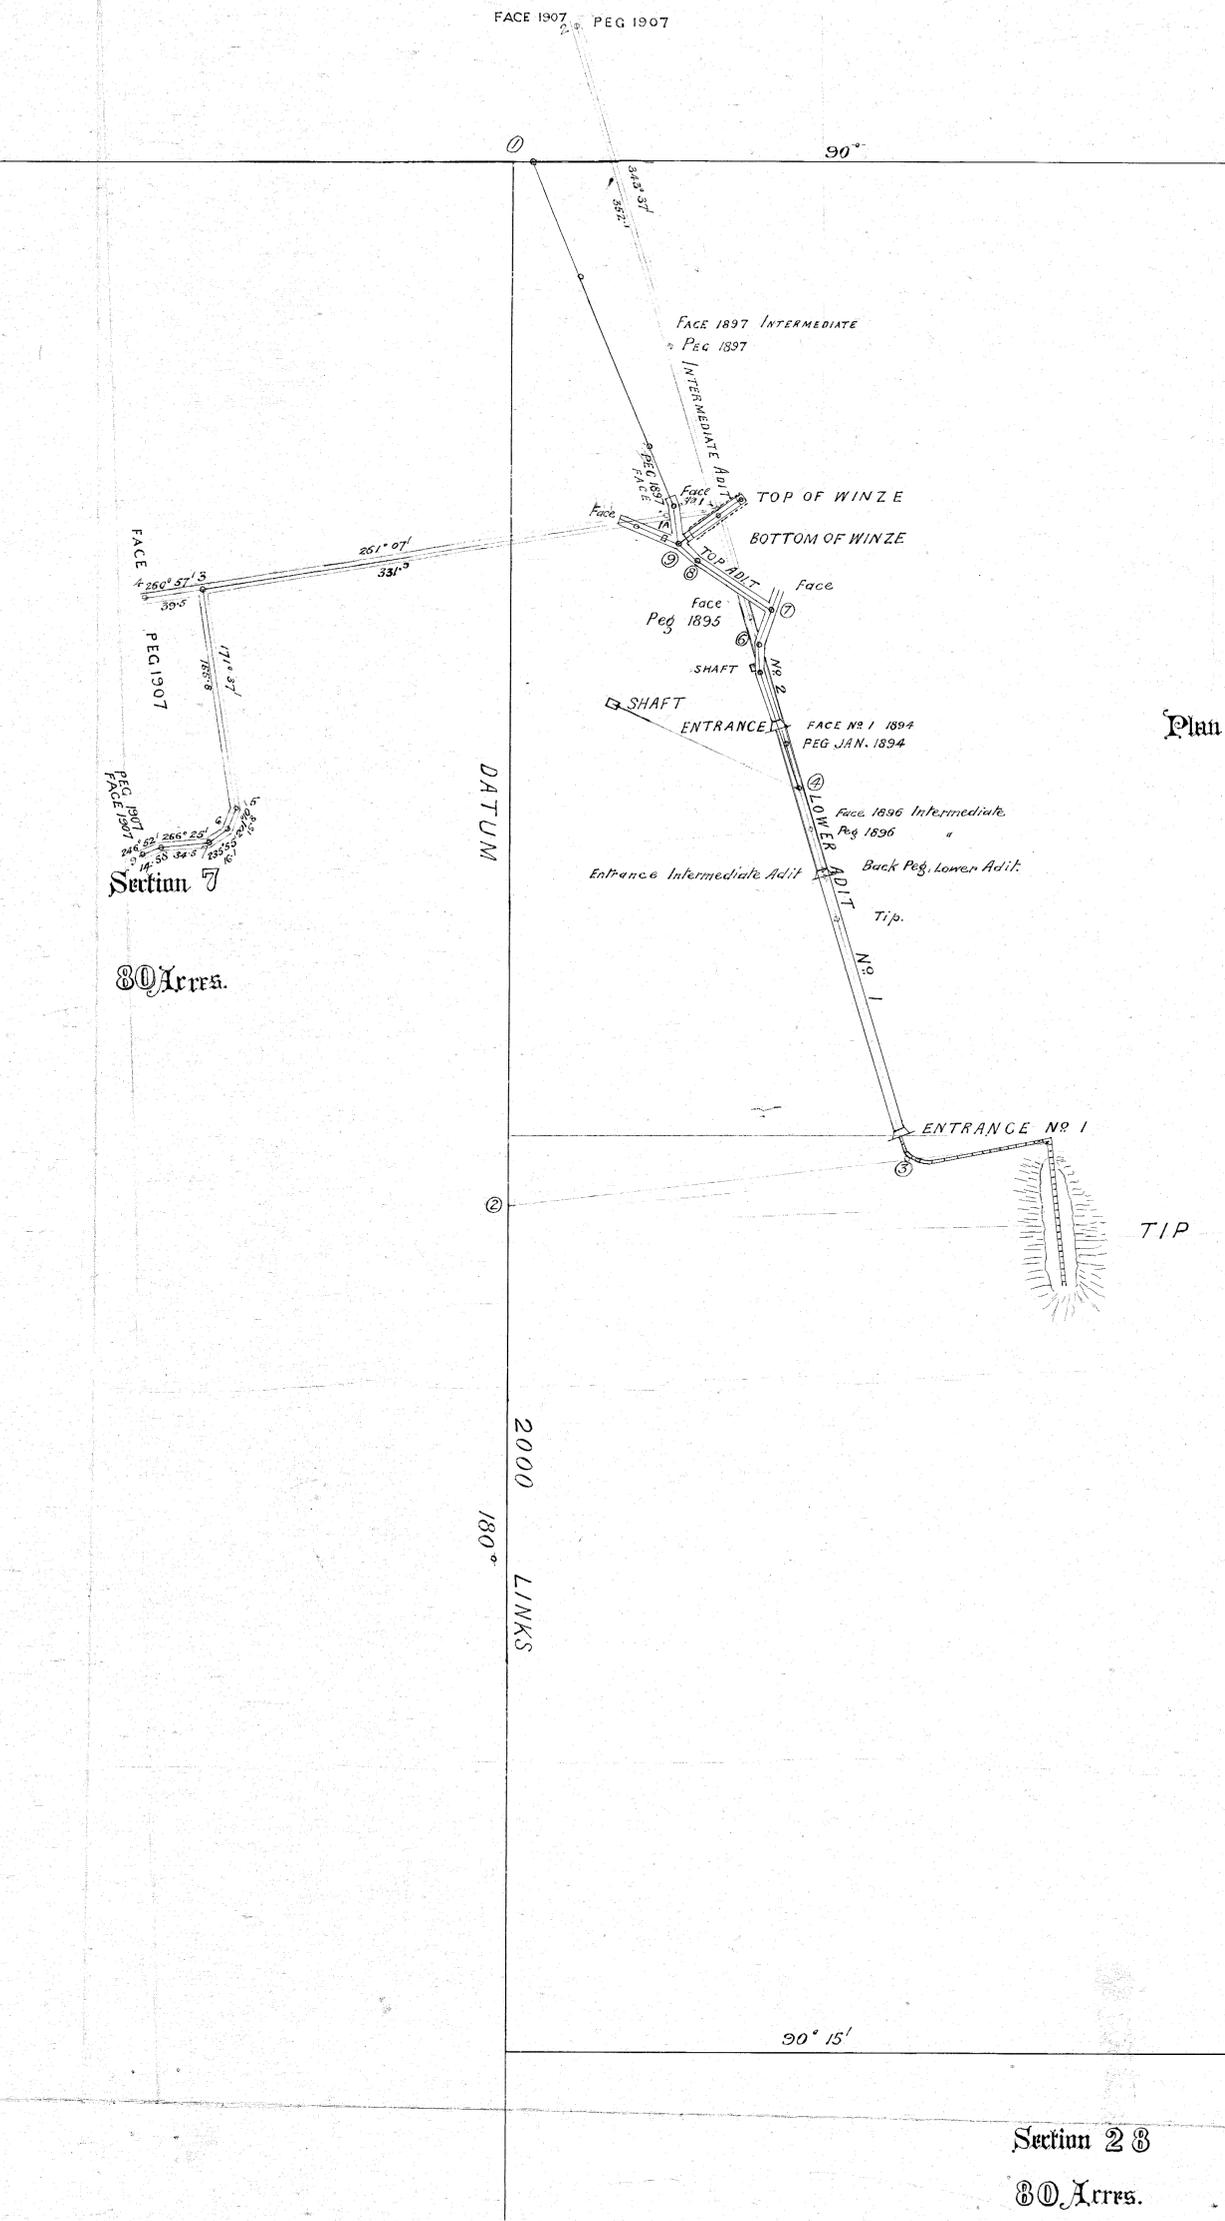

Plan

Section 35

30 Acres.

Section 7

30 Acres.

Section 28

30 Acres.

I, David Jones, of Waratah, hereby declare this plan to be sufficiently correct for the purposes of the Mines Act of 1893 and 1900.

*David Jones*  
District Surveyor  
Waratah, Tas.