


# MT BISCHOFF T. M. COMPANY'S,

## UNDER GROUND WORKS.

Scale 50 feet to one Inch



# 1894

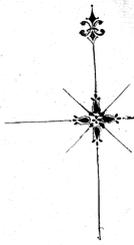

3960 LINKS 90°

Section 35

80 Acres.

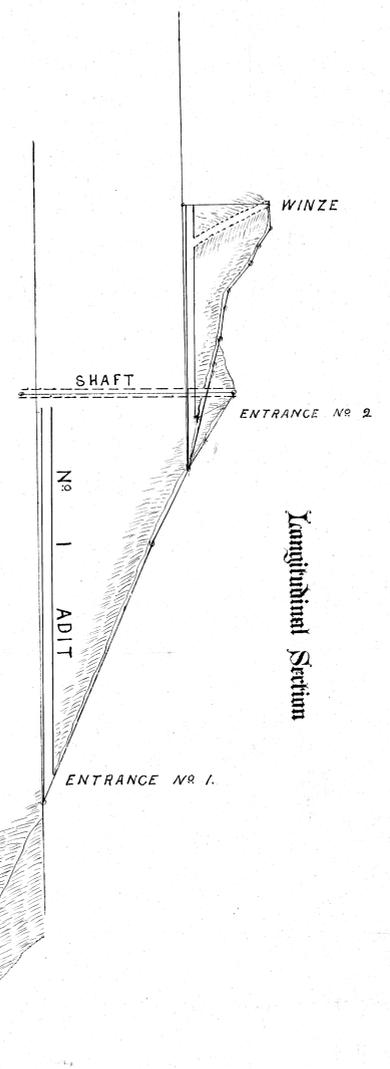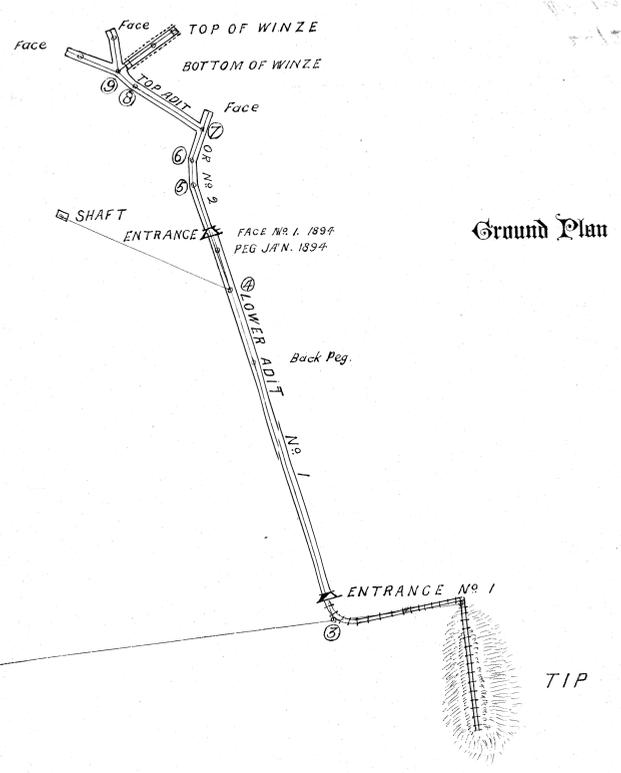

Section 7

80 Acres.

DATUM

2000 LINKS 180°

WARATAH

FEBRUARY 16<sup>TH</sup> 1894

*David Jones*

DISTRICT SURVEYOR.

3940 LINKS

90° 15'

Section 2 B

80 Acres.