


217-12

5 cm


Longitudinal Section

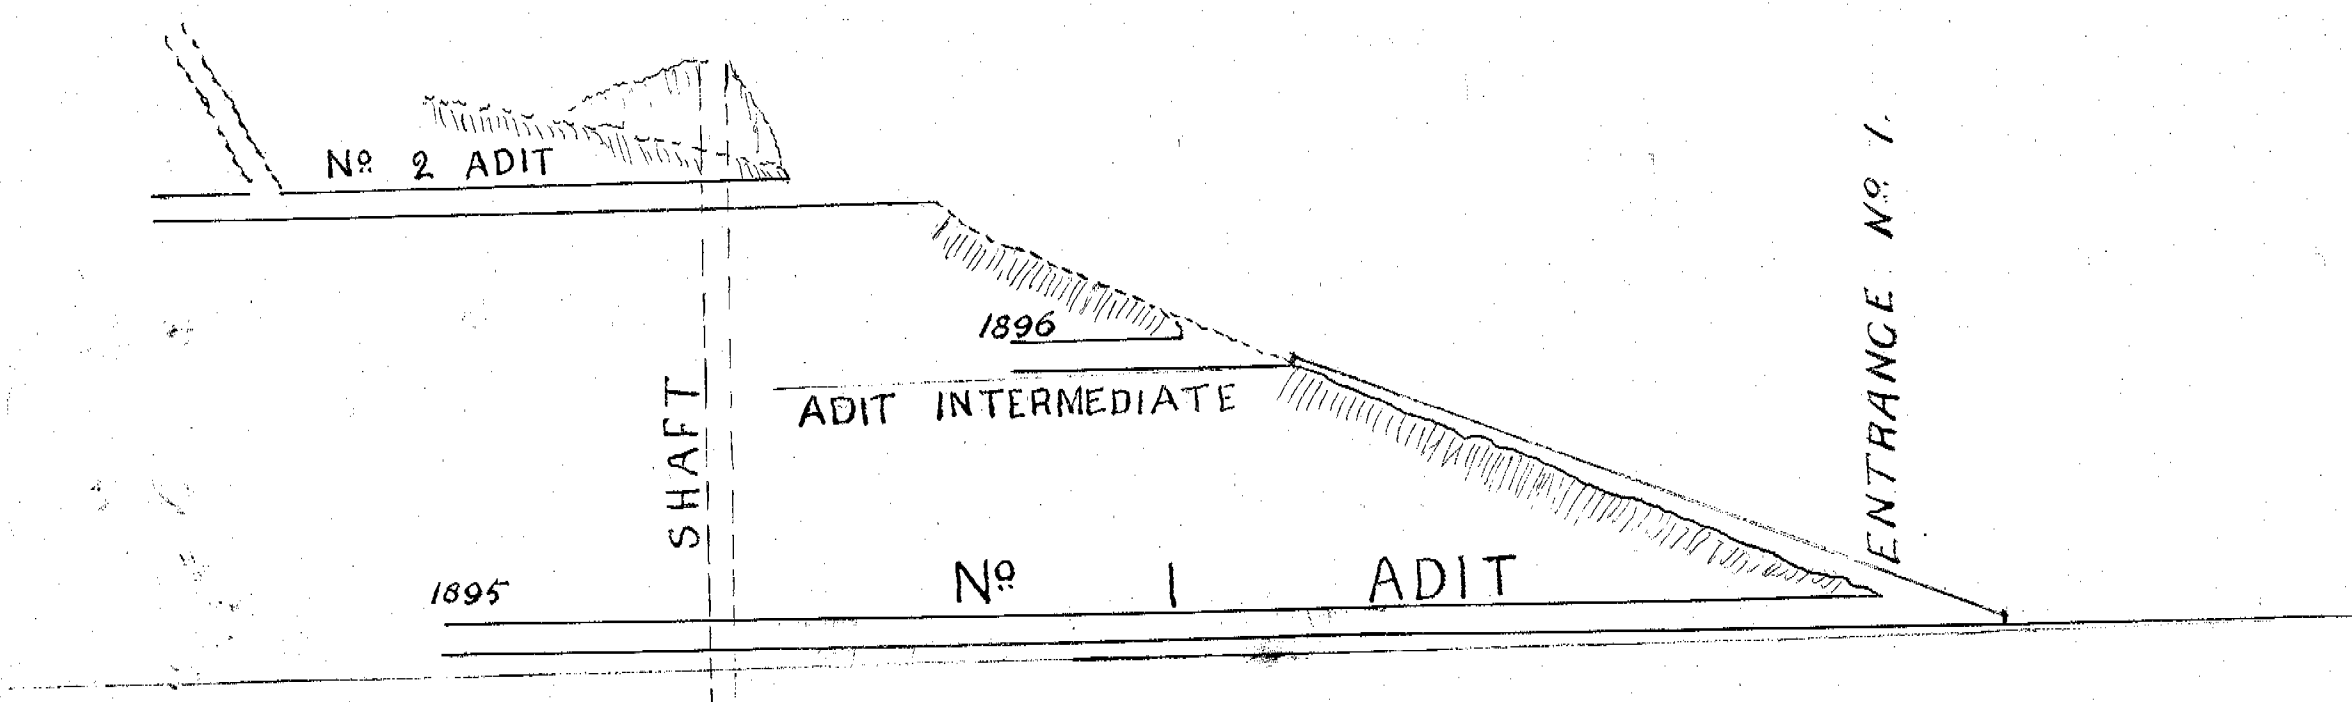

Section 35

W. H. C.

M. B. T. M. Co.

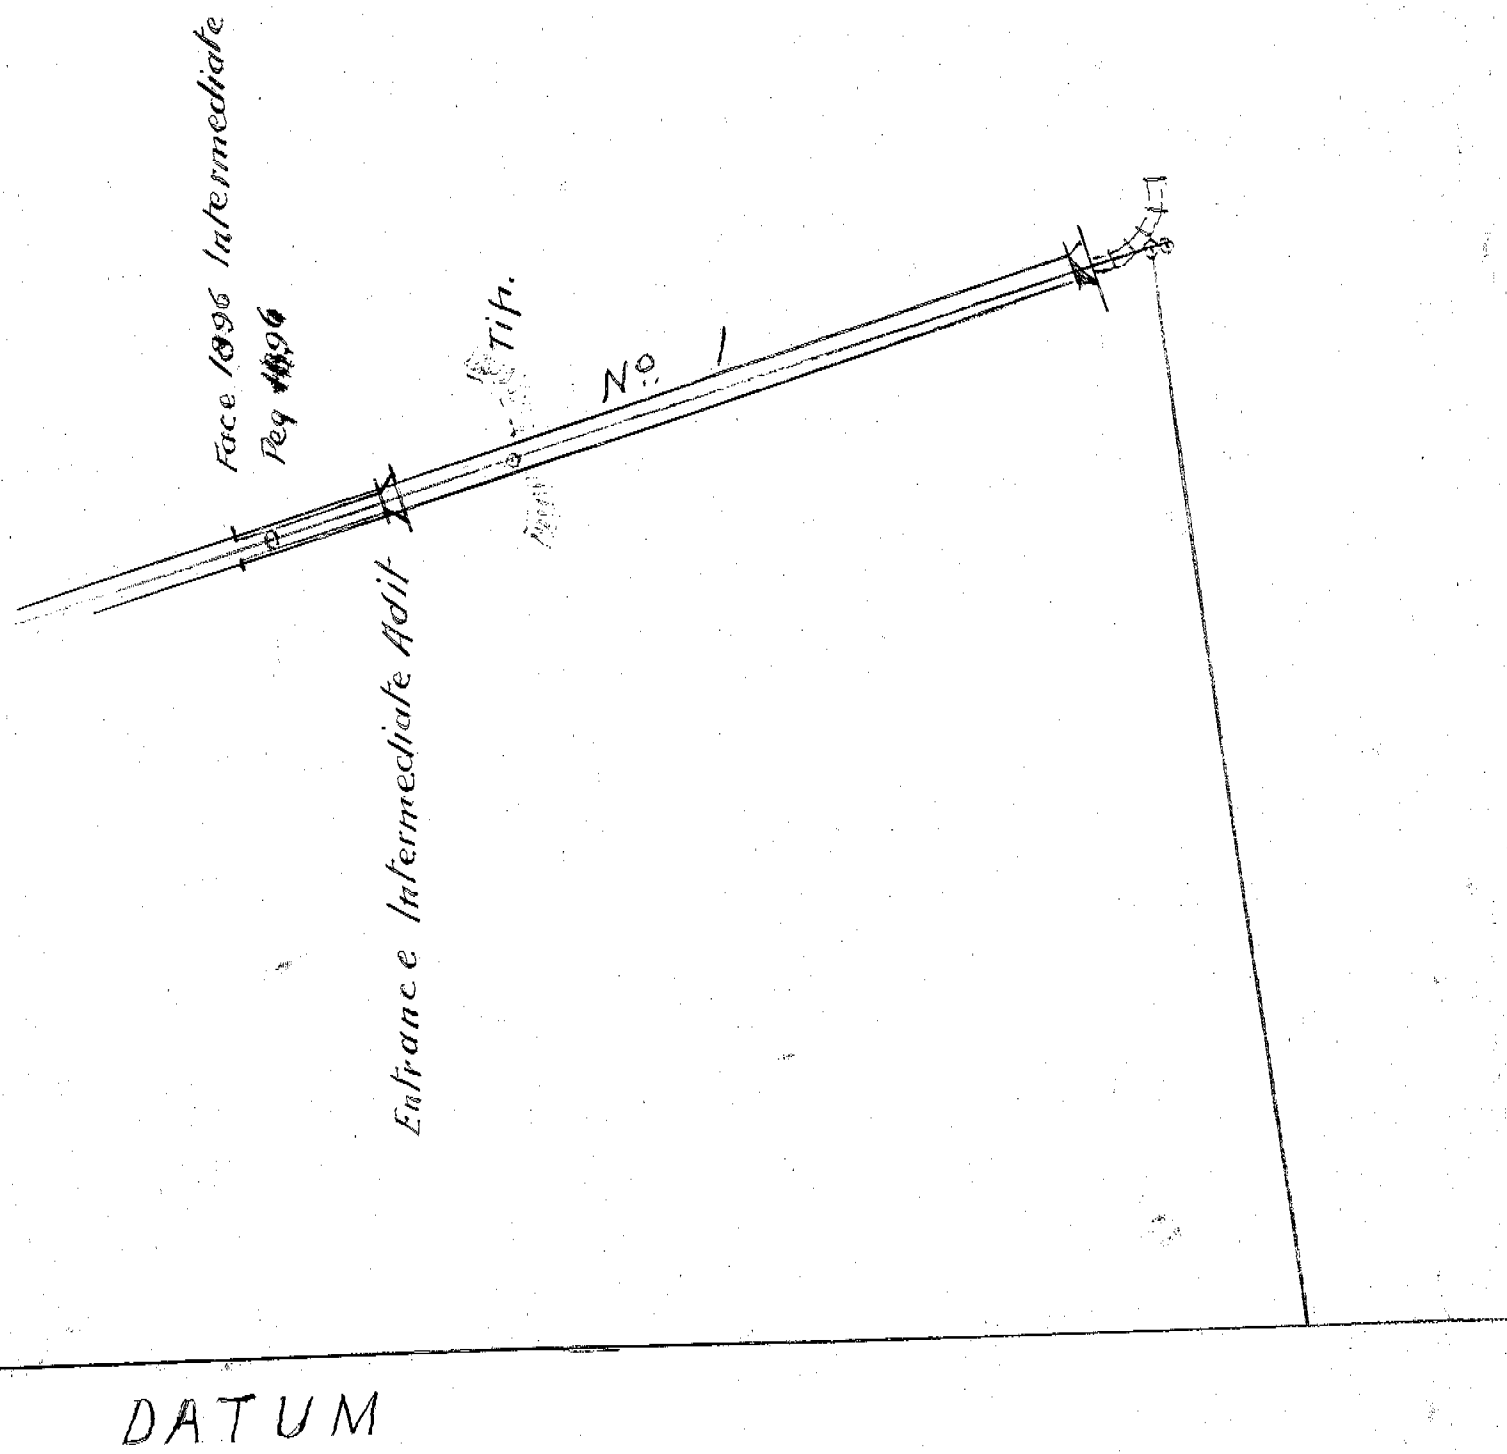

DATUM

W. H. C.
Dist Surveyor.
Granite
Jan 27th 1896.

