
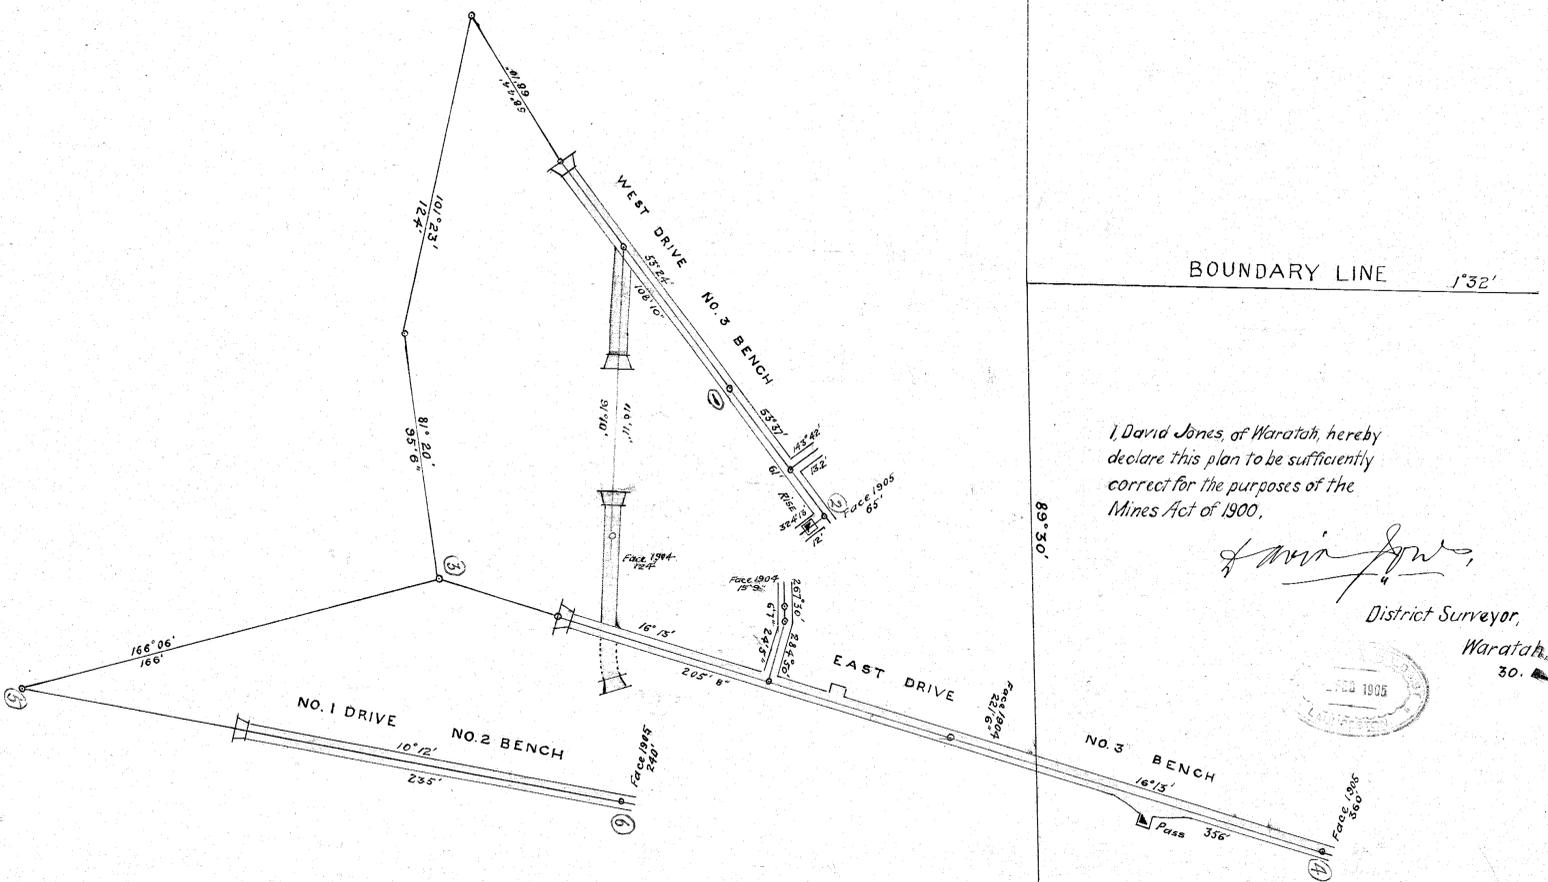
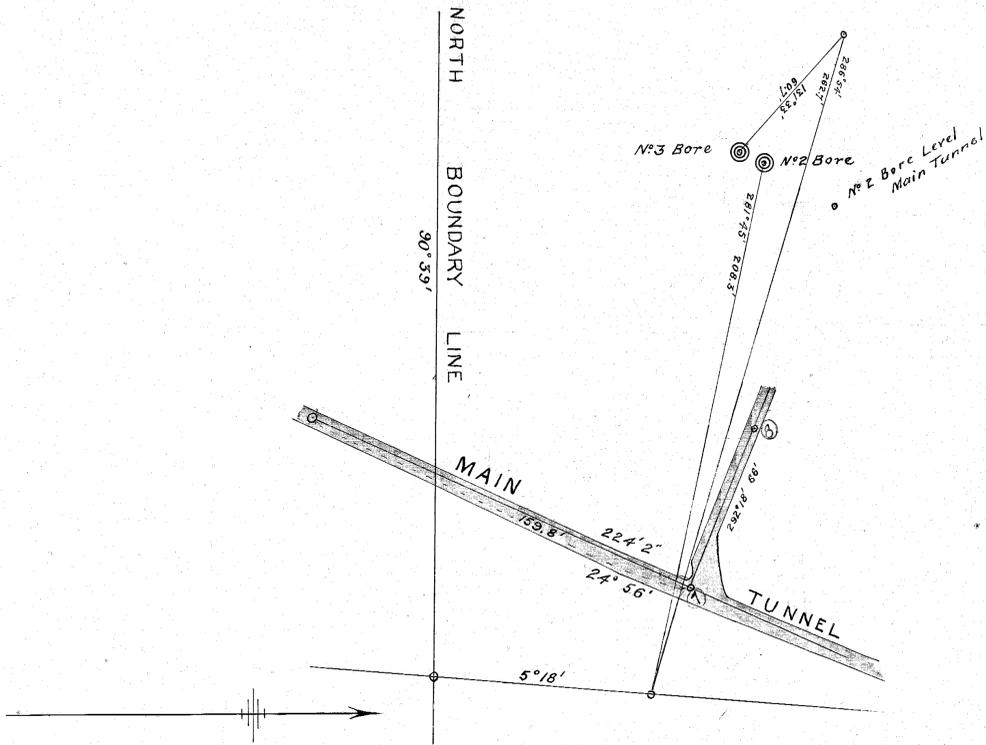


217-16

5 cm

Plan
 Mount Bischoff Tin Mining Co. Reg.
 Scale 30 Feet to 1 inch.

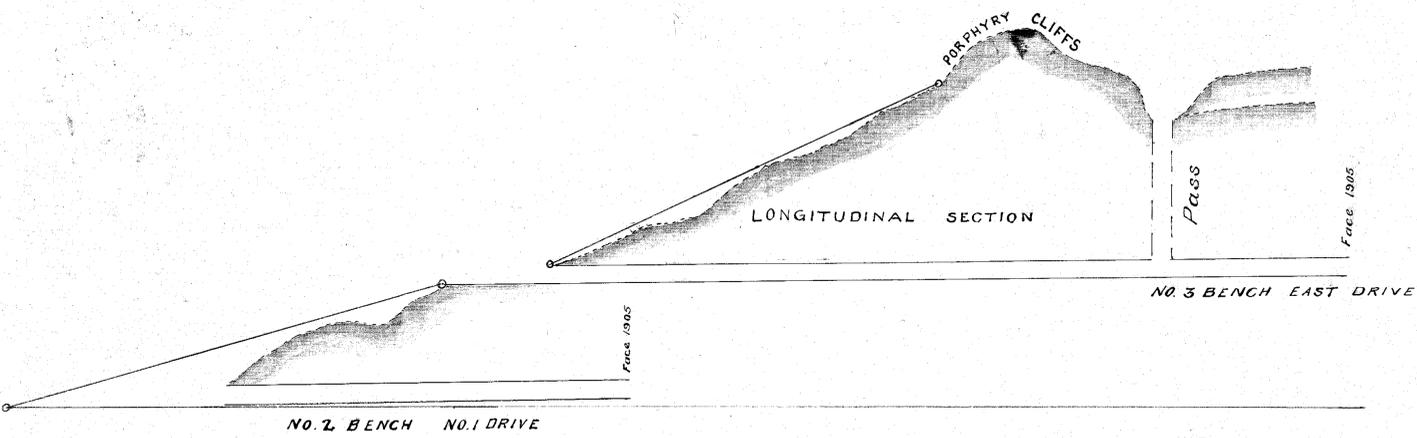

I, David Jones, of Waratah, hereby declare this plan to be sufficiently correct for the purposes of the Mines Act of 1900.

David Jones
 District Surveyor,
 Waratah, Tas.
 30. 1905

