


MT BISCHOFF T.M.CO.REG.

NORTH WEST LODGE


LONGITUDINAL SECTION

SCALE 25 FT TO 1 INCH

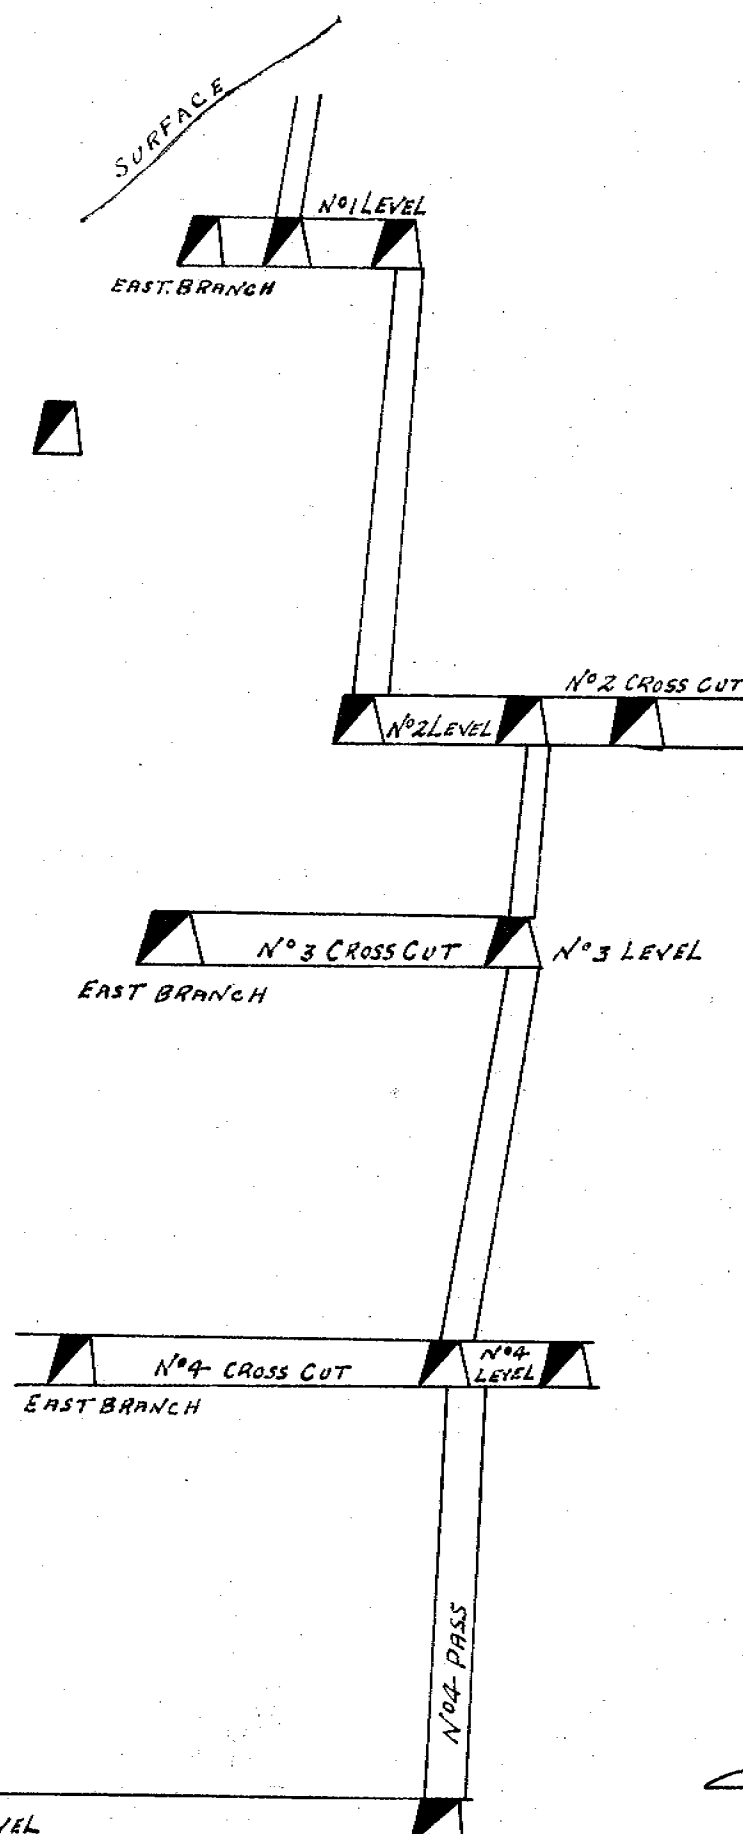

Transverse Section.

*Work 1905
summer W.H. Dole
but used 6" theodolite*

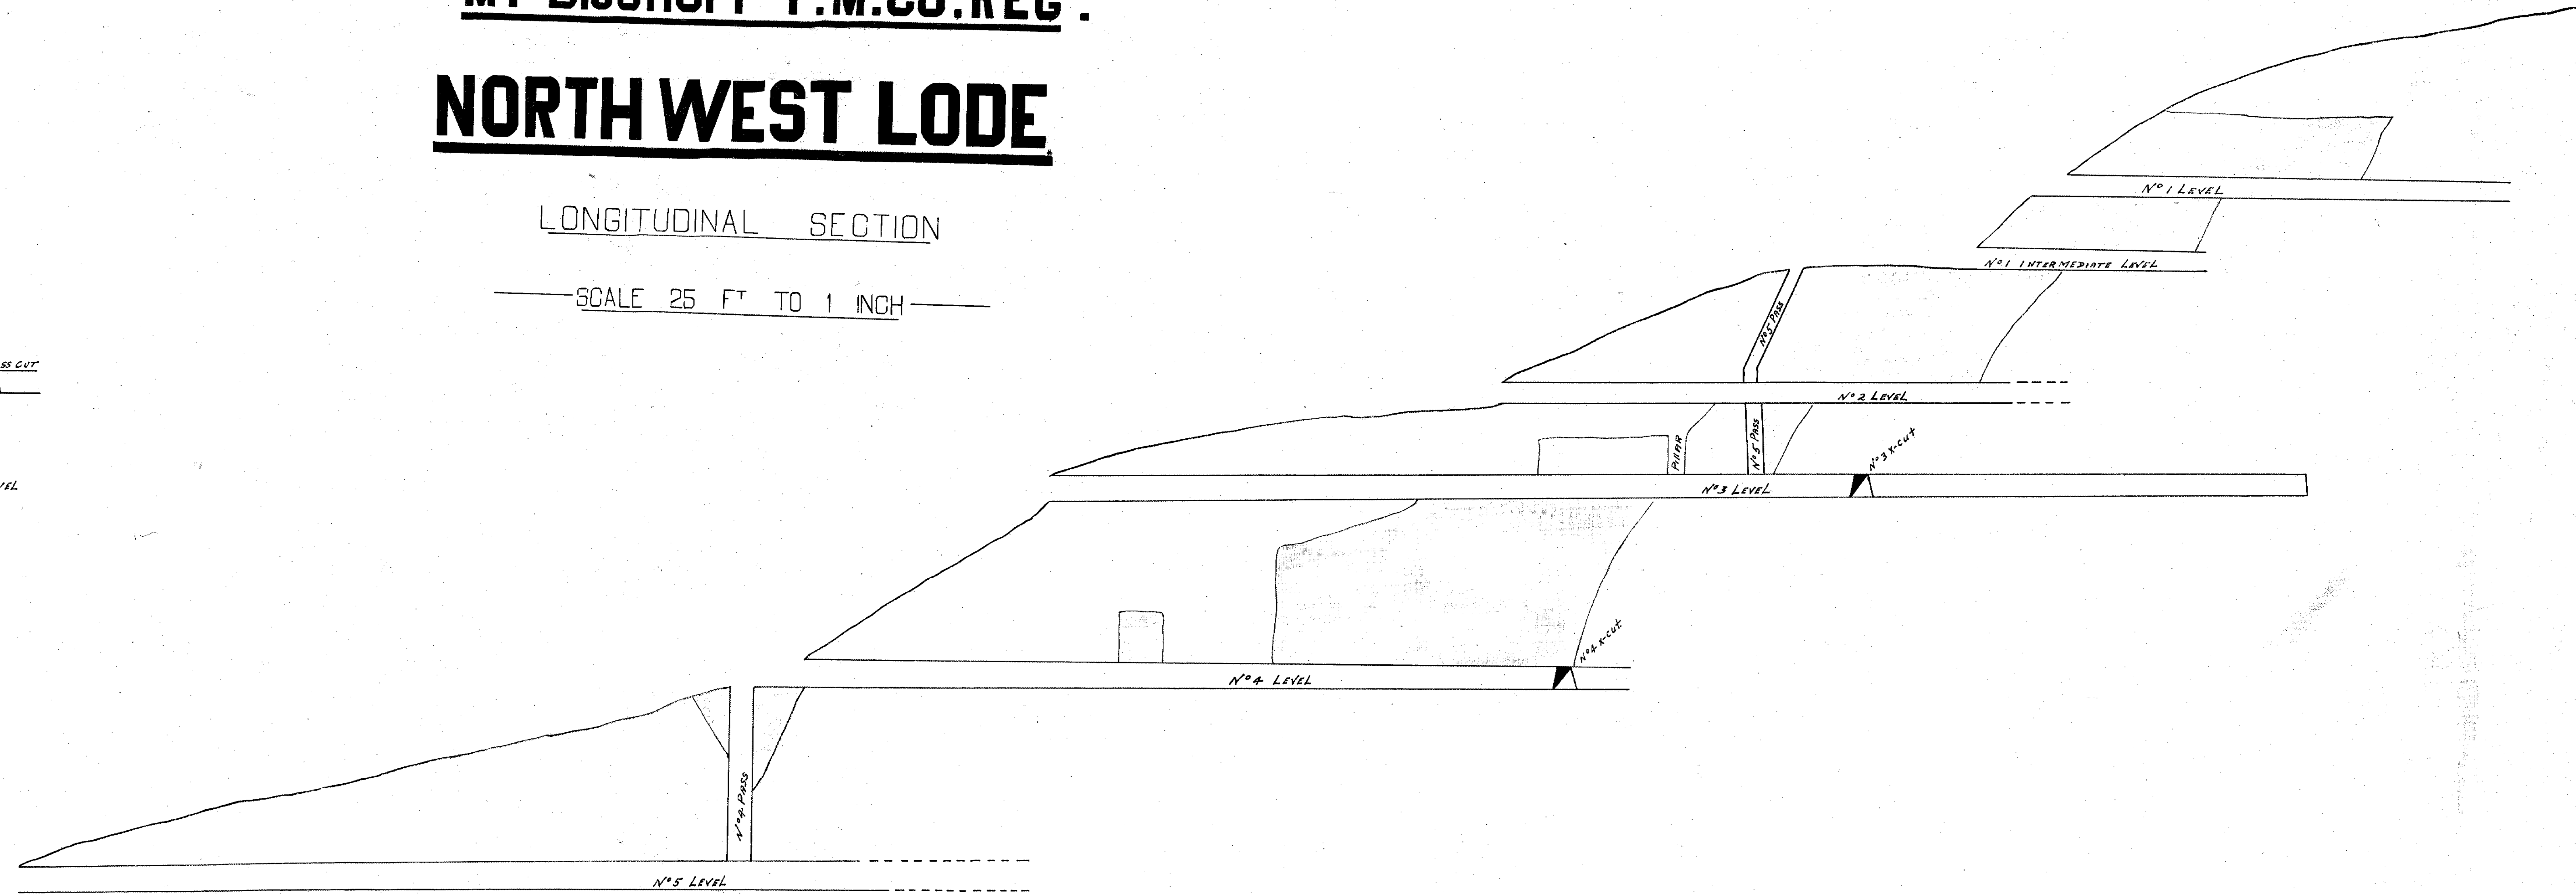

217-19

5 cm

217-18
TOLARIE

217-19