

217-20

# MT BISCHOFF T M CO REC


## NORTH WEST LODE

LONGITUDINAL SECTION


Scale: 25 FT to 1 Inch.

5 cm

217-20

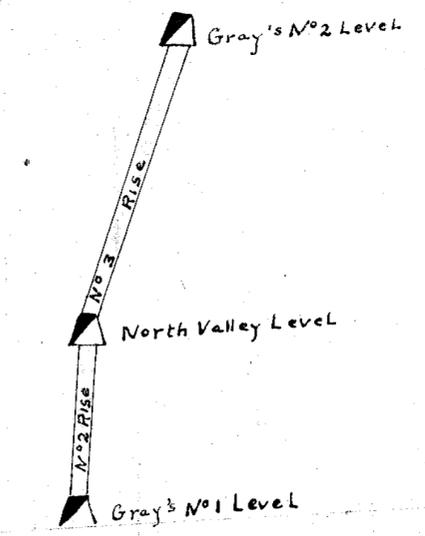

Transverse Section

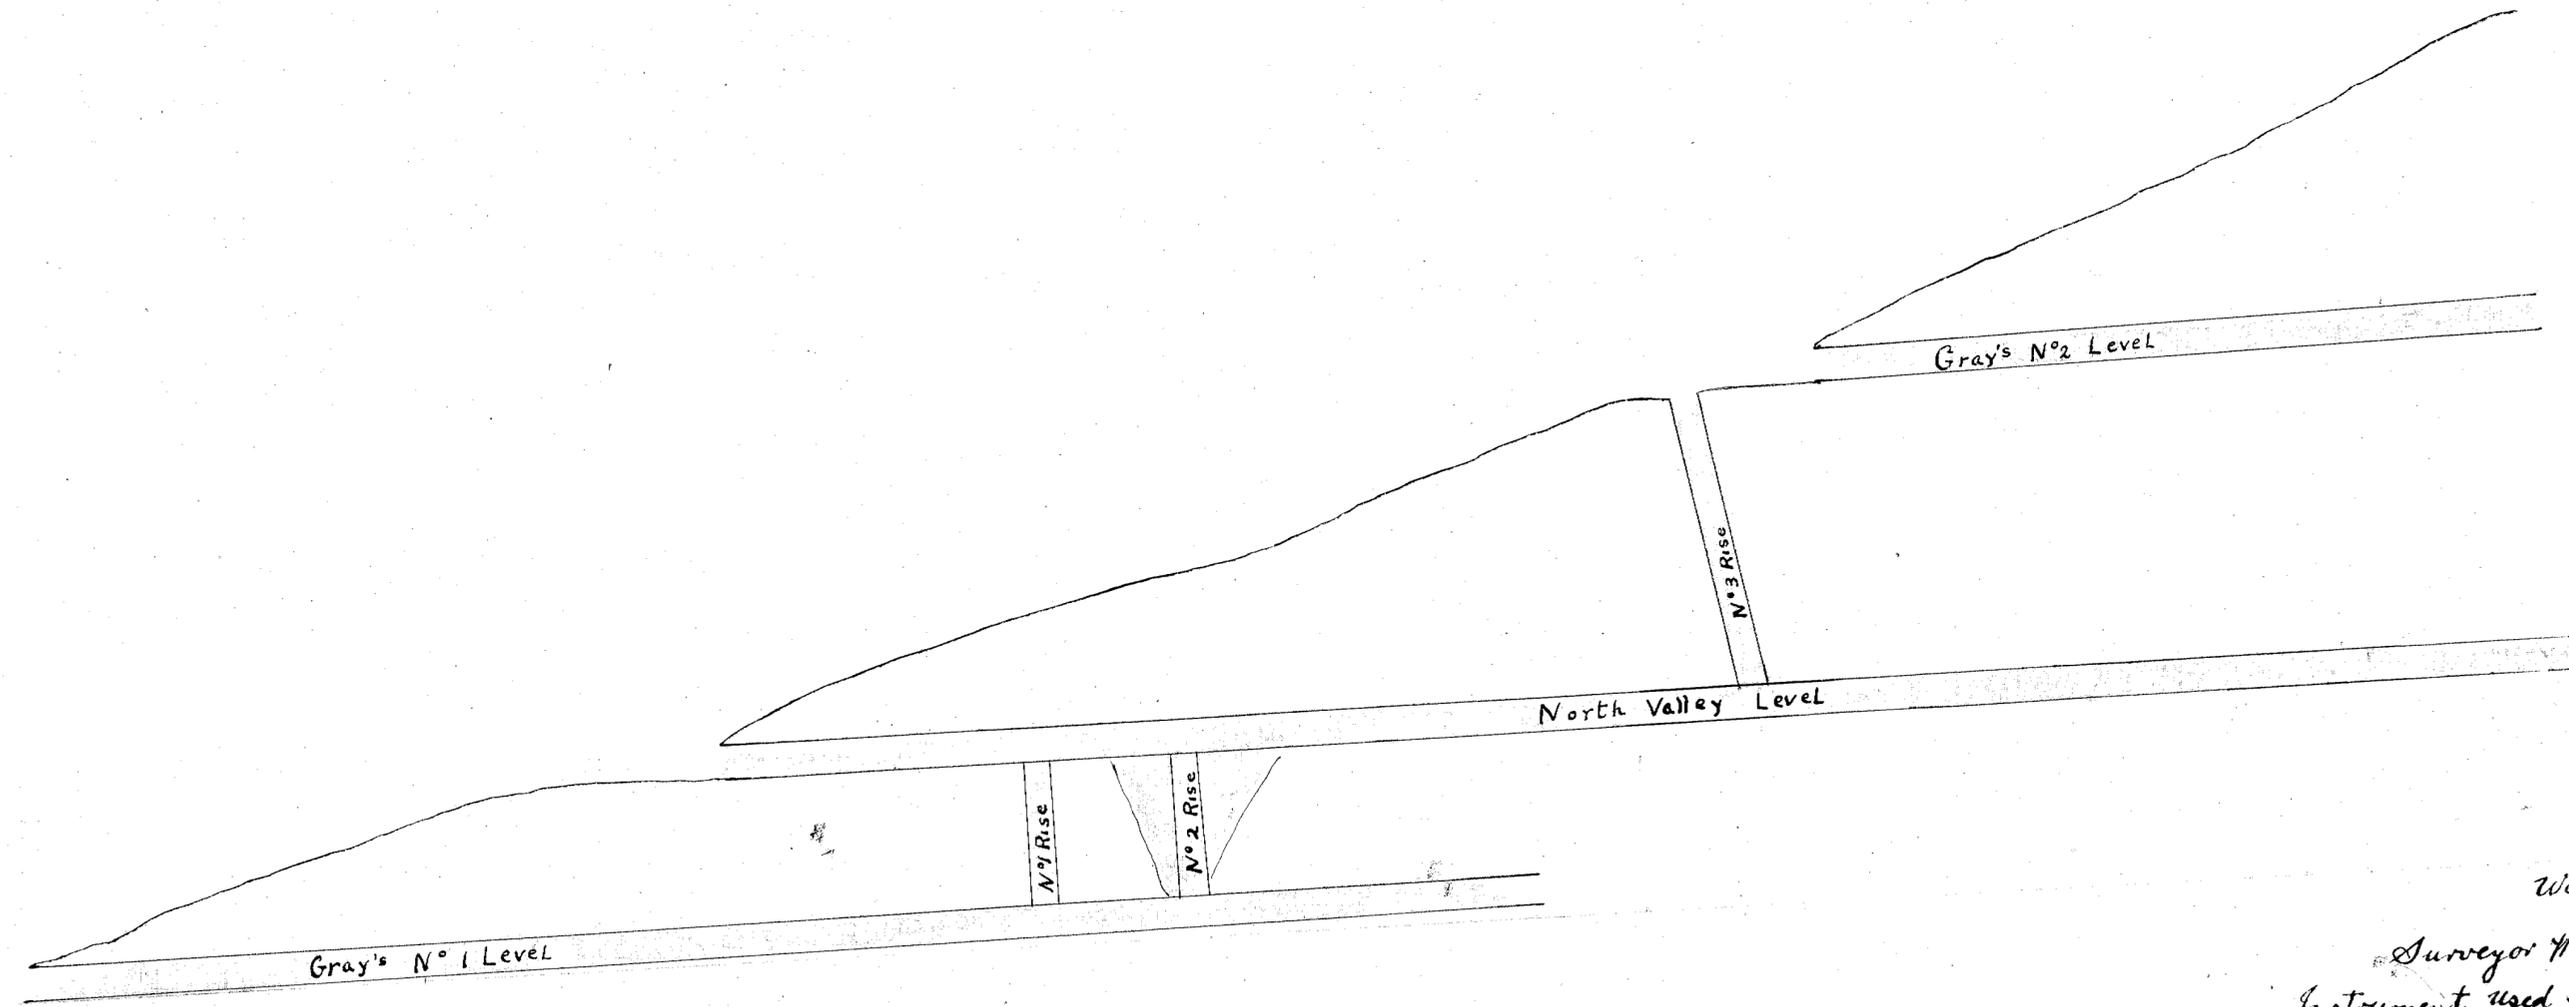

Work 1933

Surveyor W. H. Doherty  
Instrument used 5" Theodolite