

— THE M^T BISCHOFF T. M. COY. REG —

— NORTH WEST LODGE —



217-21

— LONGITUDINAL SECTION —


— SCALE 25 FT TO 1 INCH —

5 cm

217-21

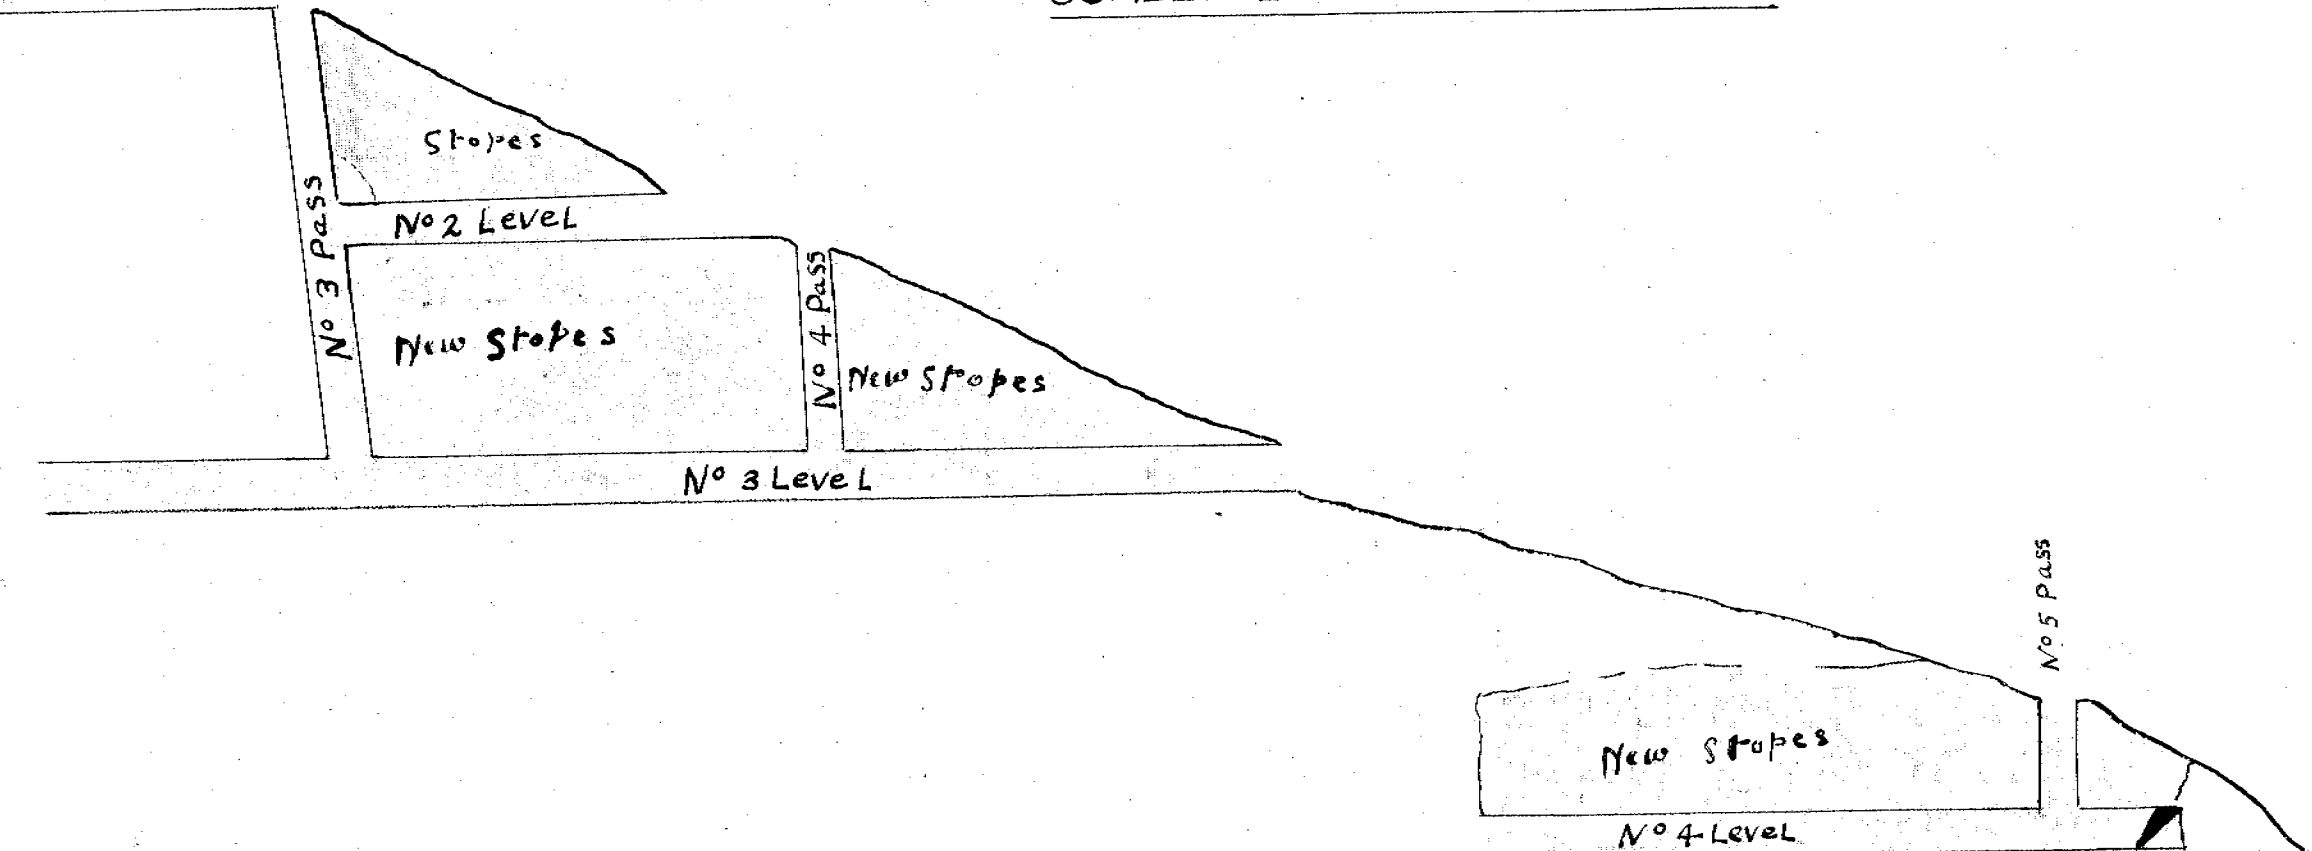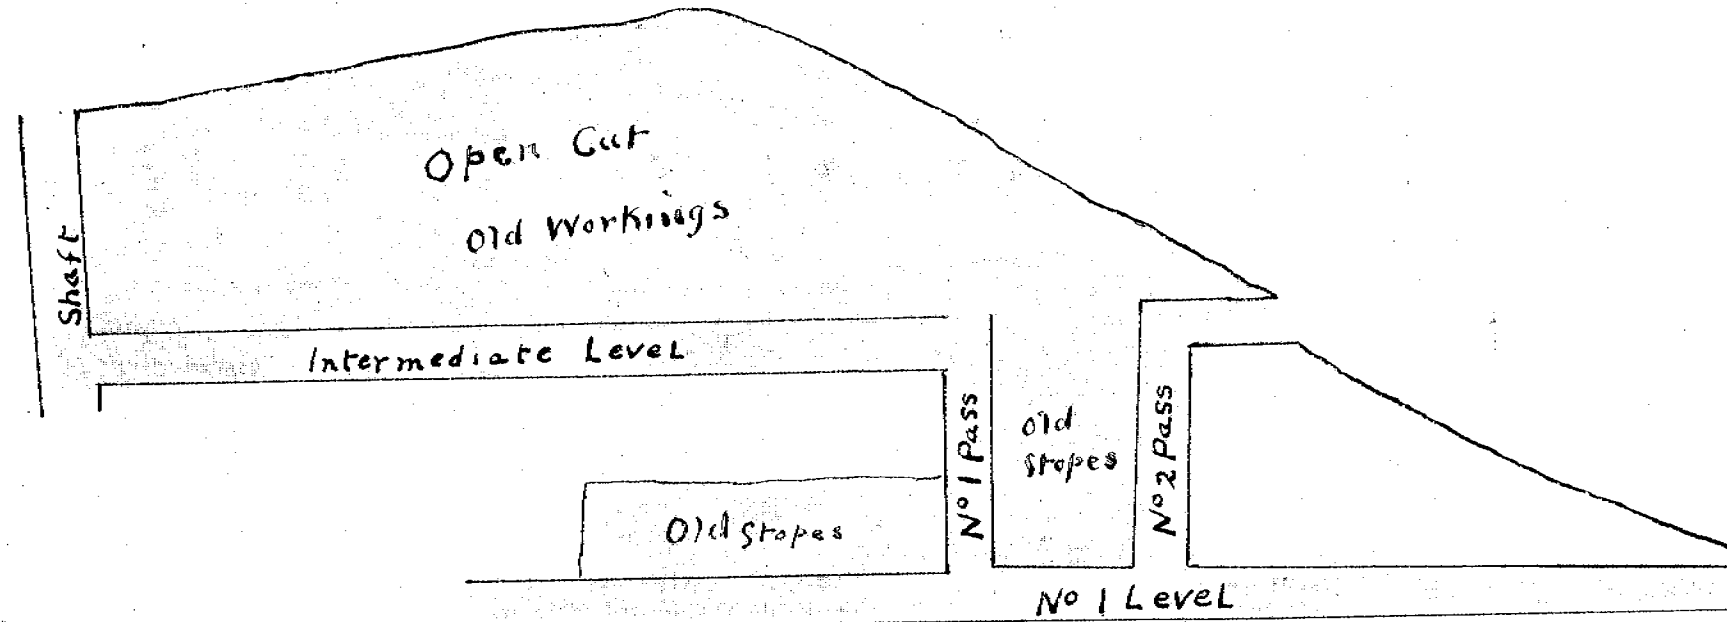

Work 1933
Surveyor W. H. D. R.
Instrument used 5" theodolite

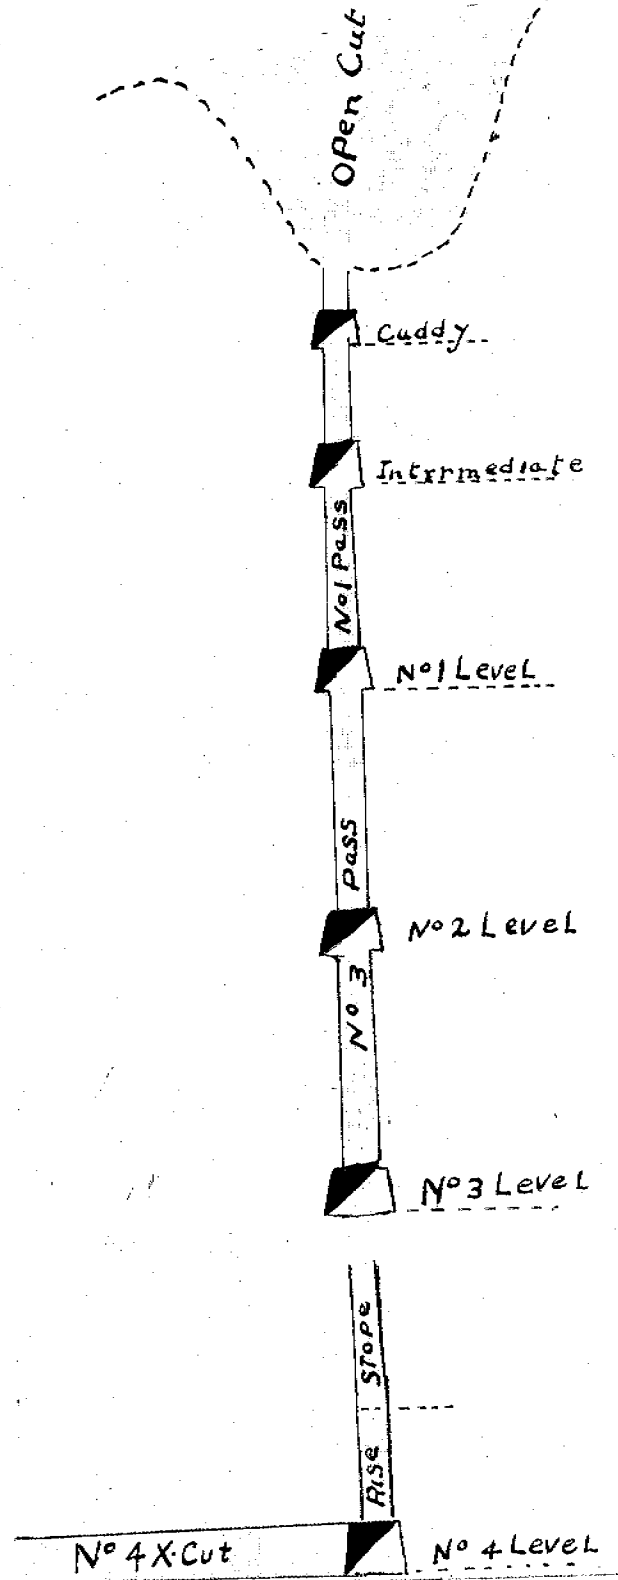

TRANSVERSE SECTION