

217-23


5 cm

MT BISCHOFF T M CO REG


NORTH WEST LODE

Scale 2.5 ft = 1 Inch

217-23

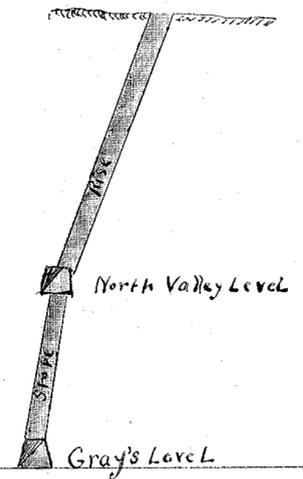

Transverse Section

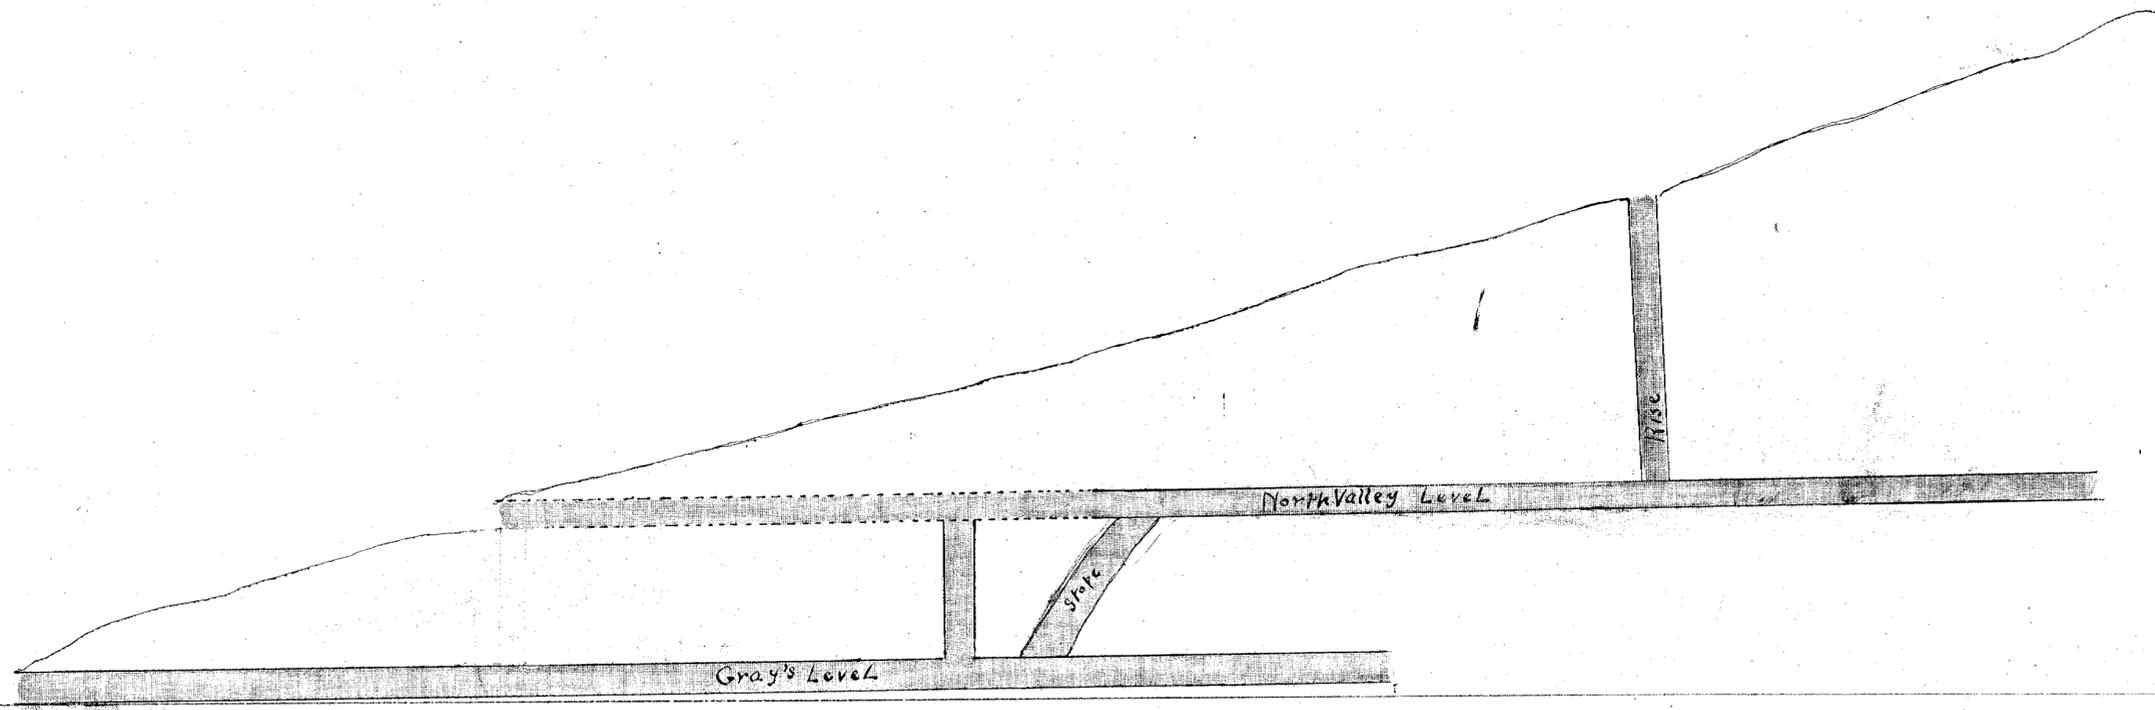

Longitudinal Section

Work 1932
Survey on Mt. Porter
Inst. used 4" theod
10/4/33

24/7/33