

217-24


5 cm

— MT BISCHOFF T M CO REG —

— NORTH WEST LODE —

— TRANSVERSE SECTION —

— Scale: 25 Ft to 1 Inch —

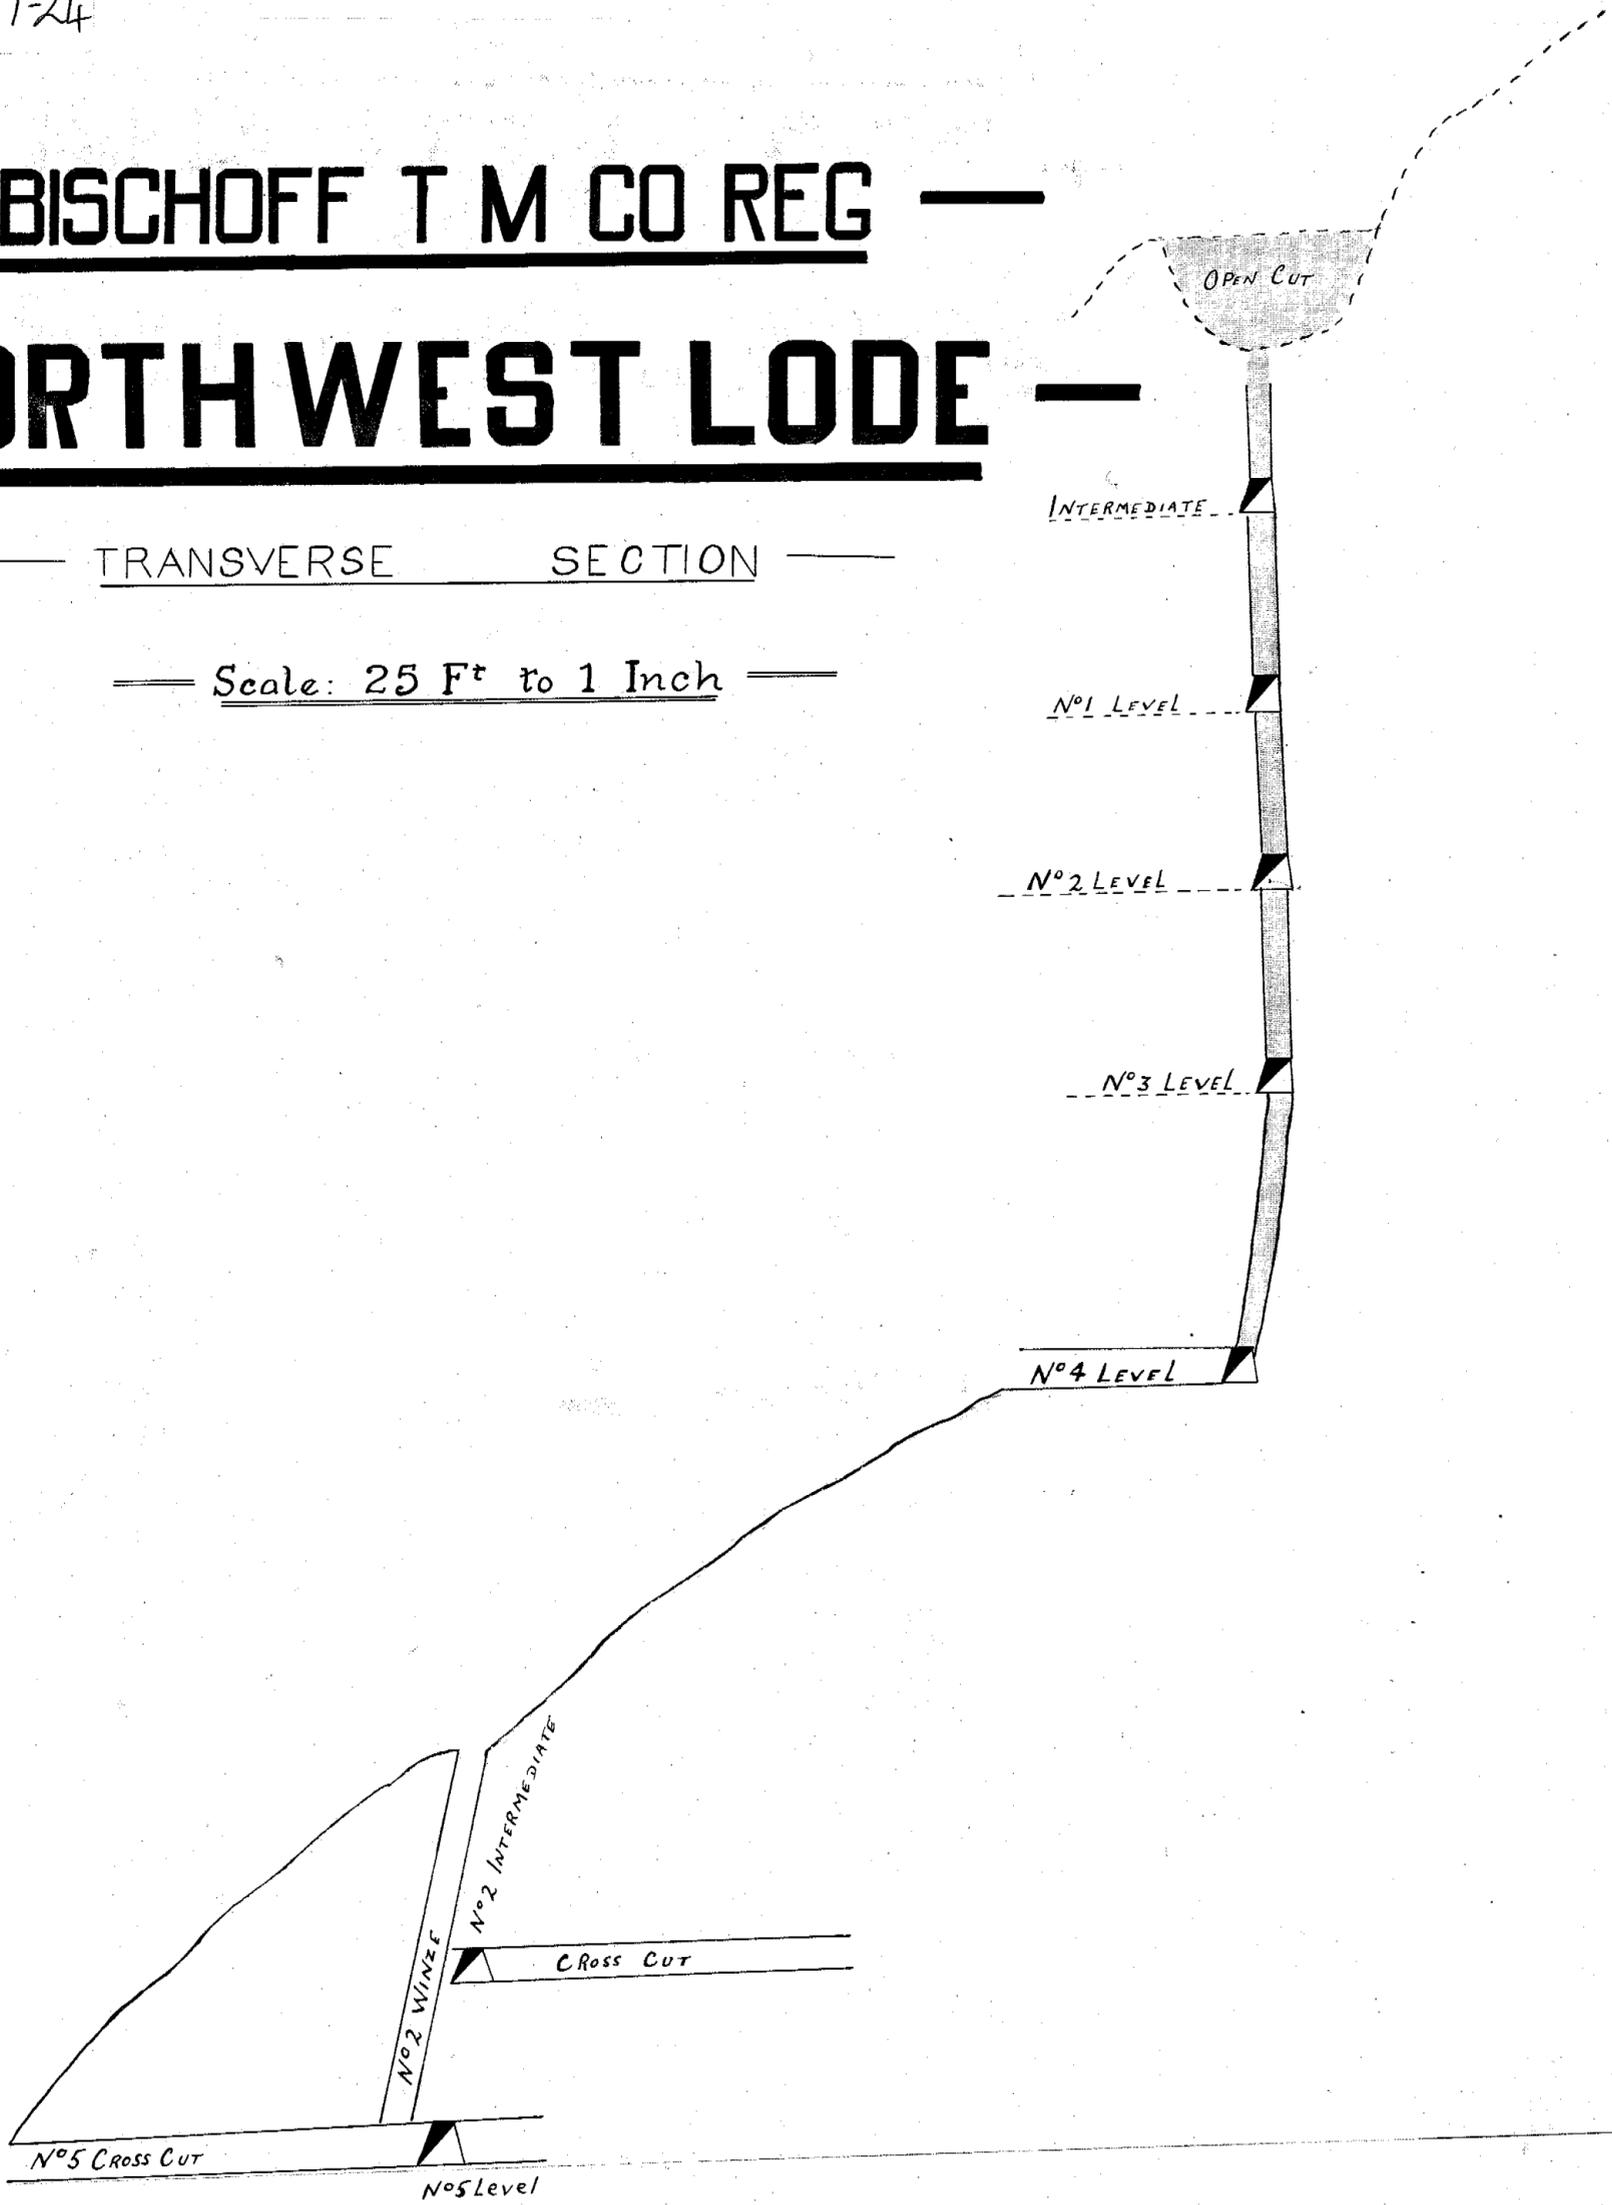

Work 1934
 Surveyor M. D. Dole
 Just used 5" thread and compass