


217-25

217-25

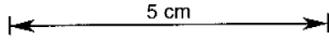


# MT BISCHOFF T.M.CO.REG.

# NORTH WEST LODE

TRANSVERSE SECTION

SCALE 25 FT TO 1 INCH

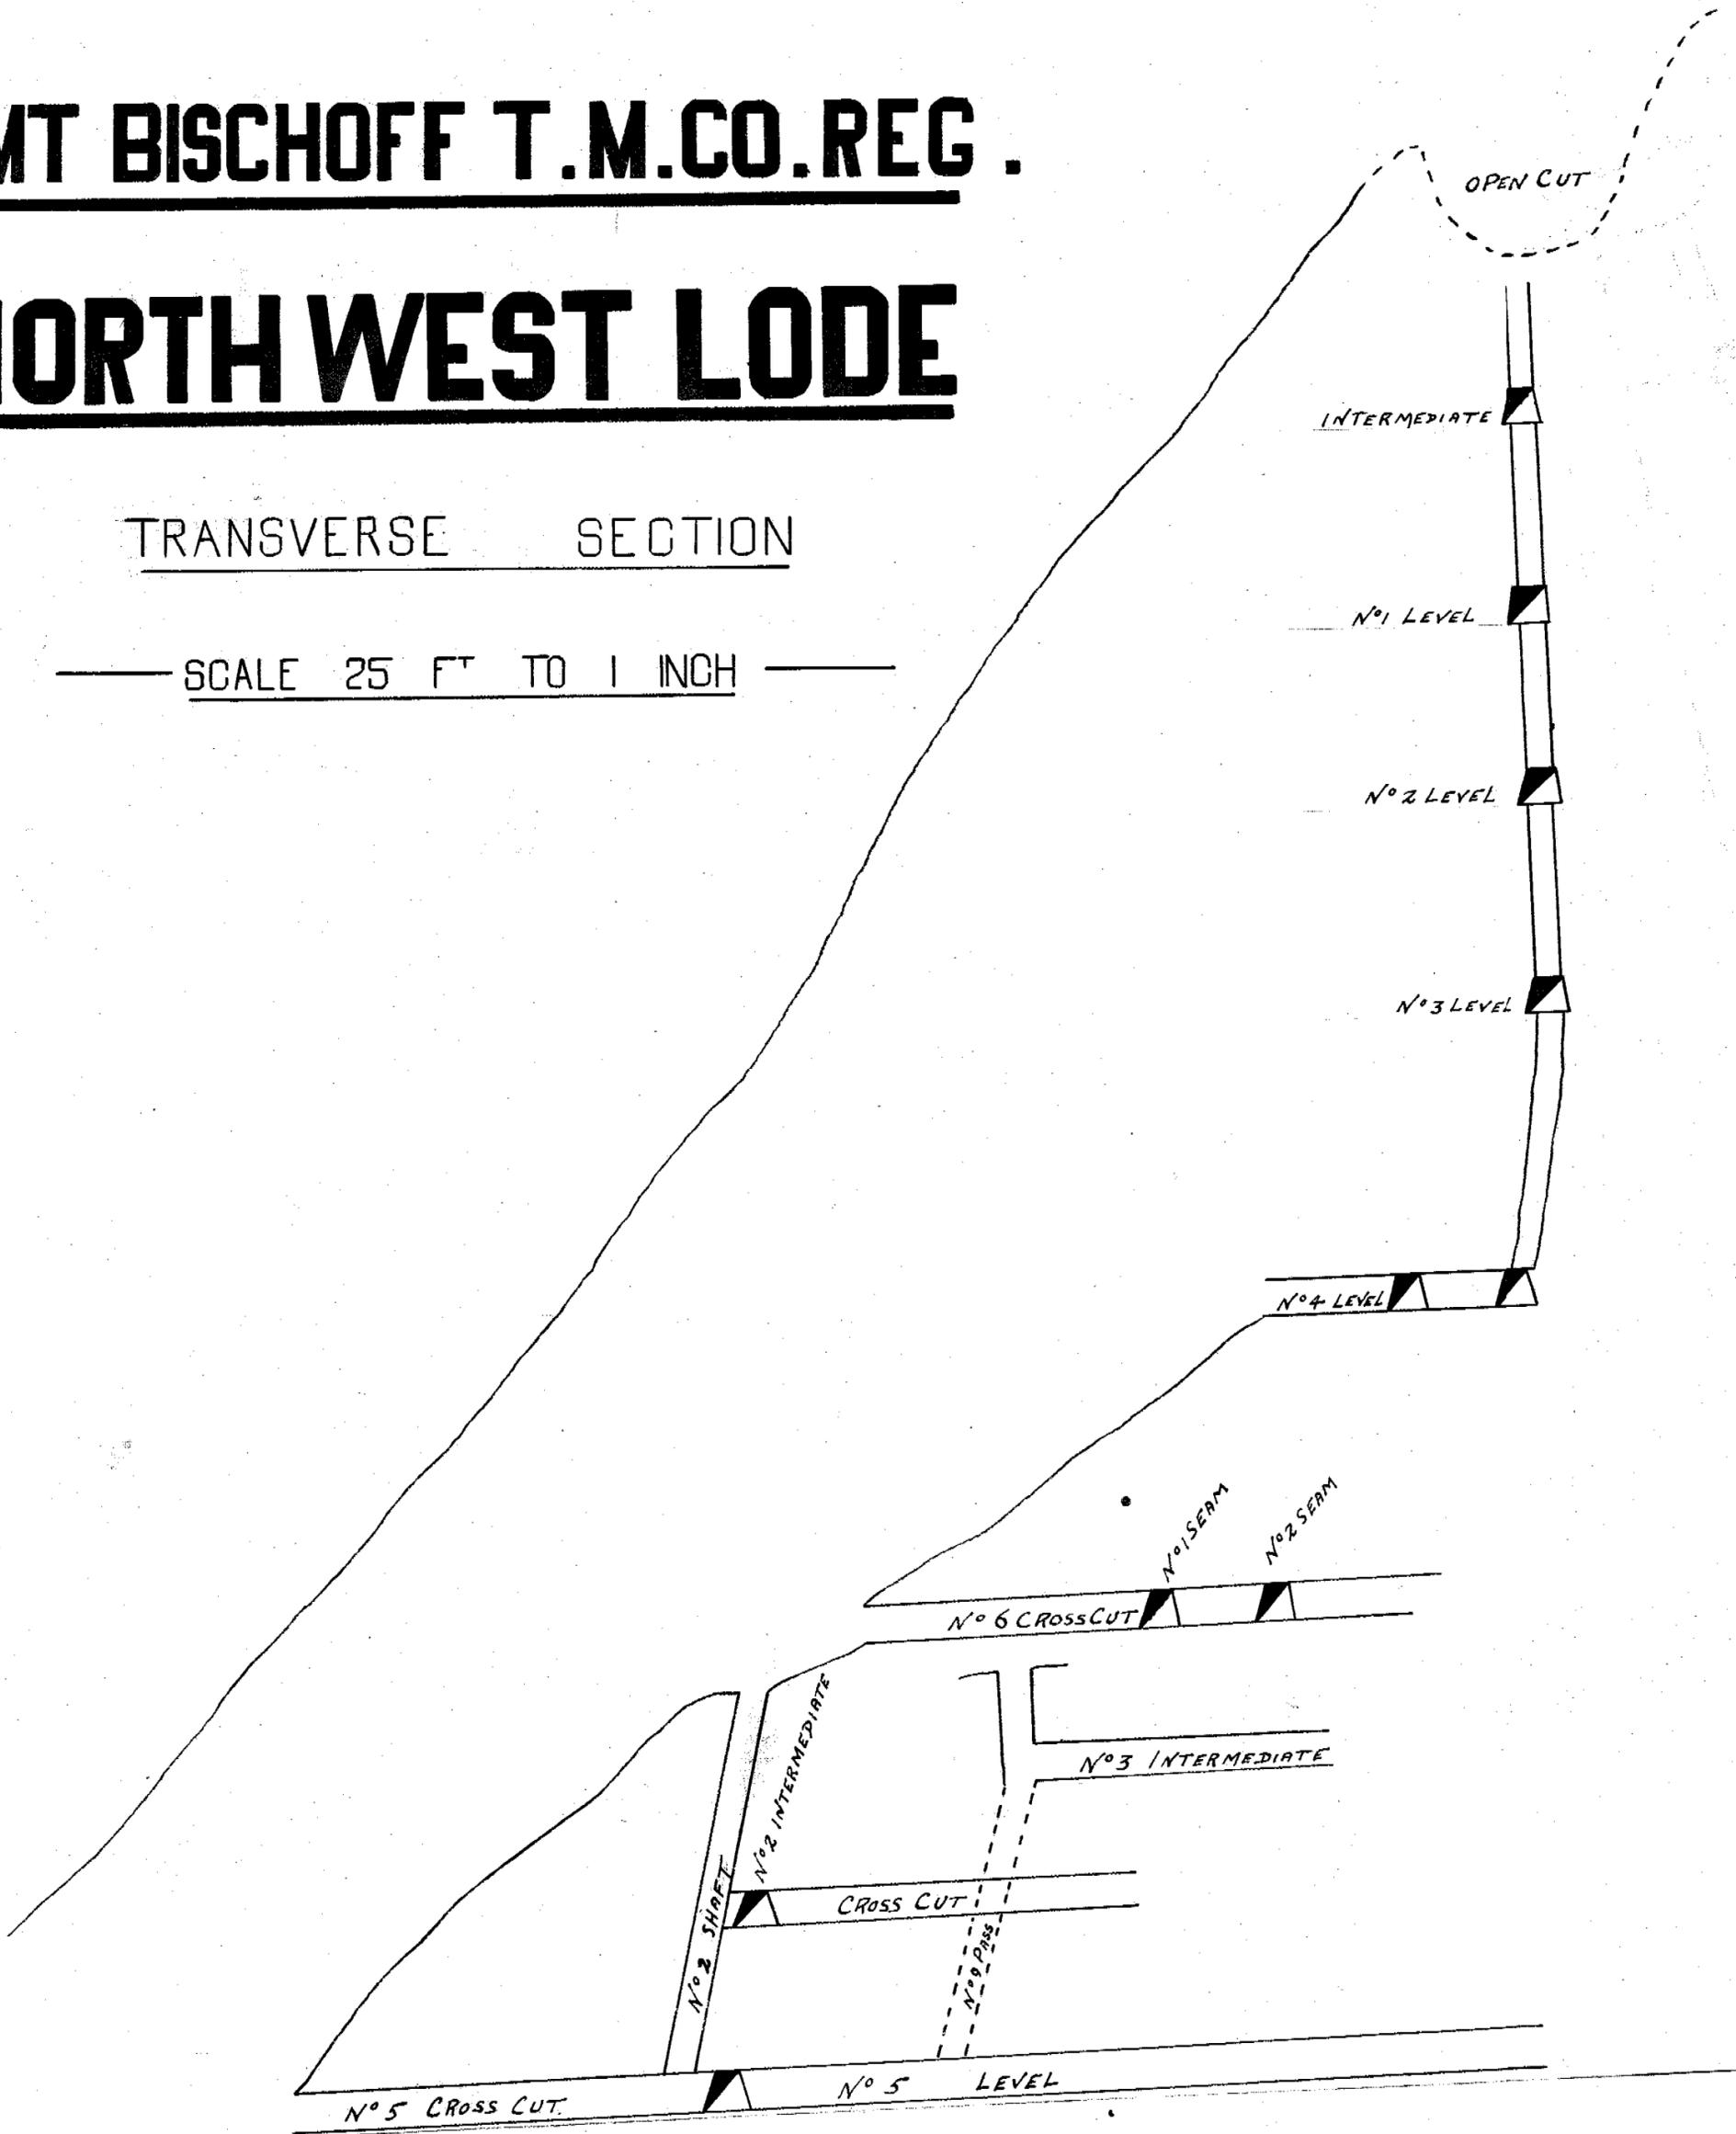

Work 1935  
Surveyor M. G. Dorte  
Just used 5° the dot is