
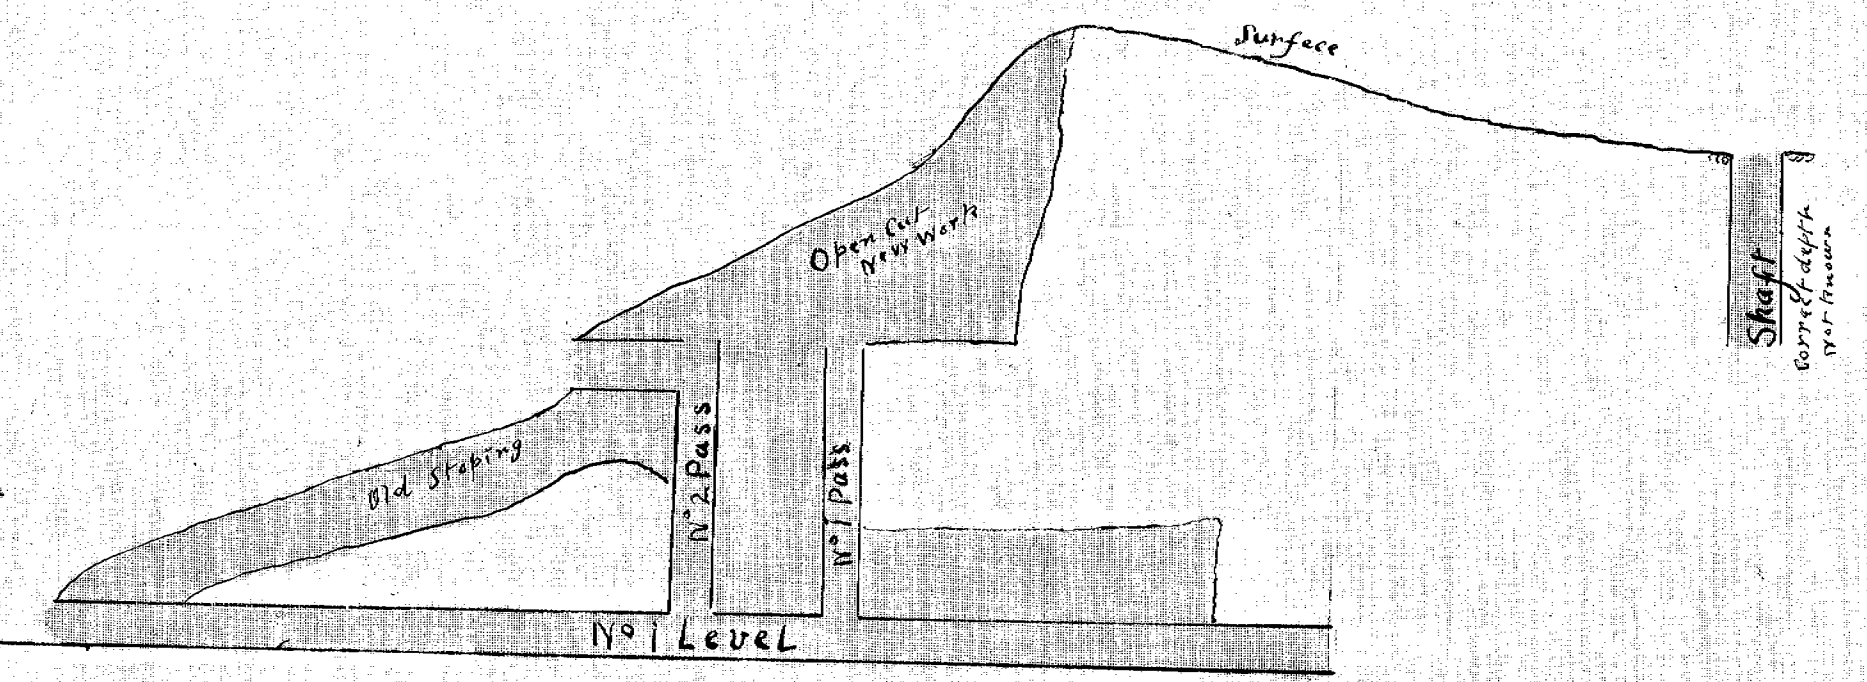
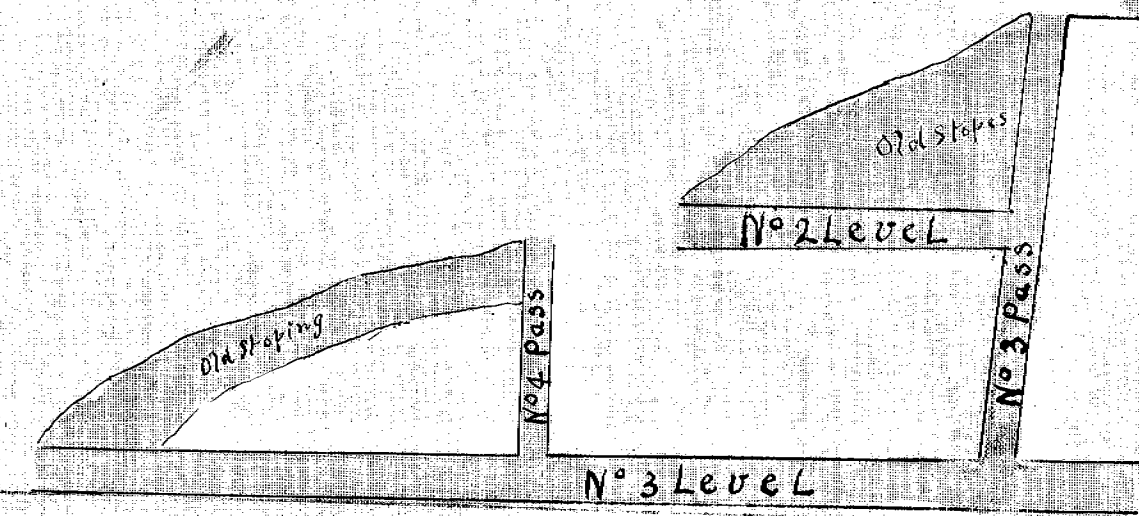


217-26

5 cm

217-26

Surveyor W. Pote
Inst used 4' theodolite
#13/32

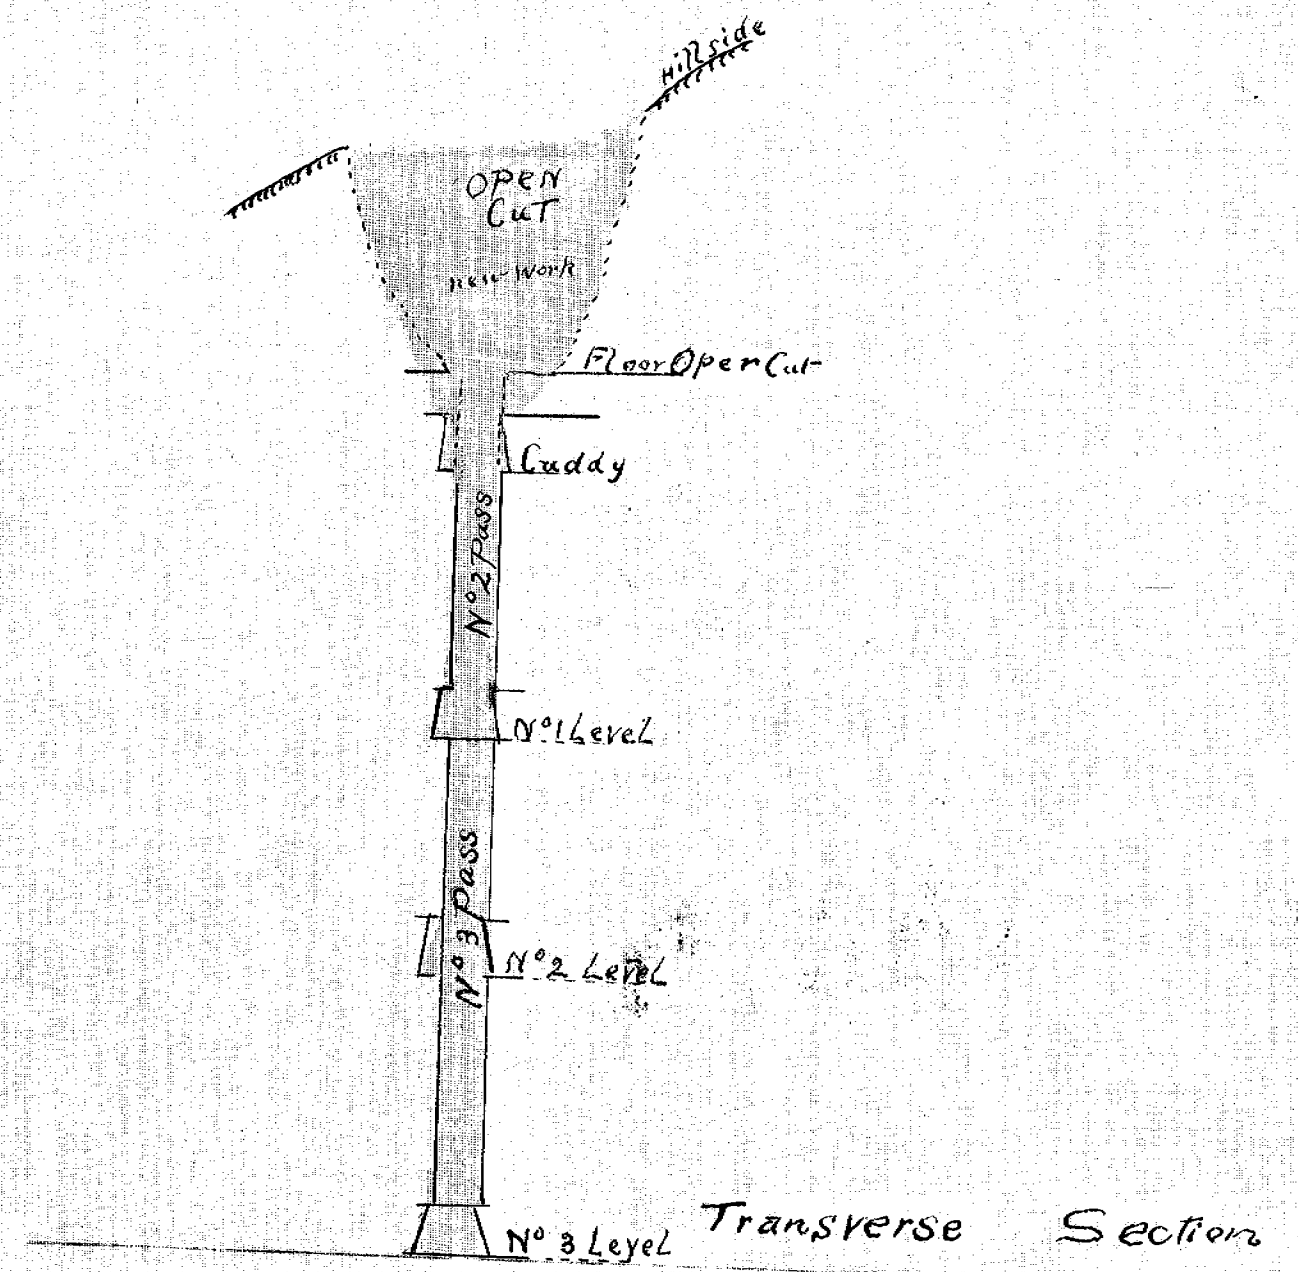

MT. BISCHOFF T.M CO REG.
NORTH WEST LODE
LONGITUDINAL SECTION
SCALE 25 FT = 1 in