

217-27


N.W.

— MT BISCHOFF T.M.CO.REG. —

— NORTH WEST LODE —

— LONGITUDINAL SECTION —

— SCALE 25 FT TO 1 INCH —

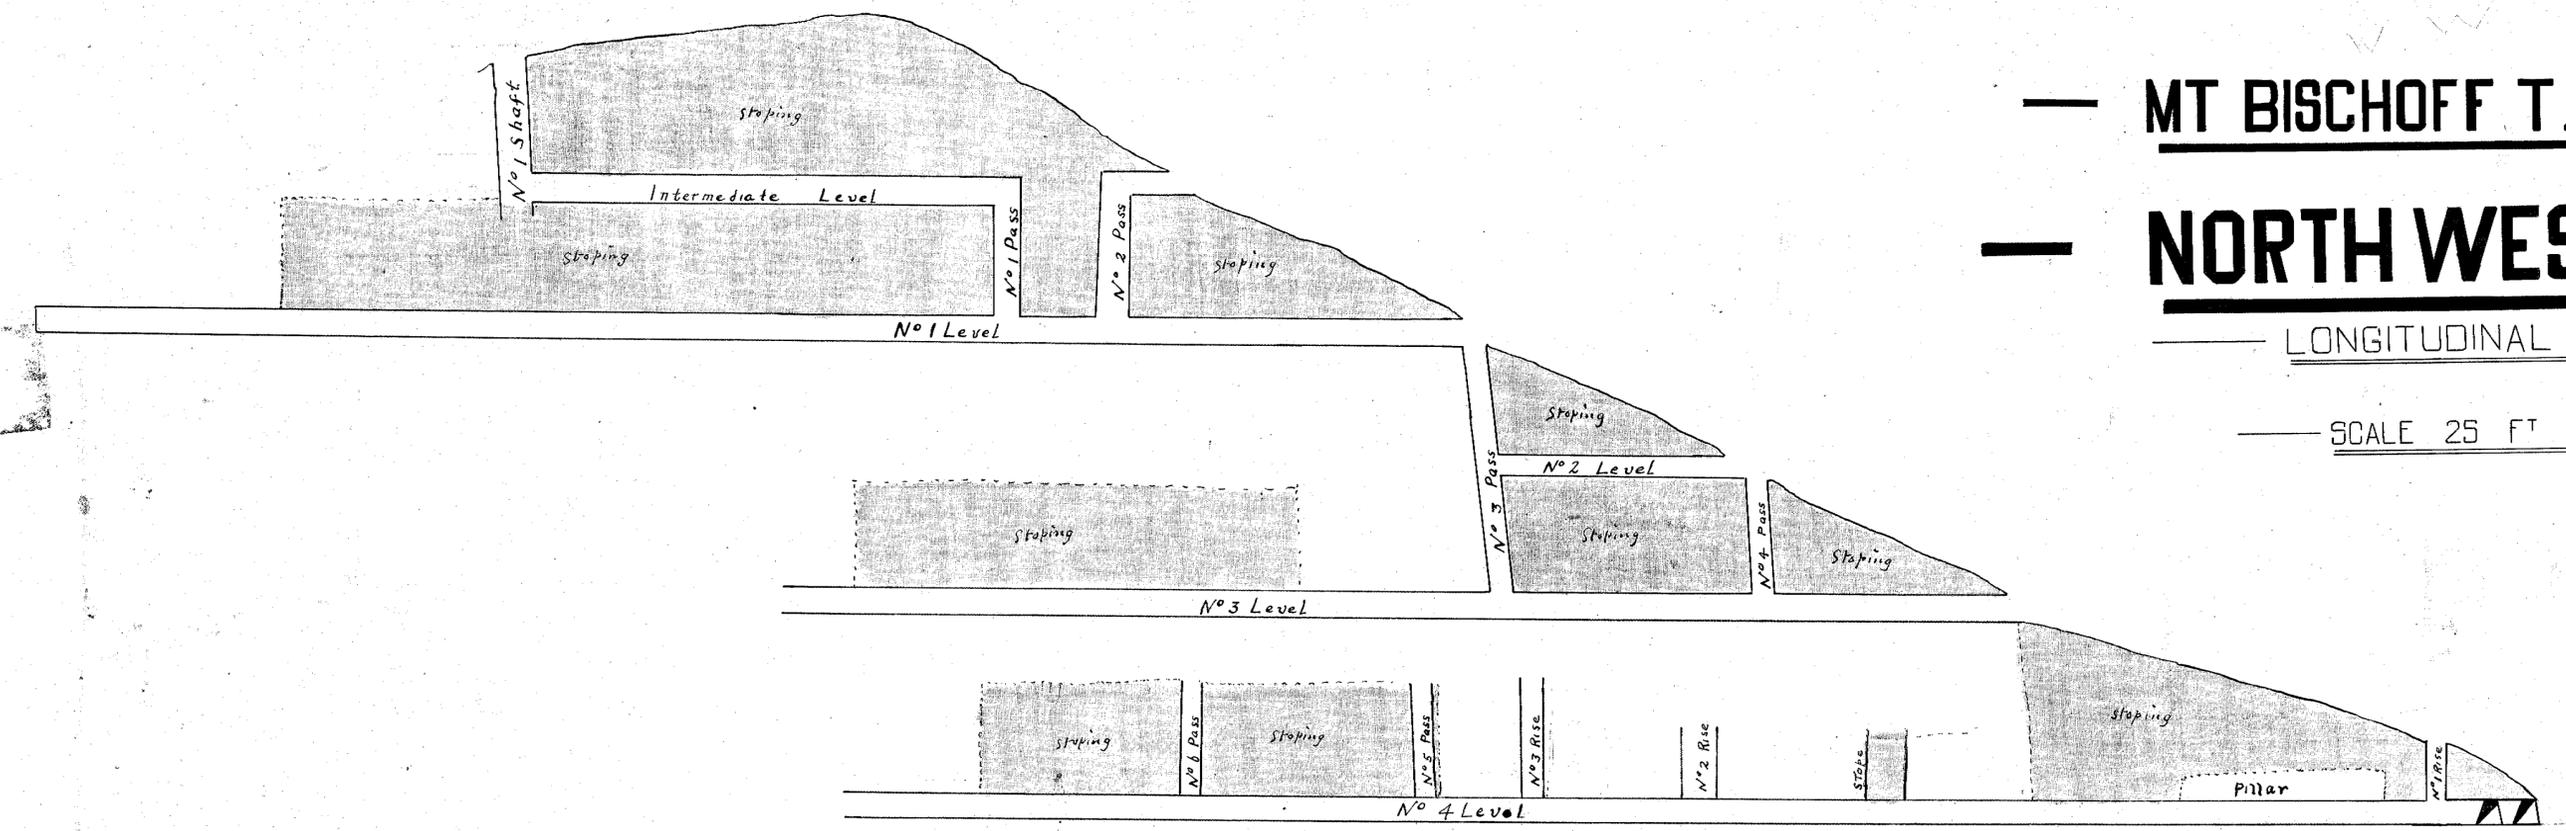

5 cm

217-27

Mar 1934
Surveyor W. P. ...
not used 5" Head and Compass

No 5 Level

