



217-28

# MT BISCHOFF T.M.CO.REG.

# NORTH WEST LODE

TRANSVERSE SECTION

SCALE 25 FT TO 1 INCH

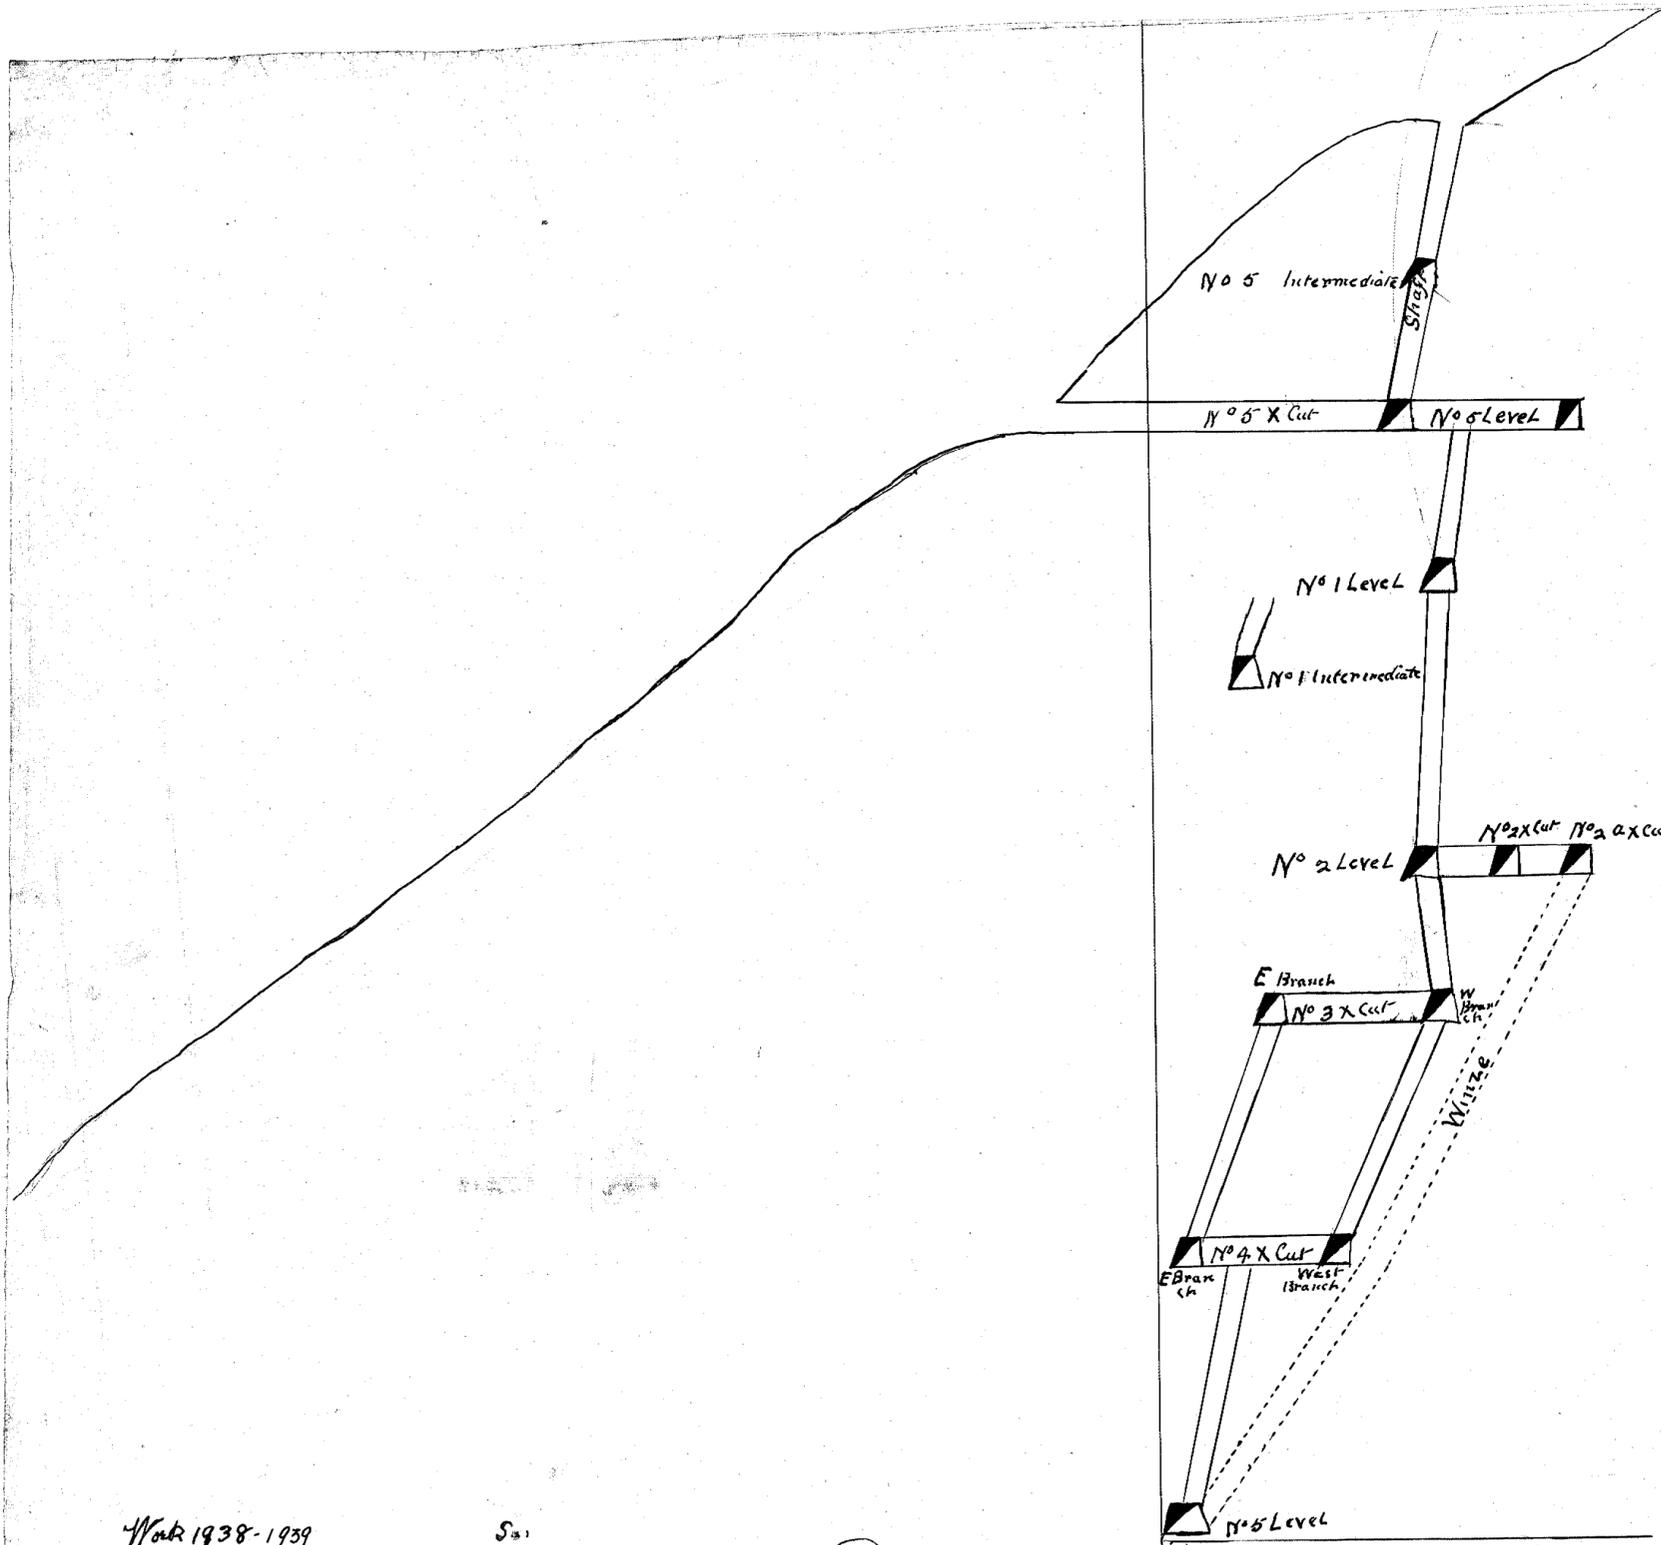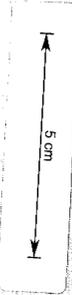

Work 1938-1939  
Surveyor W.H. Davis  
Inst and 5" theodolite  
Surveyor 1939 A.I. Pote

S.S.  
Surveyor 1940 W.H. Davis  
Inst and 5" theodolite

217-28