

5 cm


217-29

— THE M^r BISCHOFF T. M. COY. REG —

— NORTH WEST LODE —

SCALE: 25 F'TO 1 INCH

Ex d
OF
25/1/34

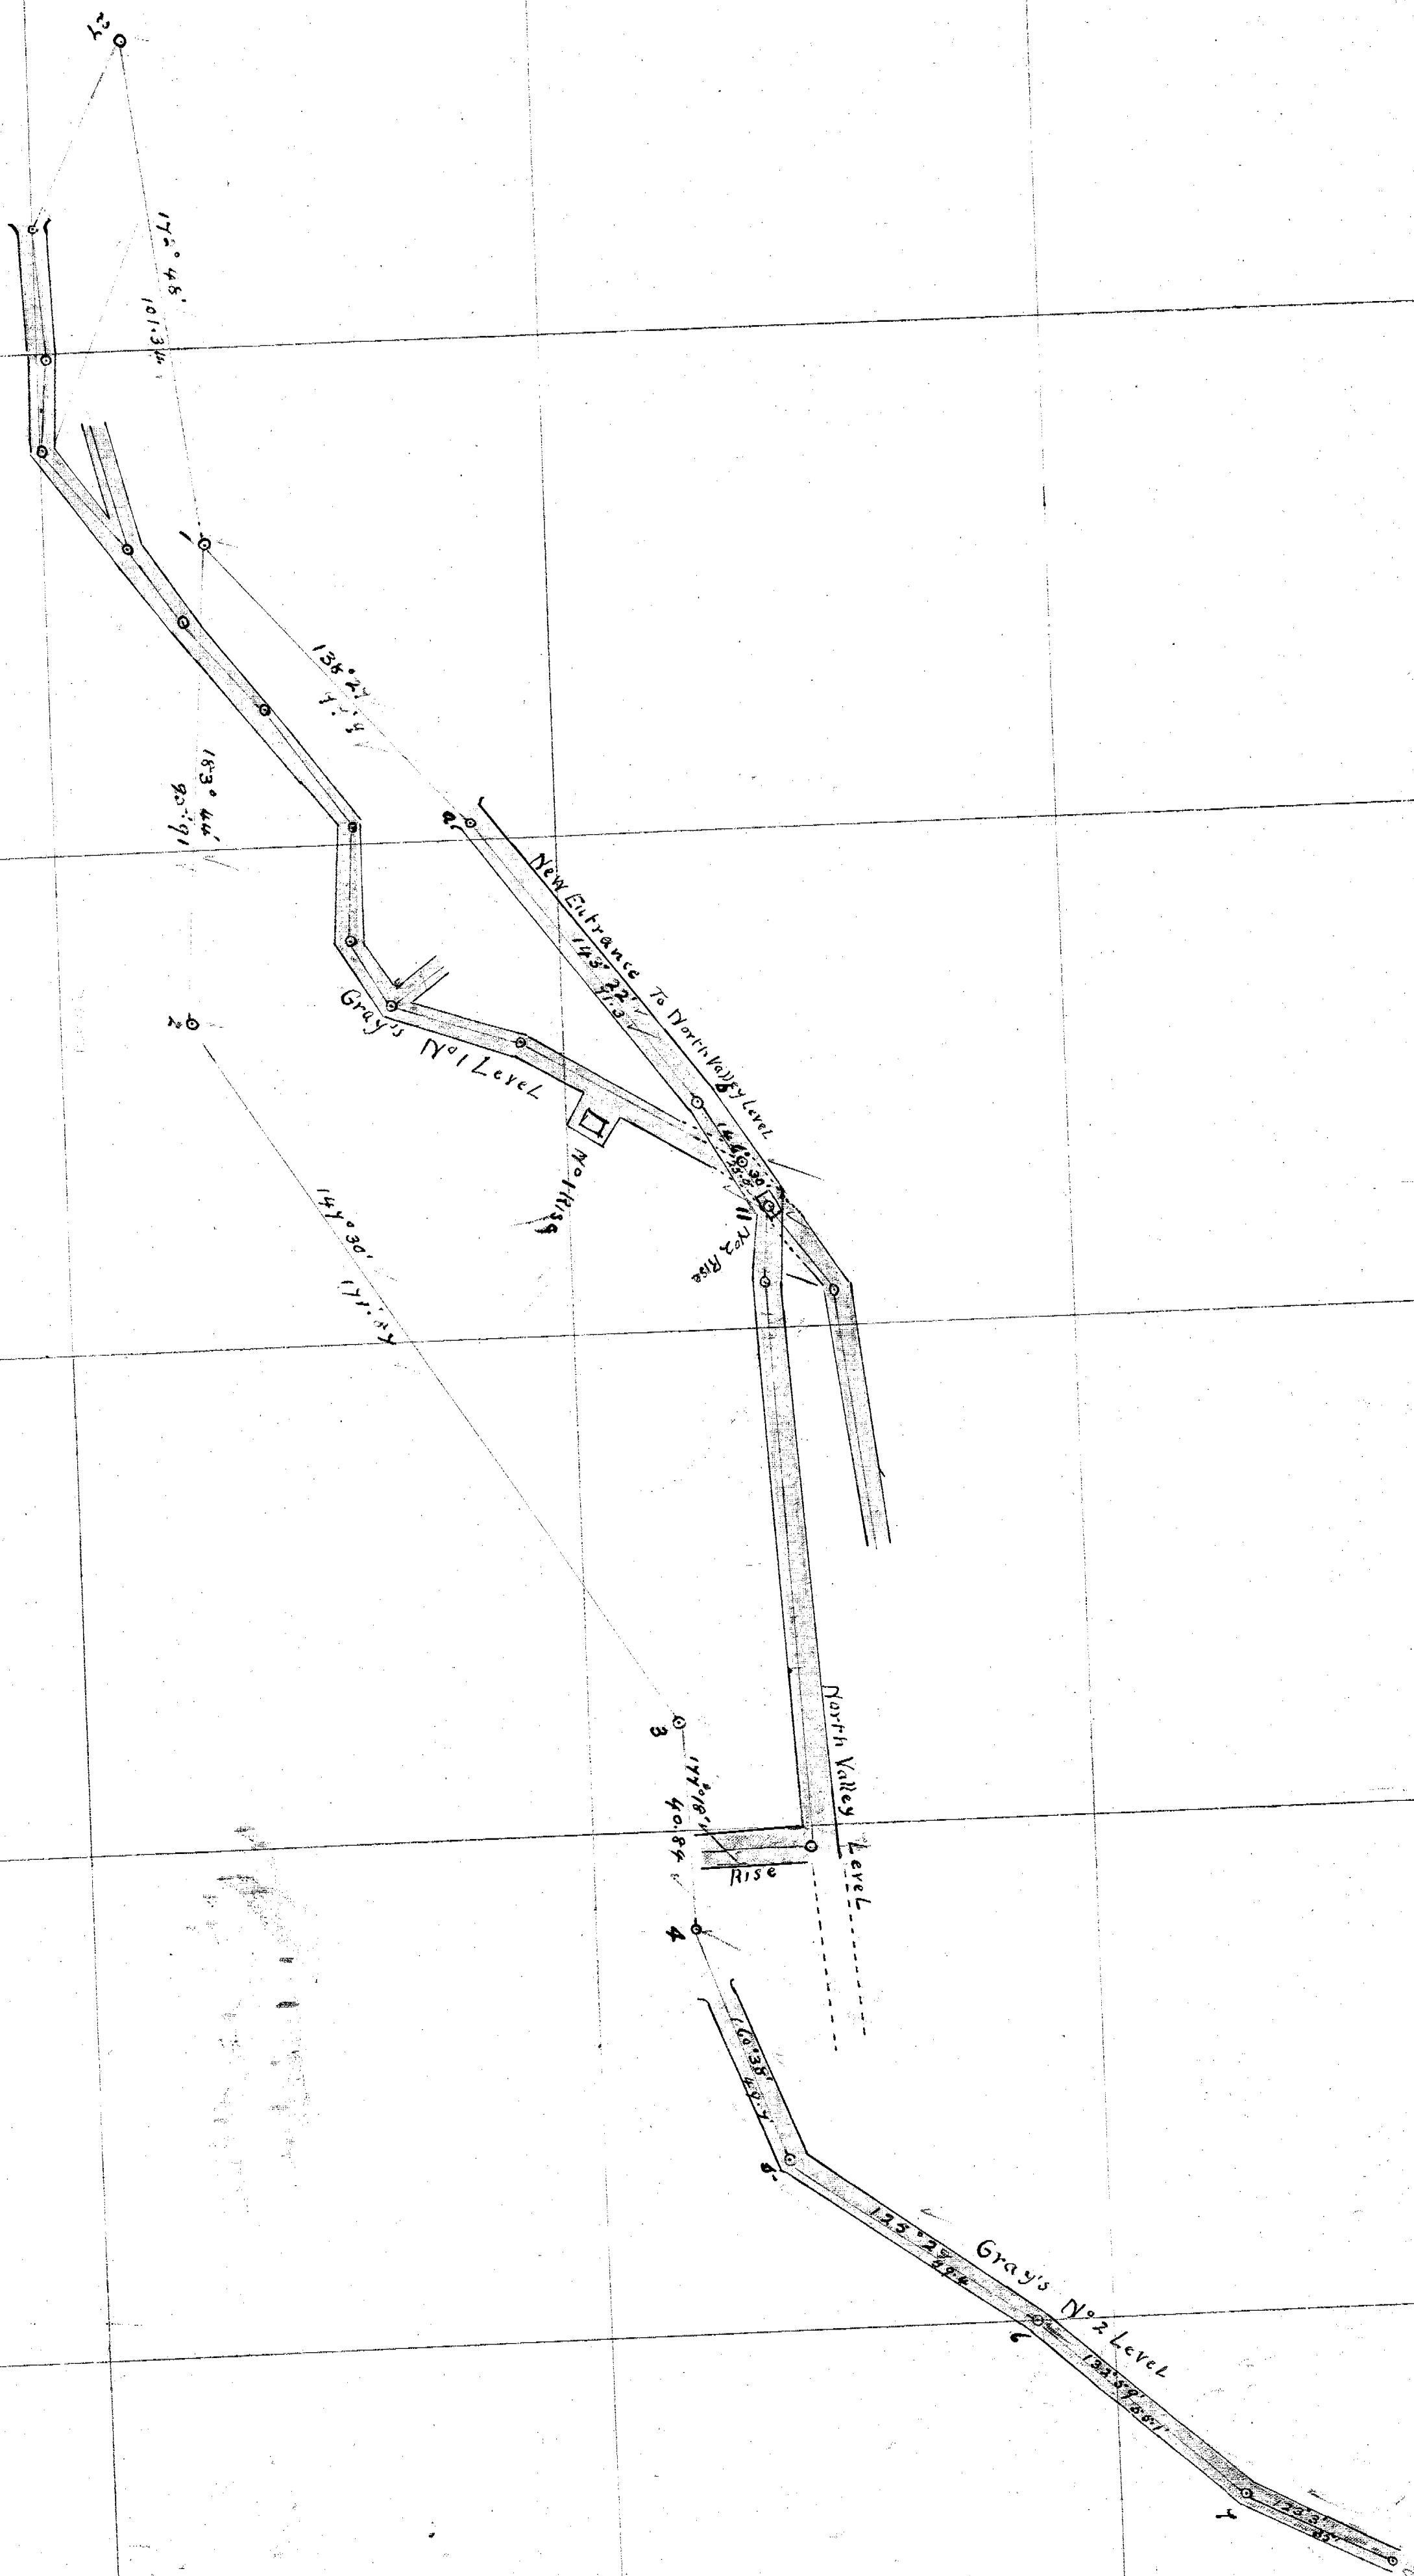

Work 1933
Surveyor H. H. Pelt
Instrument used 5" theodolite