


217-31

5 cm

- NORTH WEST LODGE -

— SCALE: 25 F^T TO 1 INCH —

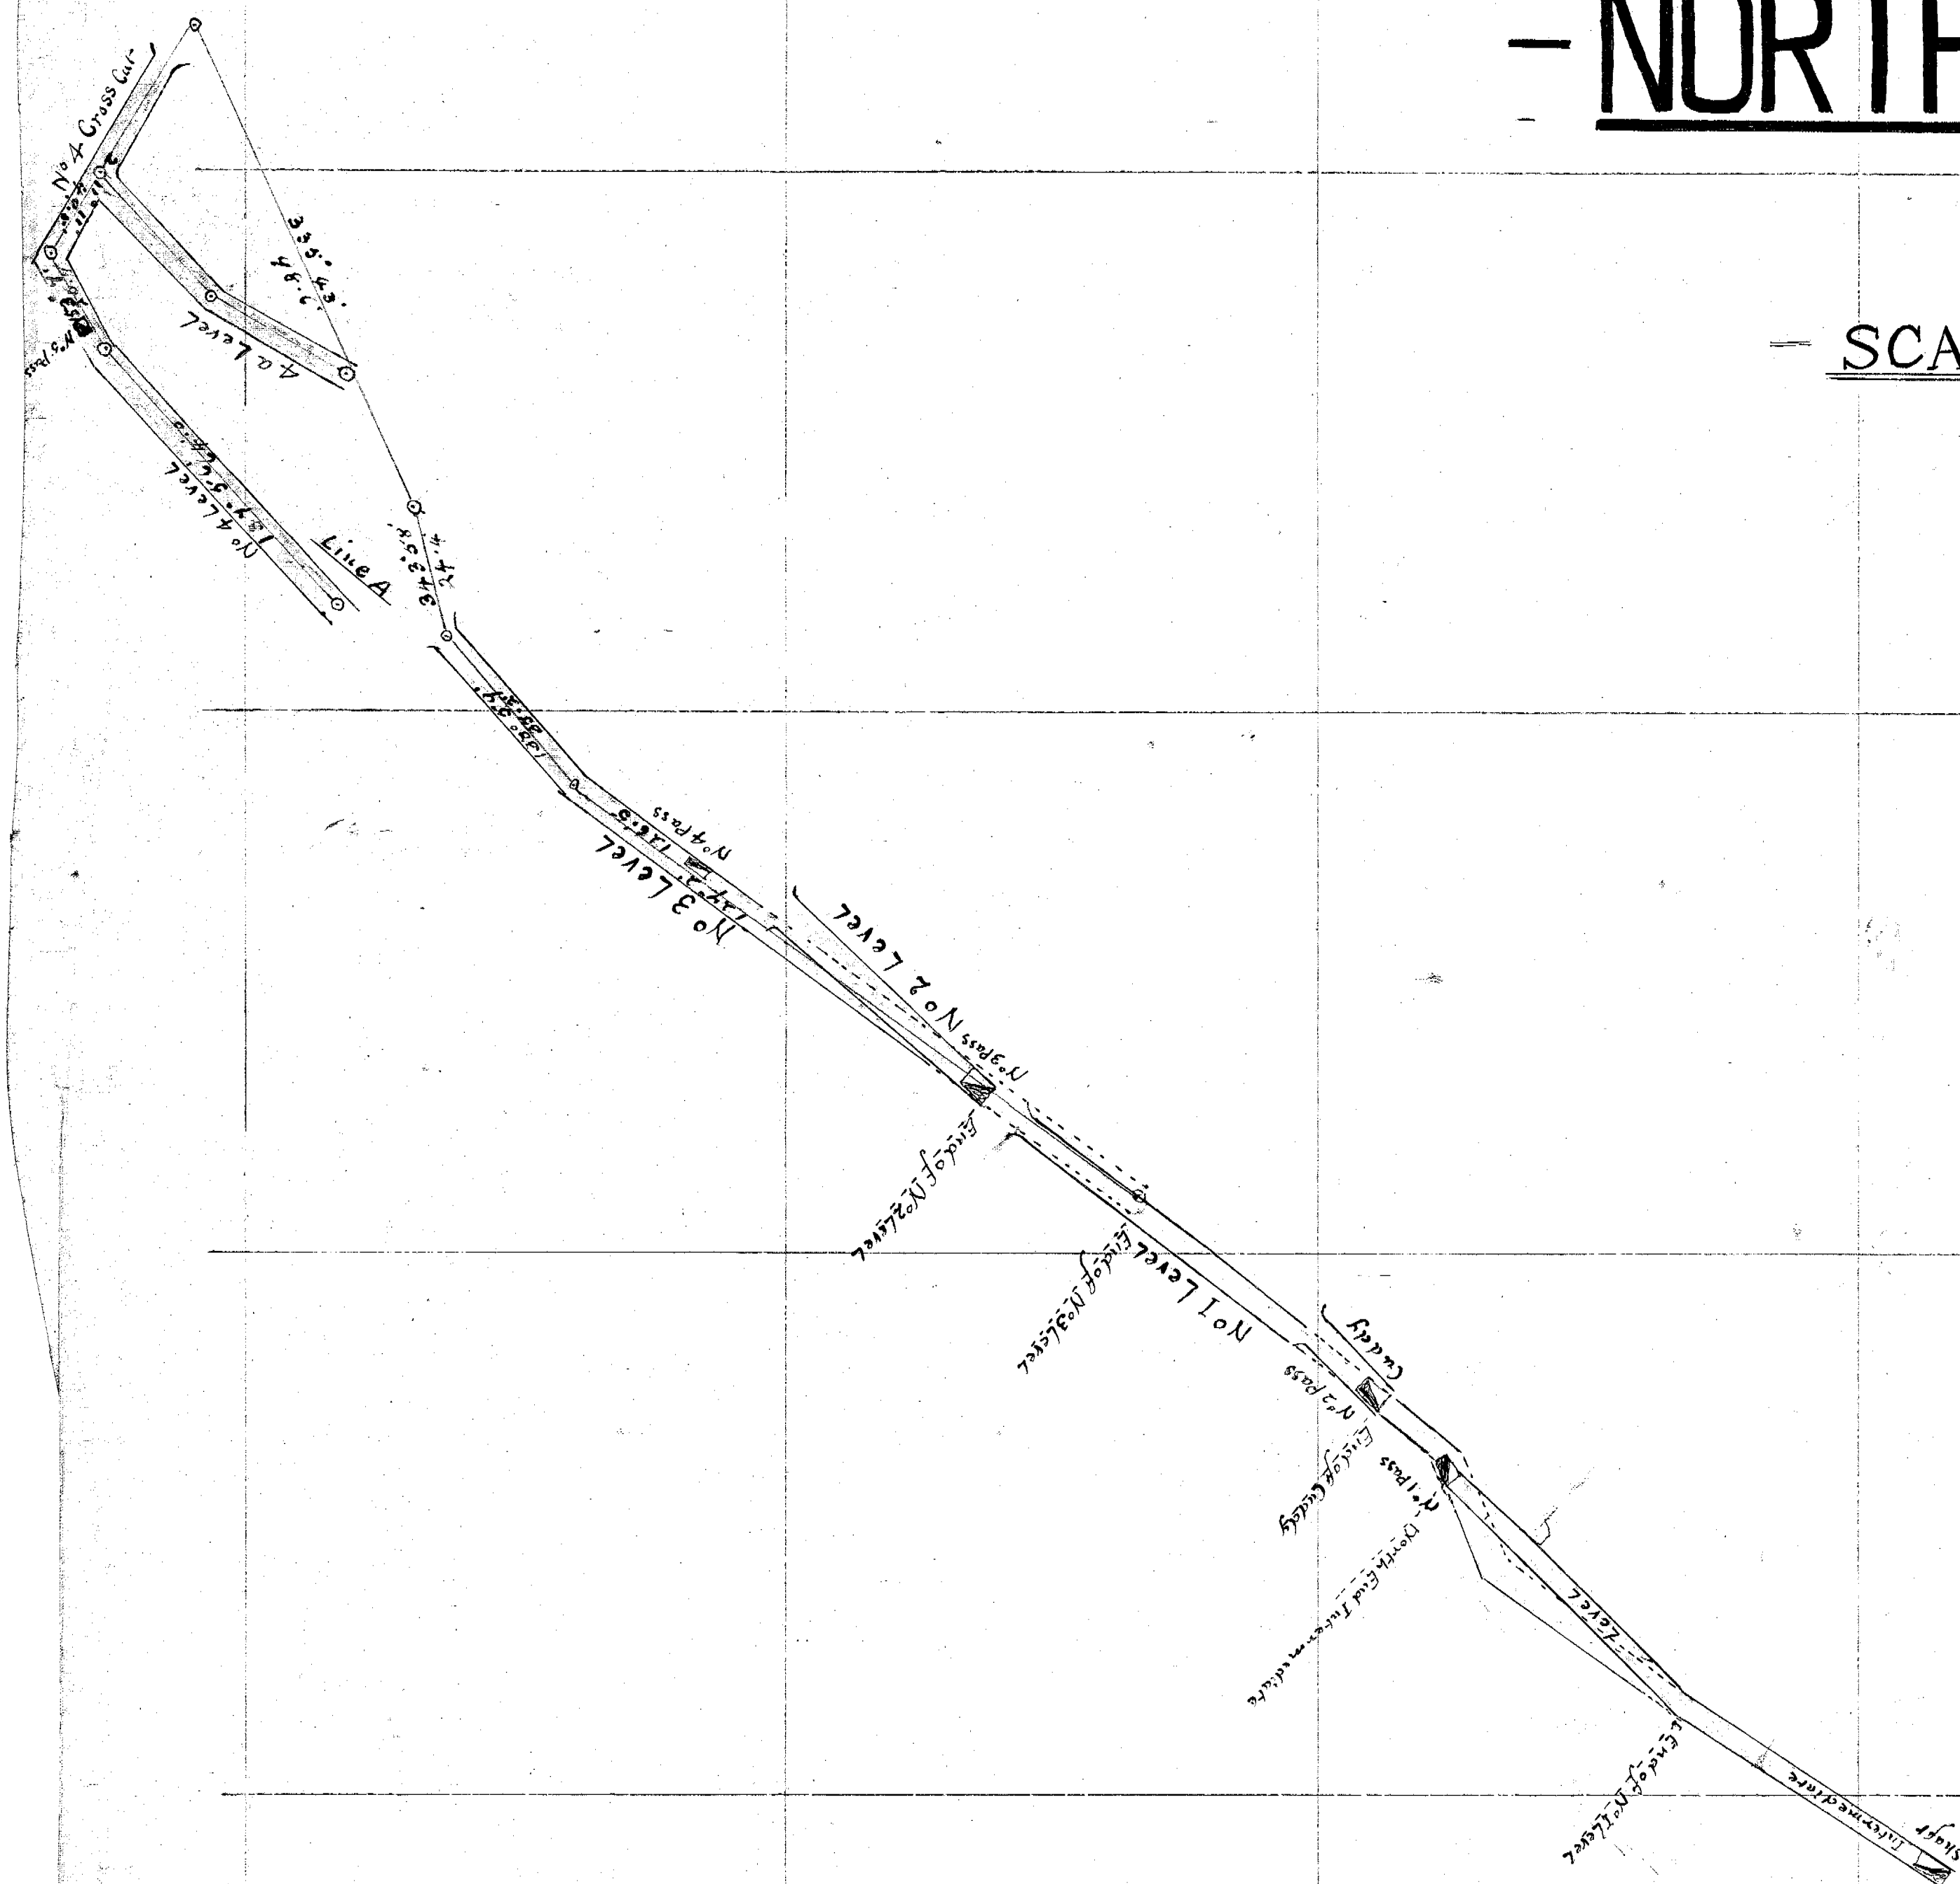

Line 5

1100 W

Moore

7000

800 W

700w