


5 cm


217-32

THE M^T BISCHOFF T. M. COY REG NORTH WEST LODGE-

Scale 25 ft = 1 Inch

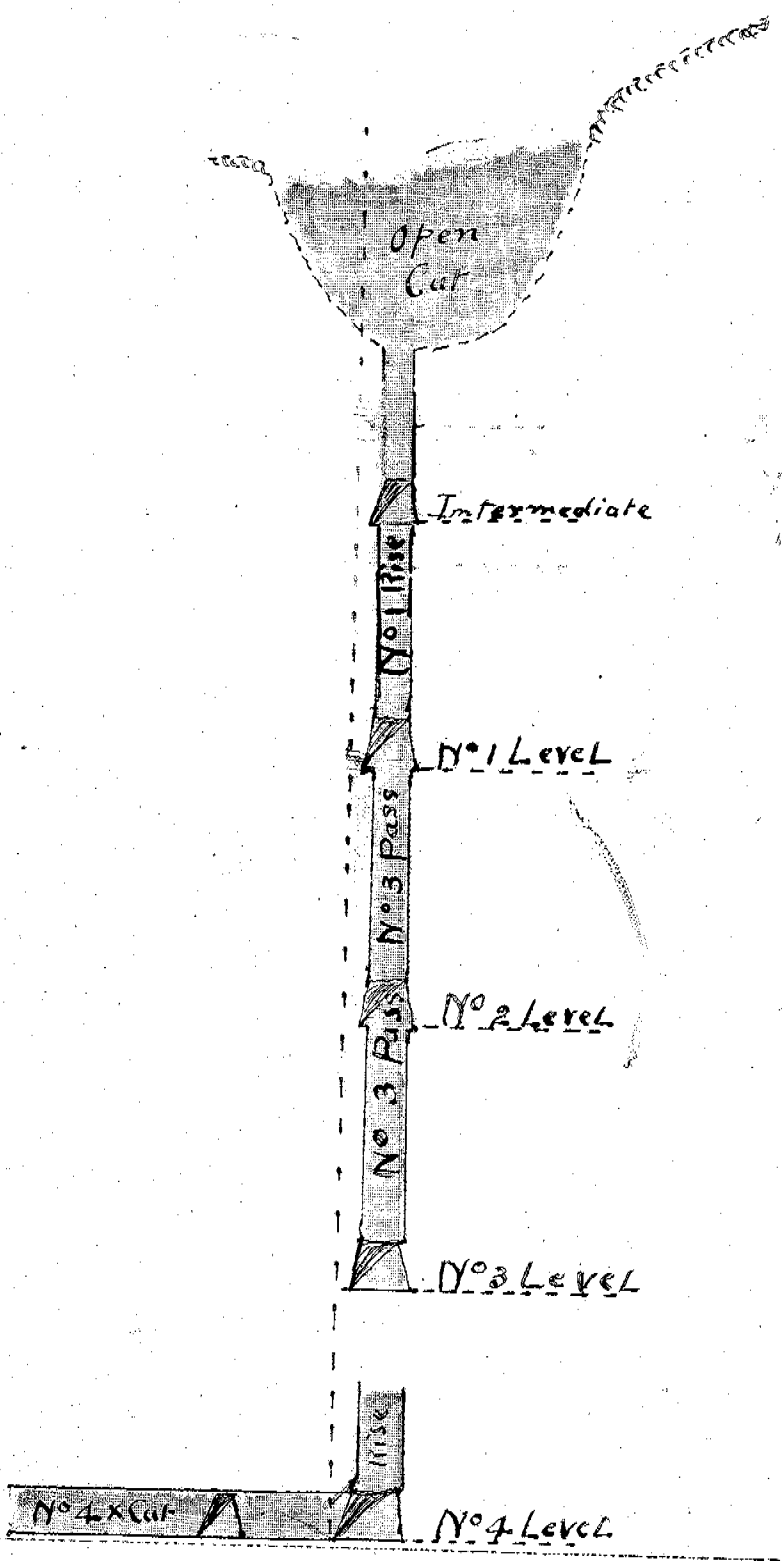

Transverse Section

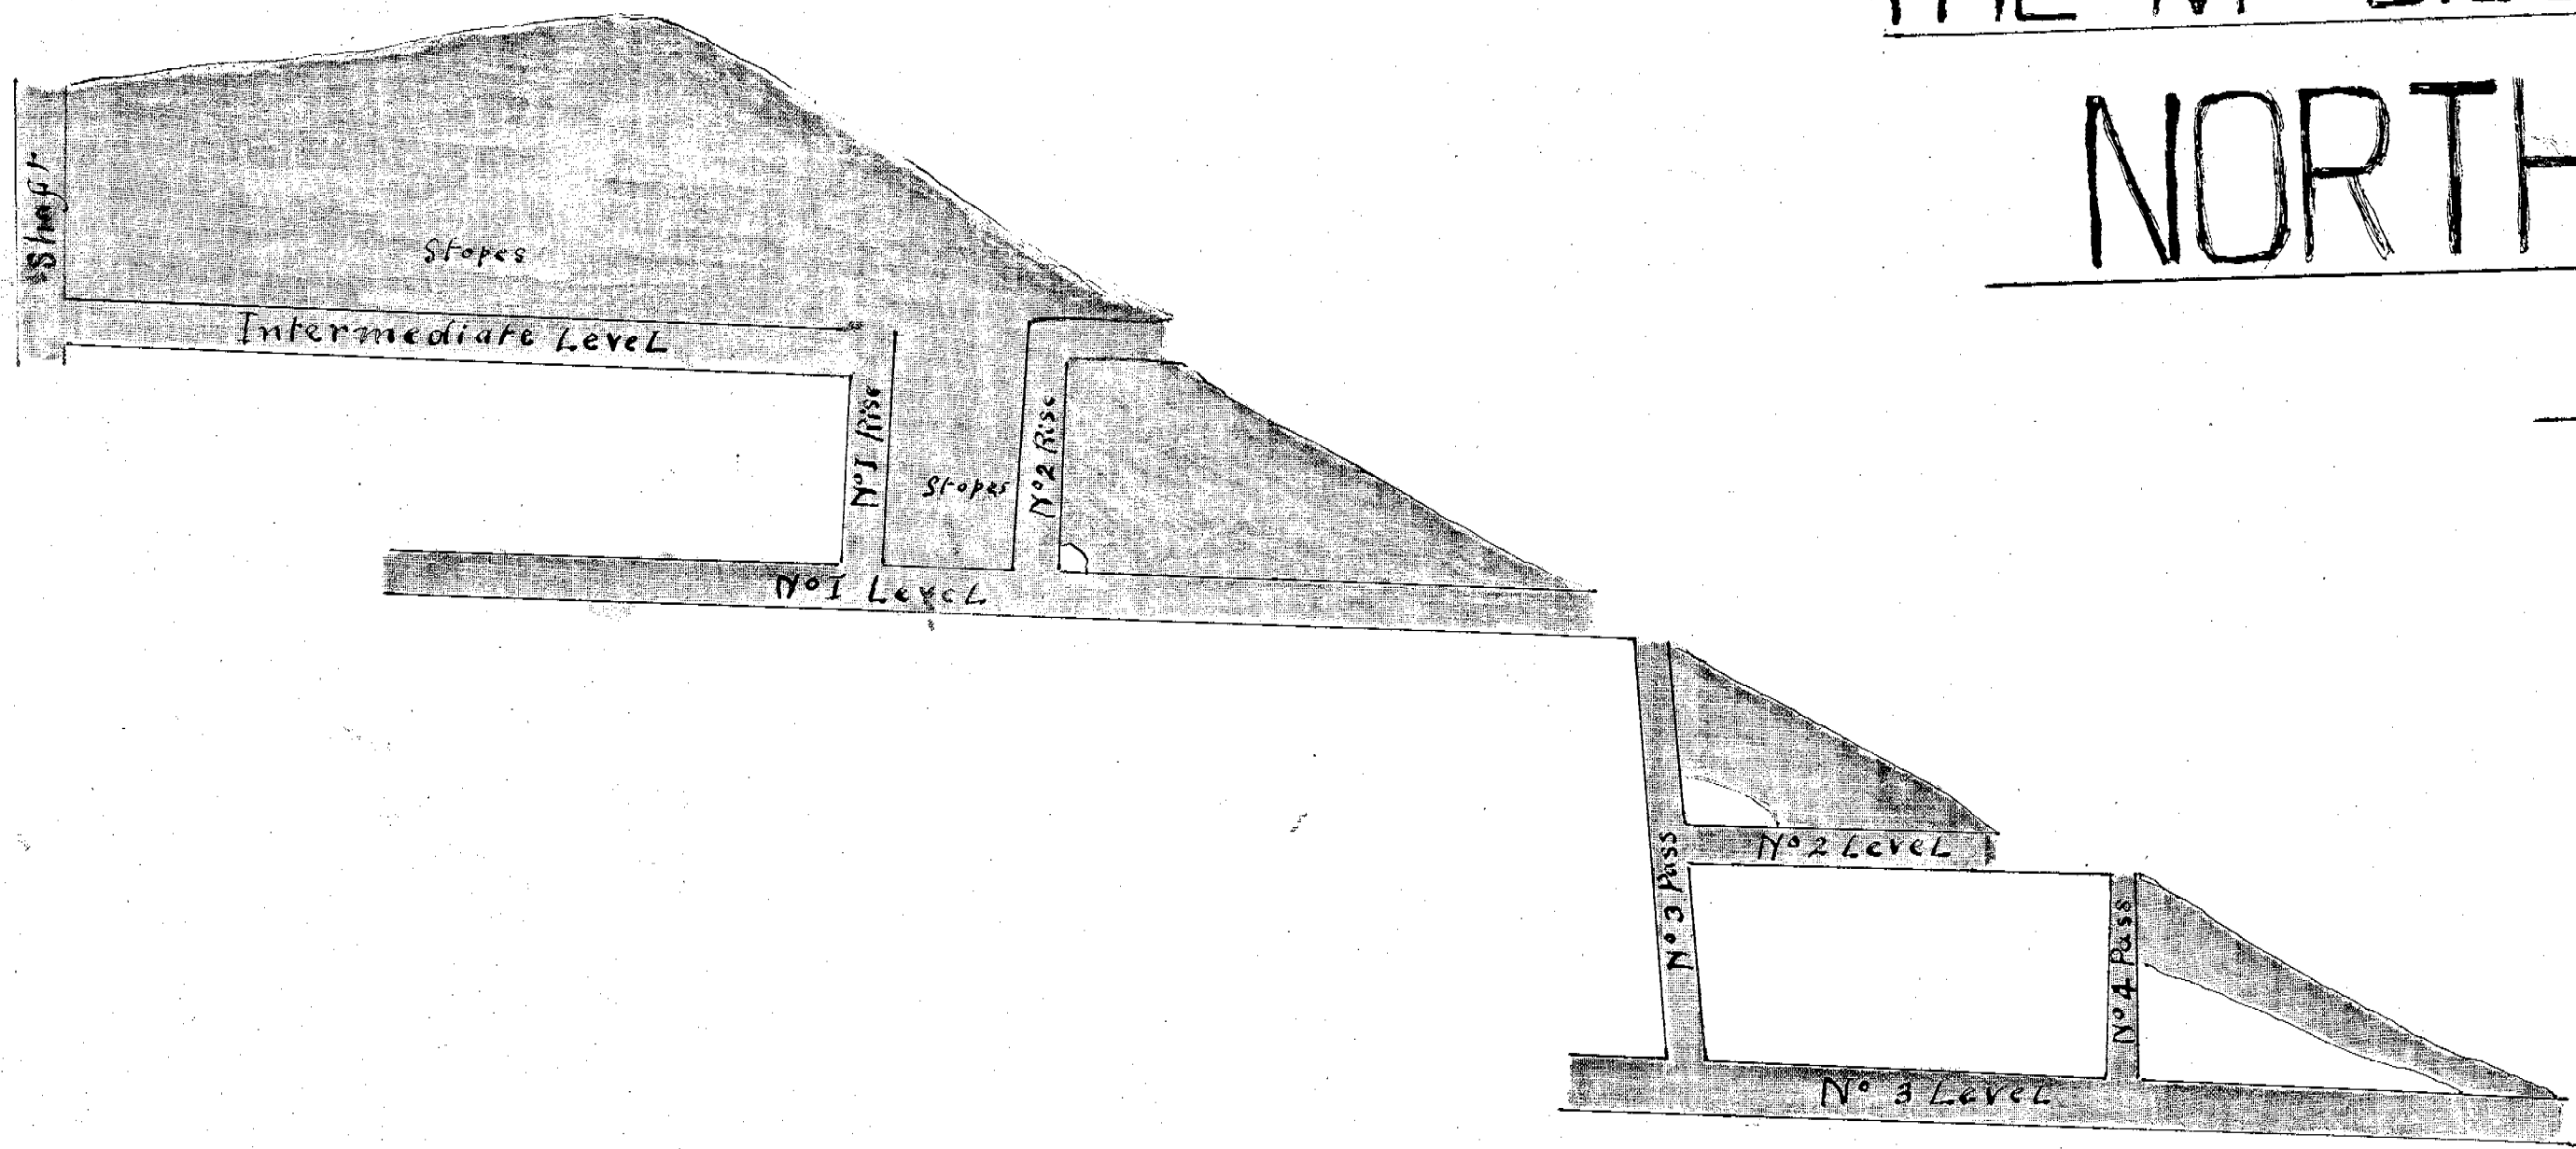

Longitudinal Section

Work 1932
Surveyor H. Porter Instrument 4" theod
10/4/33

217-32