

217-33

Nº 2

SECTIONS

OF

THE MOUNT BISCHOFF T. M. COMPANY'S


UNDERGROUND WORKS

NORTH VALLEY

Scale 50 Feet to one Inch

6 cm

217-33

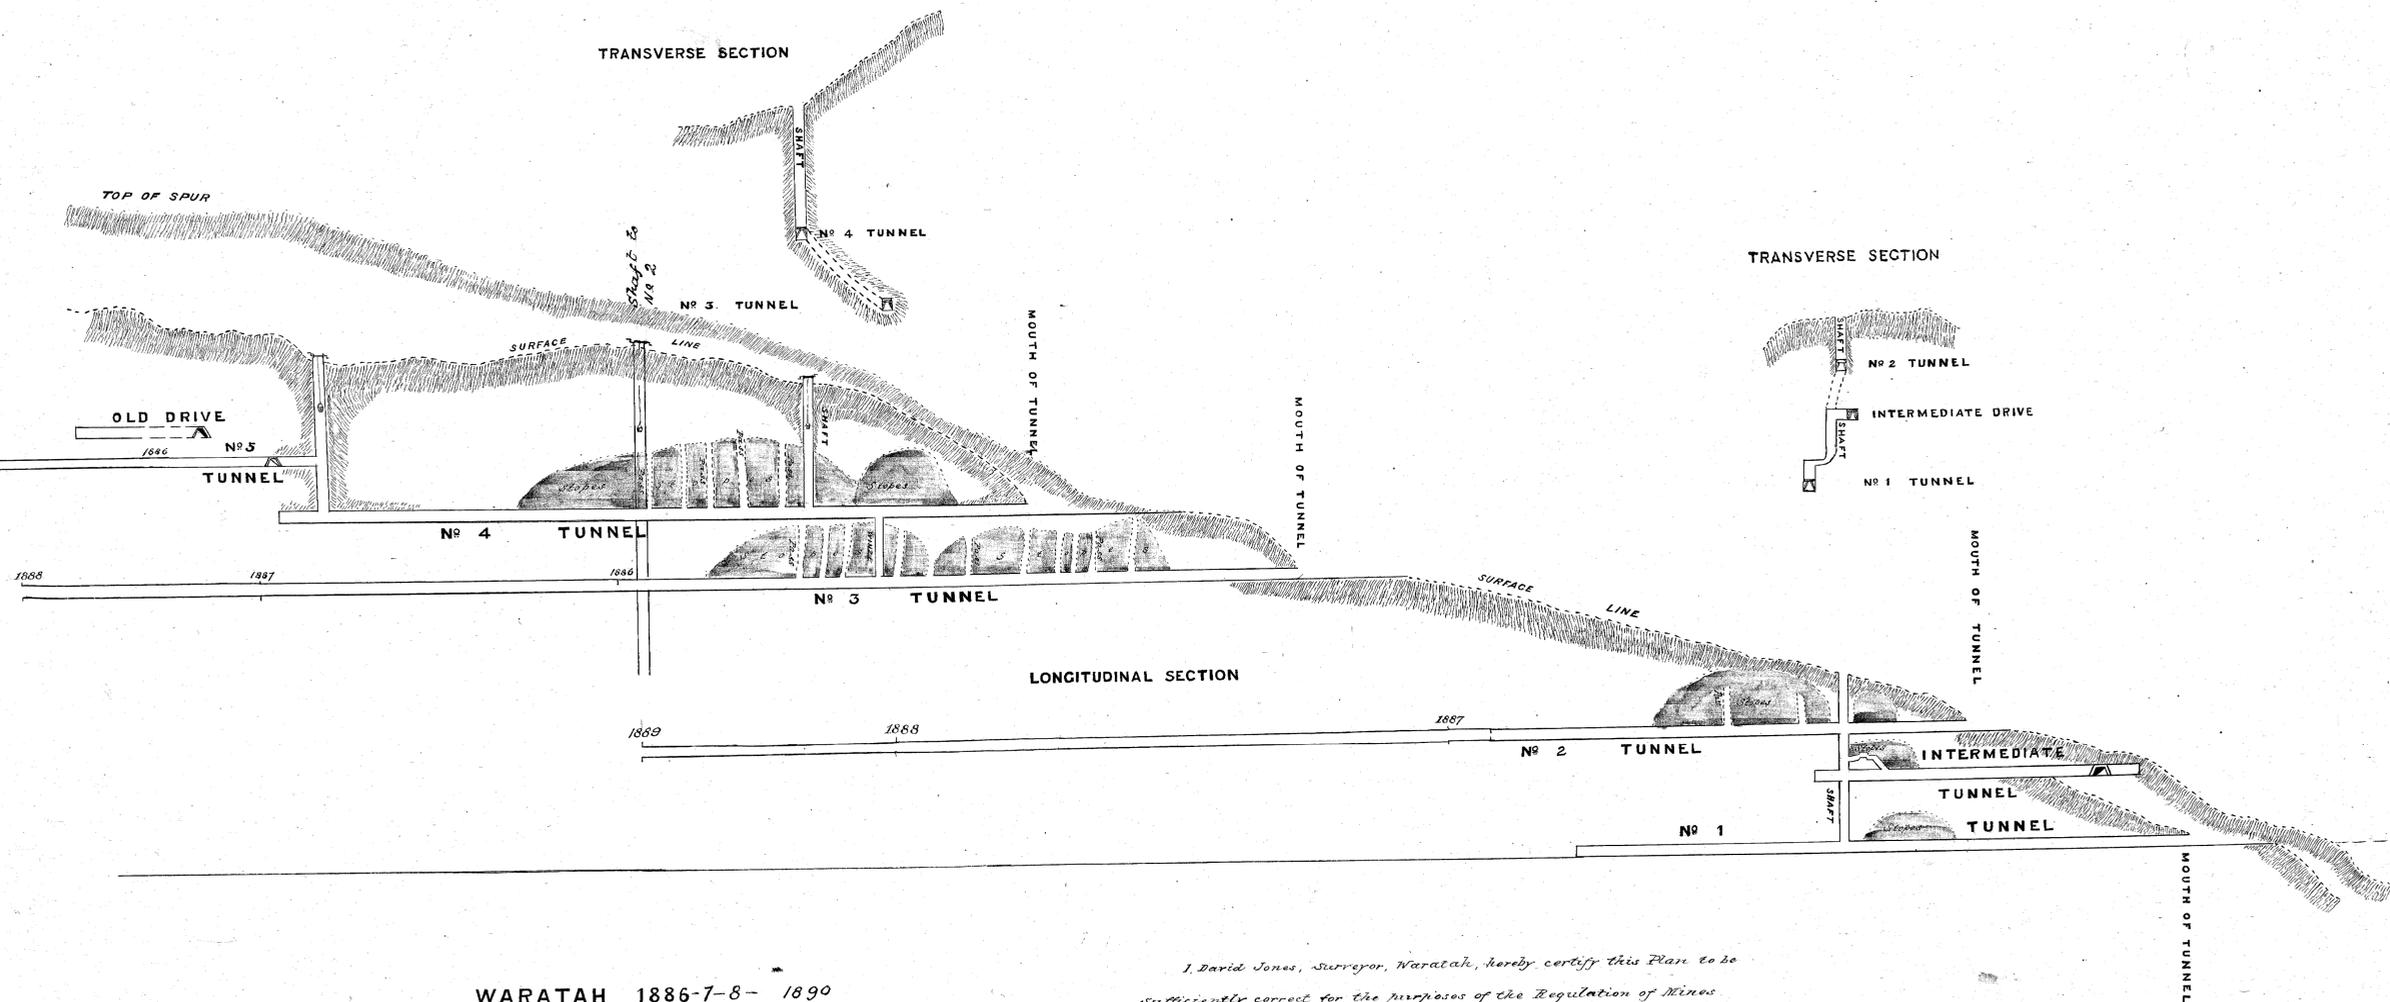

WARATAH 1886-7-8- 1890

David Jones,
Mining Surveyor
January 24th 1886

I, David Jones, Surveyor, Waratah, hereby certify this Plan to be
sufficiently correct for the purposes of the Regulation of Mines
Act 1861, and 1884.

David Jones,
Mining Surveyor *March 27th 1887.*

217-33