

217-34


5 cm

217-34

— MT BISCHOFF T.M.CO.REG —

— NORTH WEST LODE —

— SCALE 25 FT TO 1 INCH —

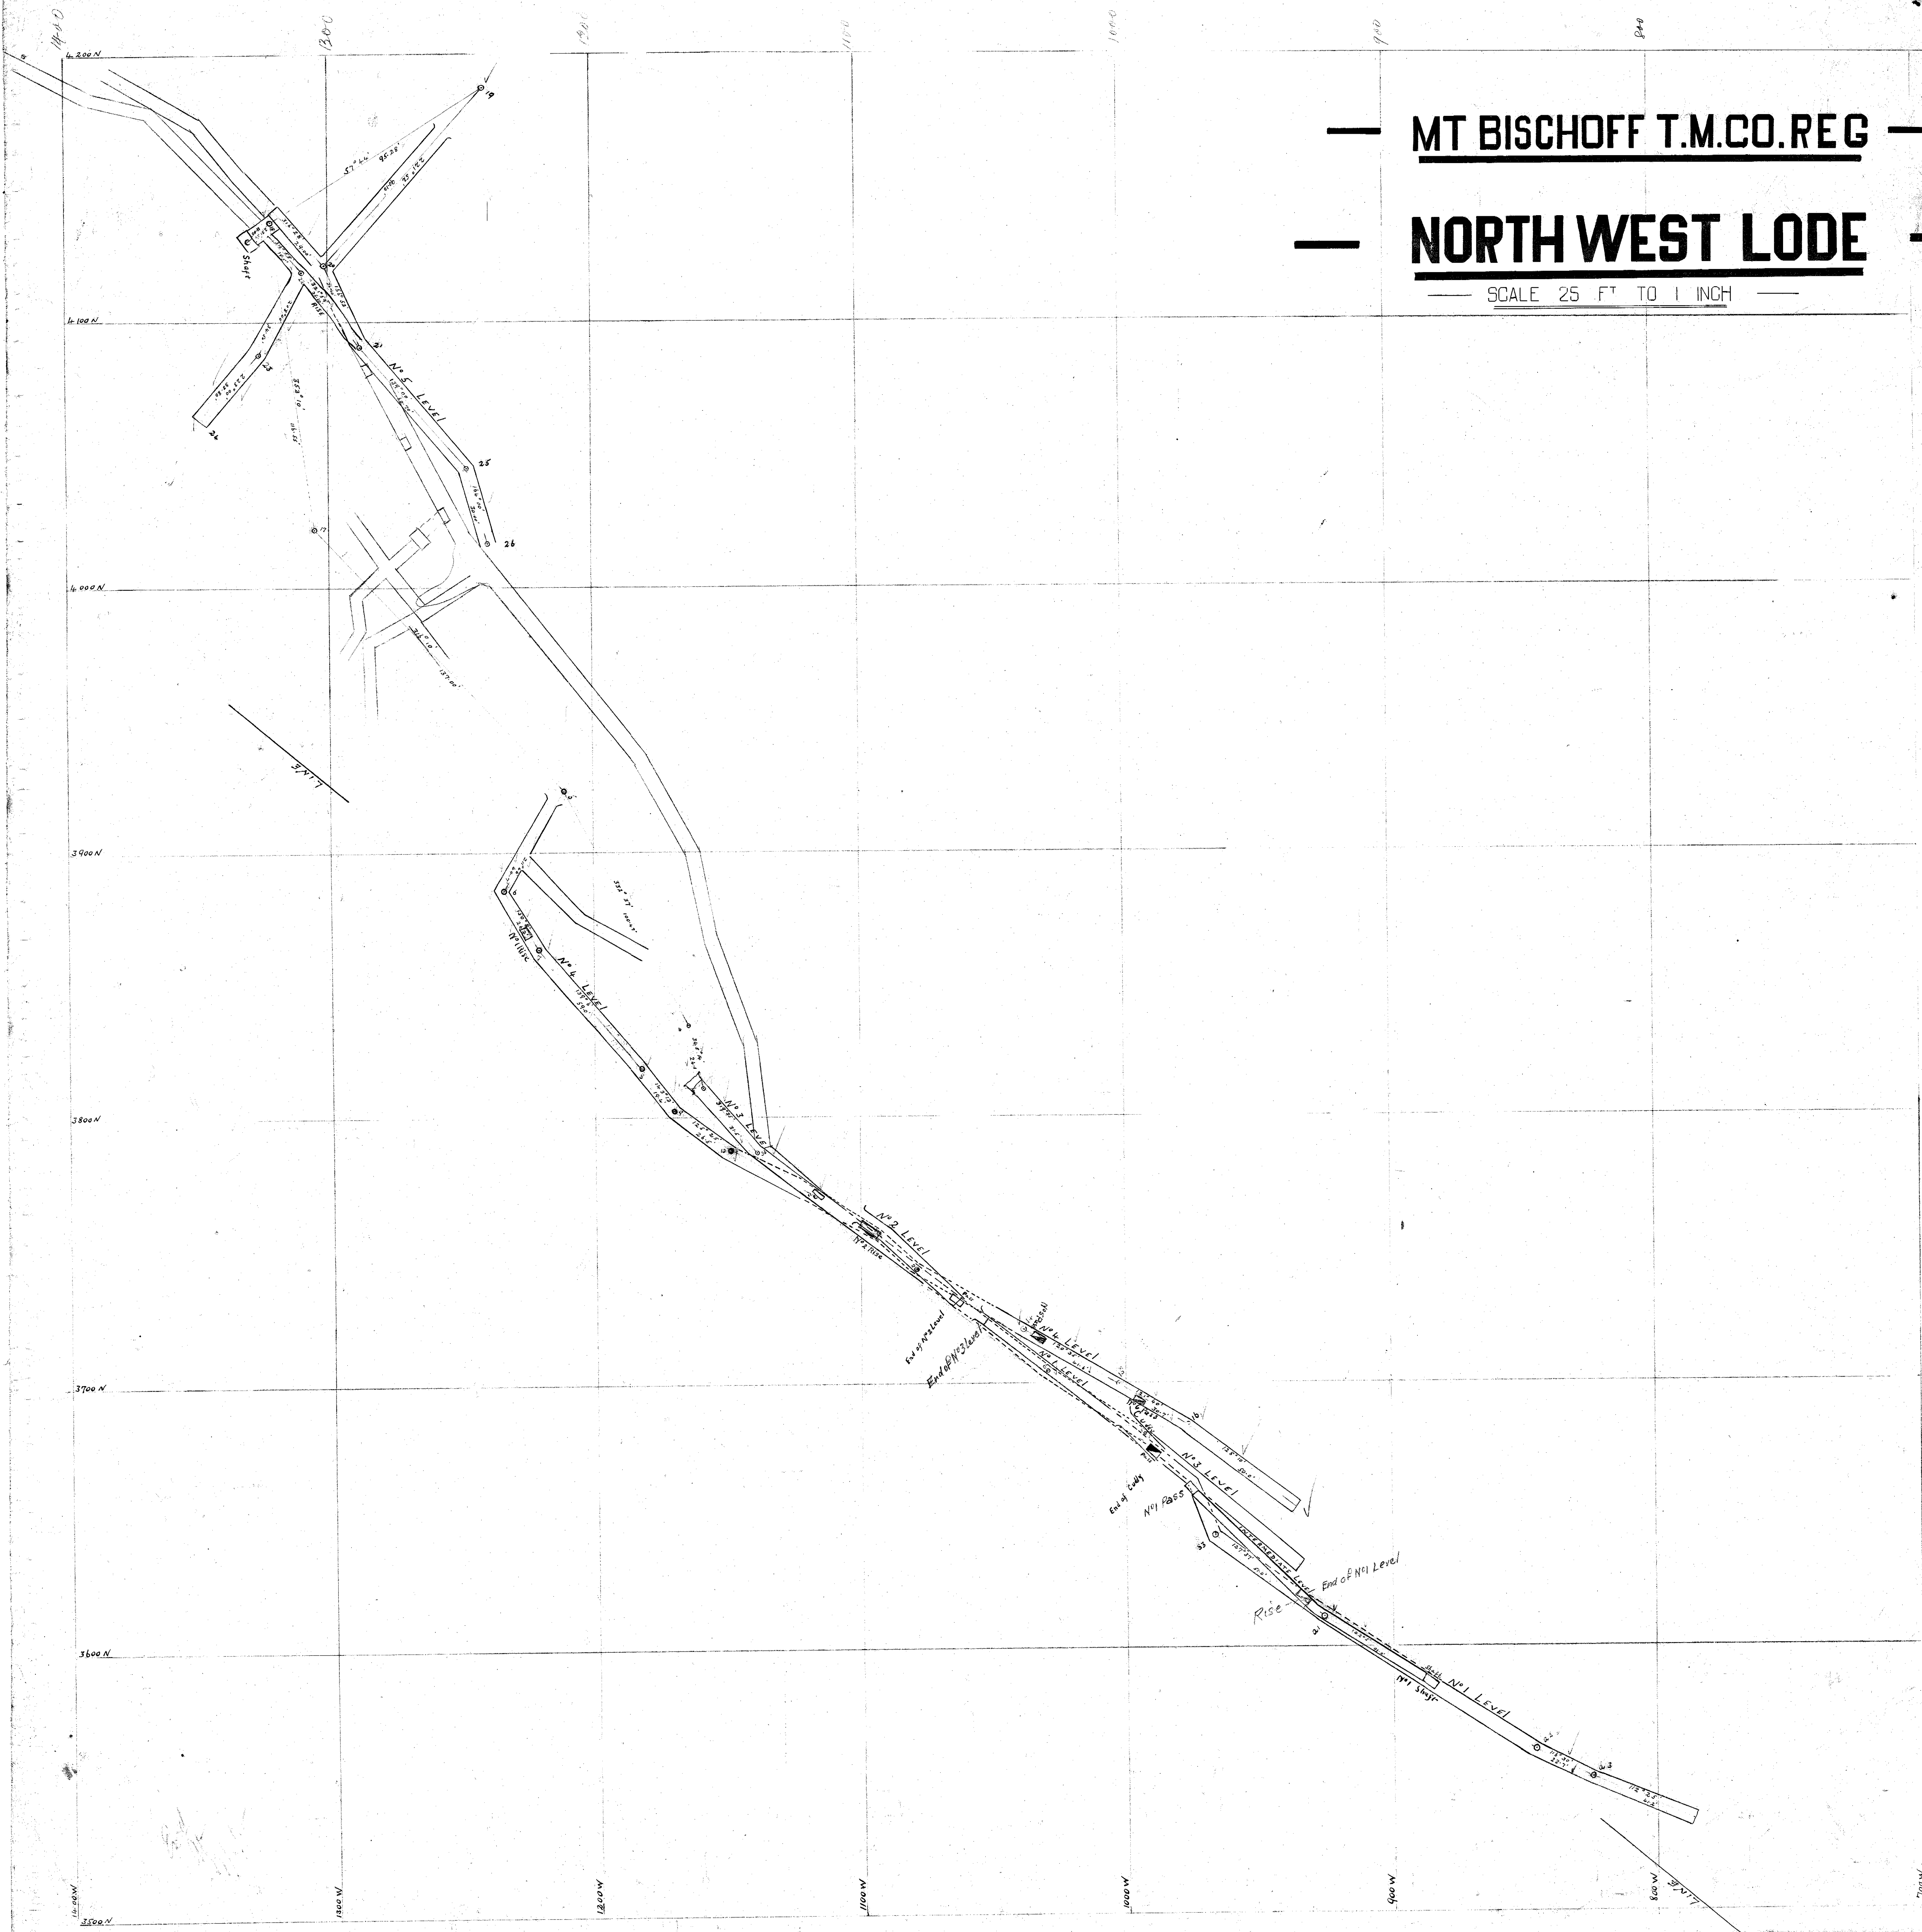

Work 1934
Surveyor M. D. Dole
Not used 0° Head and Compass

3570