


217-36

5 cm

21736

Work 1932.
Surveyor W. Port. Int. and 4" Hood
10/7/32

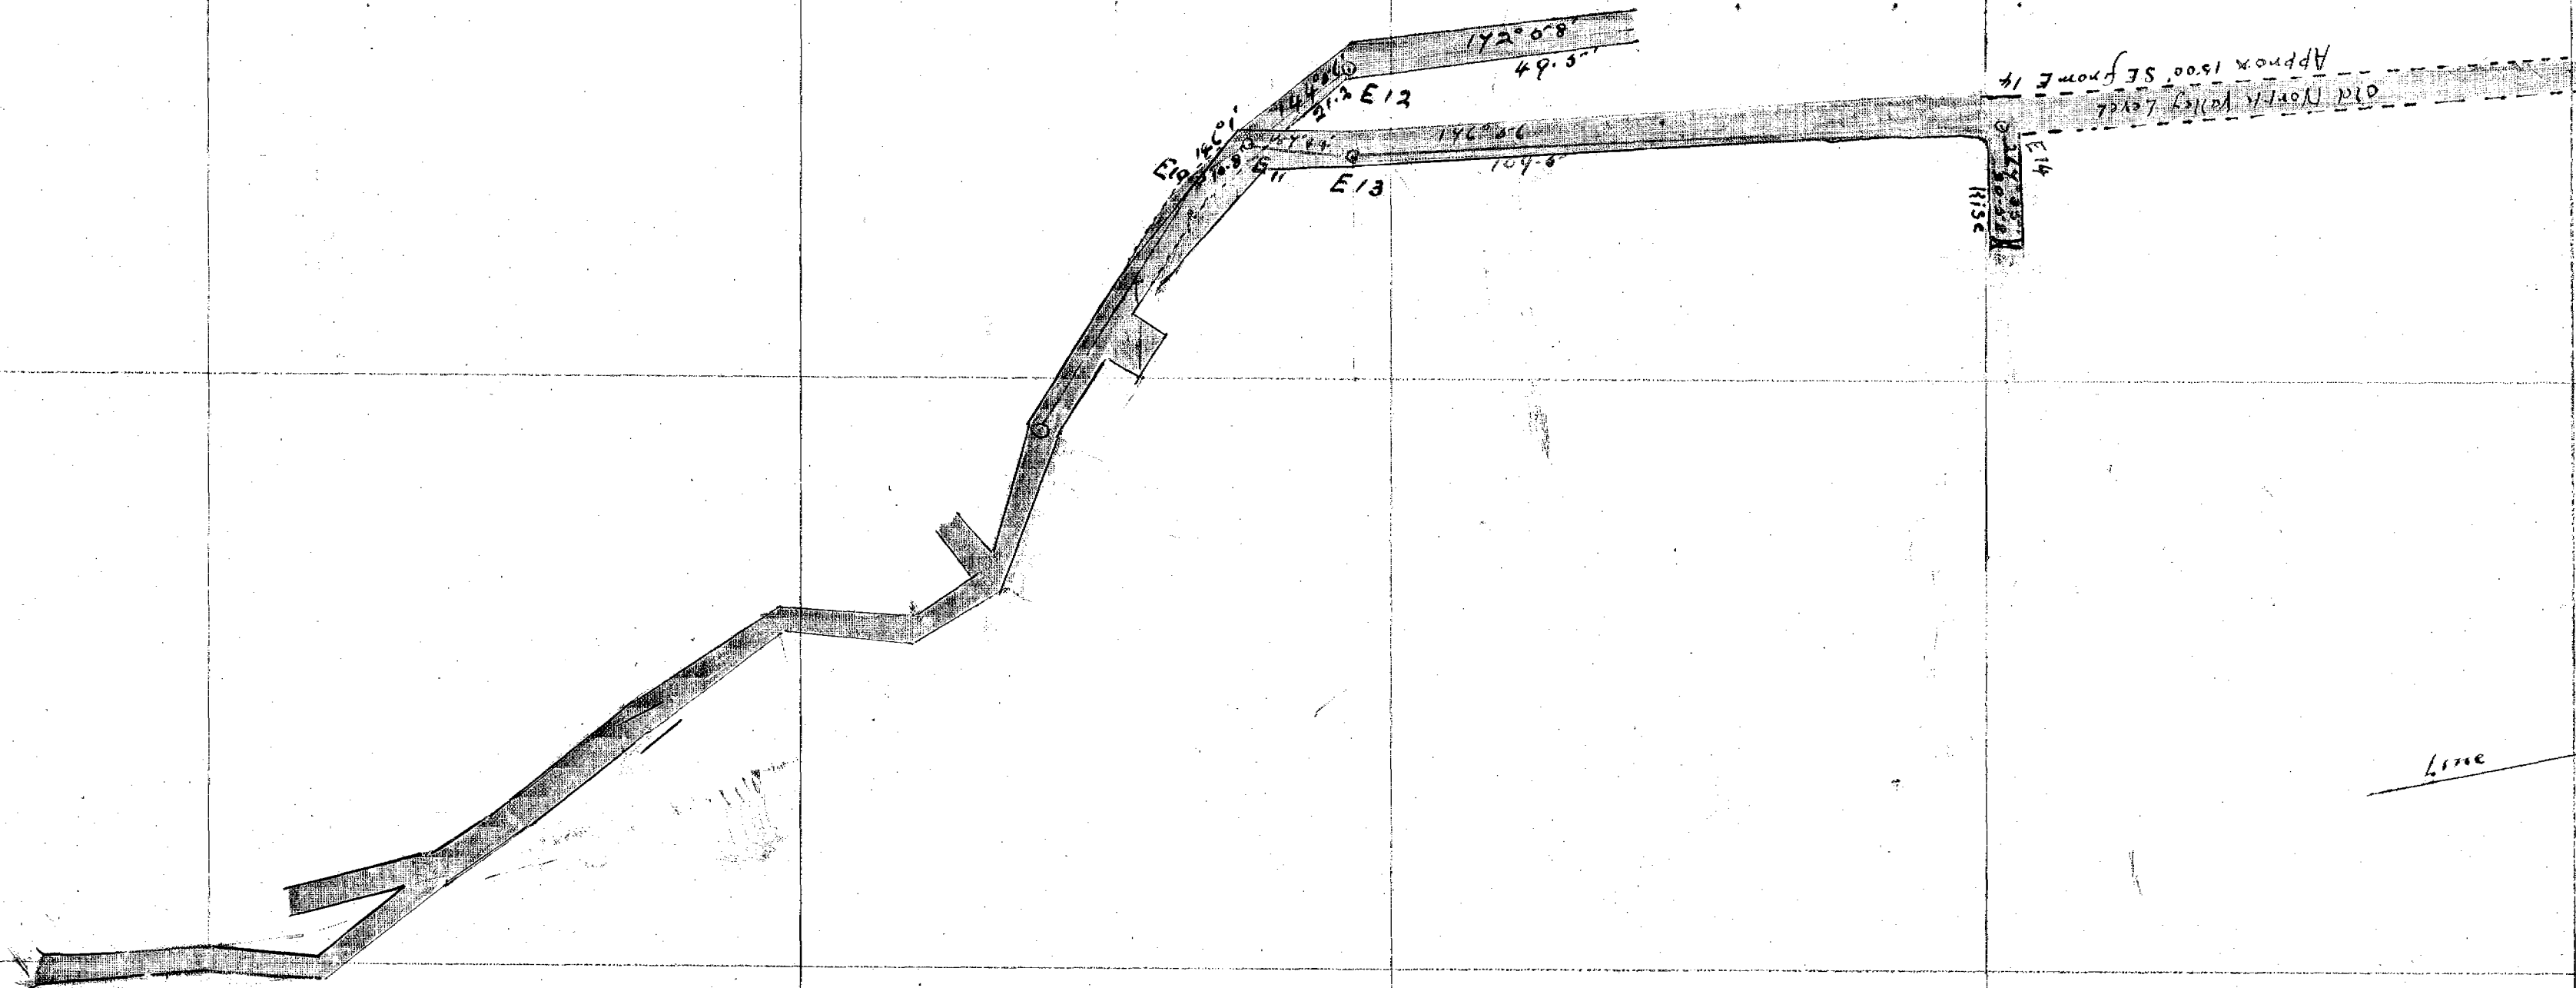

MT BISCHOFF T M CO REC
NORTH WEST LODE

Scale 25 ft = 1 inch