


217-37

# MT BISCHOFF T.M.CO.REG.

# NORTH WEST LODGE

TRANSVERSE SECTION

SCALE 25 FT TO 1 INCH

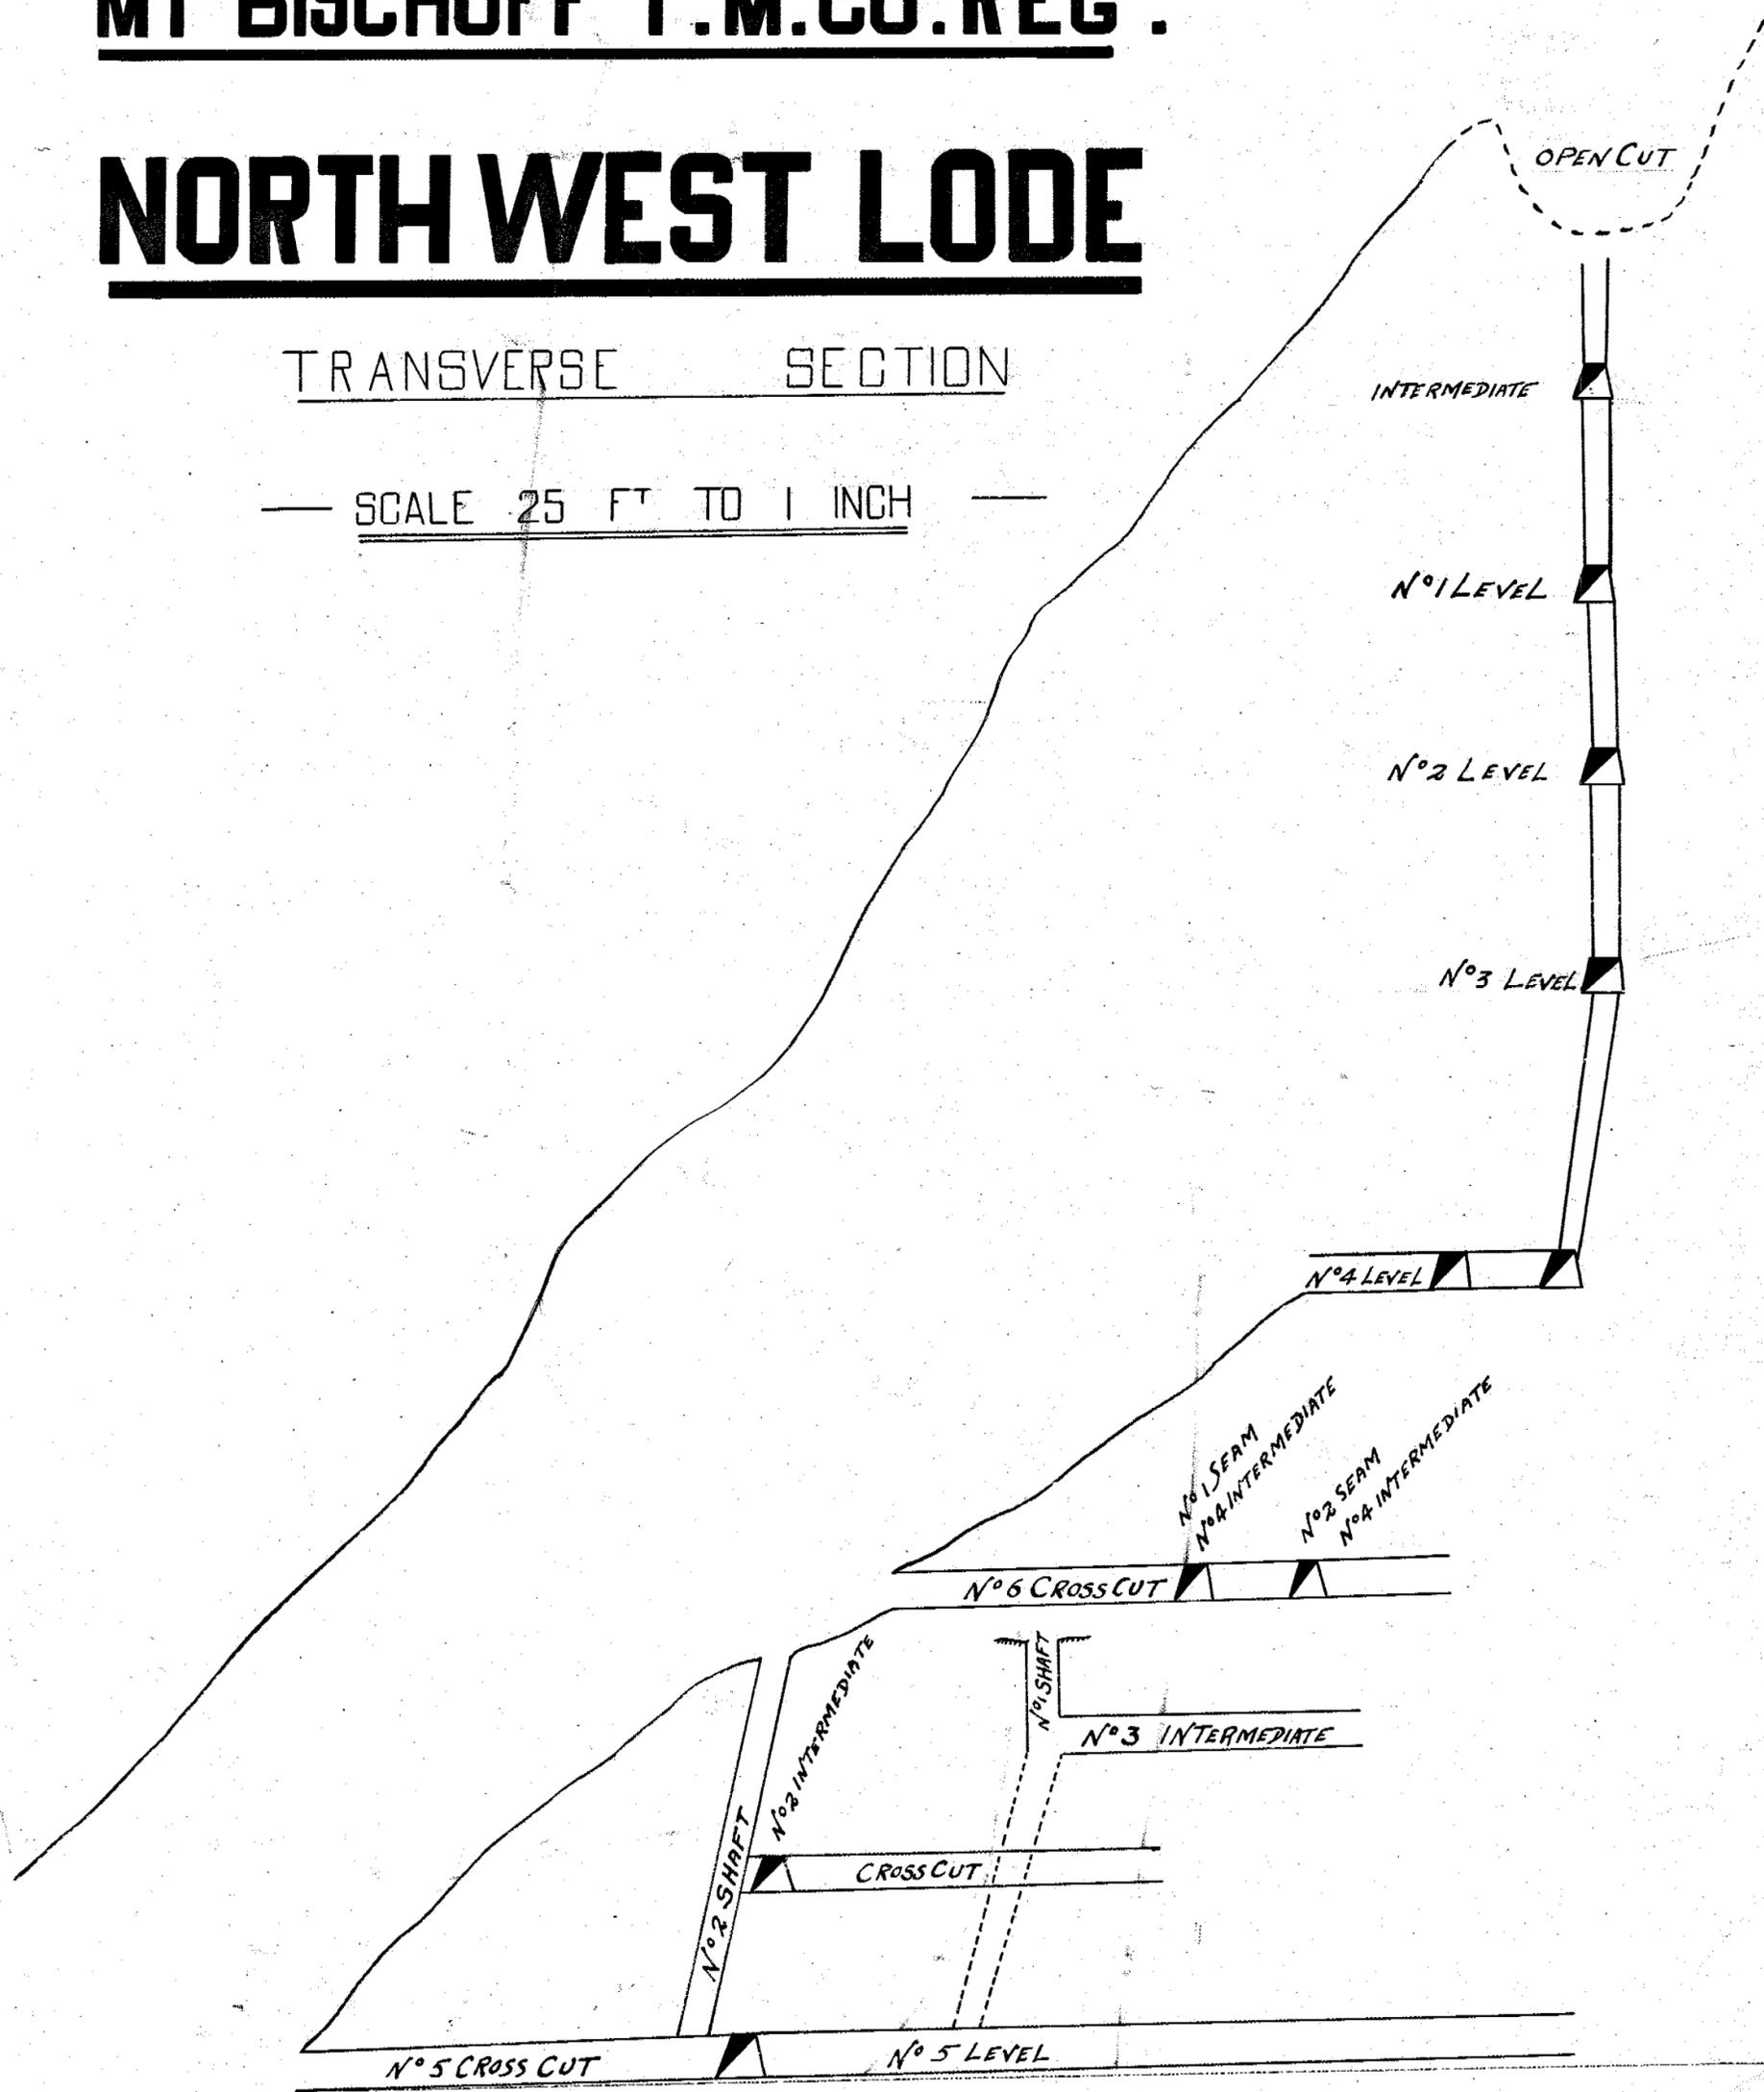

EX 217-37

WORK 1936  
SURVEYOR G. J. Pate  
INST. USED S THEOD.  
DATE 7 June 1931