

— **MT BISCHOFF T.M.CO.REG.** —

— **NORTH WEST LODE** —


— LONGITUDINAL SECTION —

— SCALE 25 FT TO 1 INCH —


217-39

5 MB

217-39

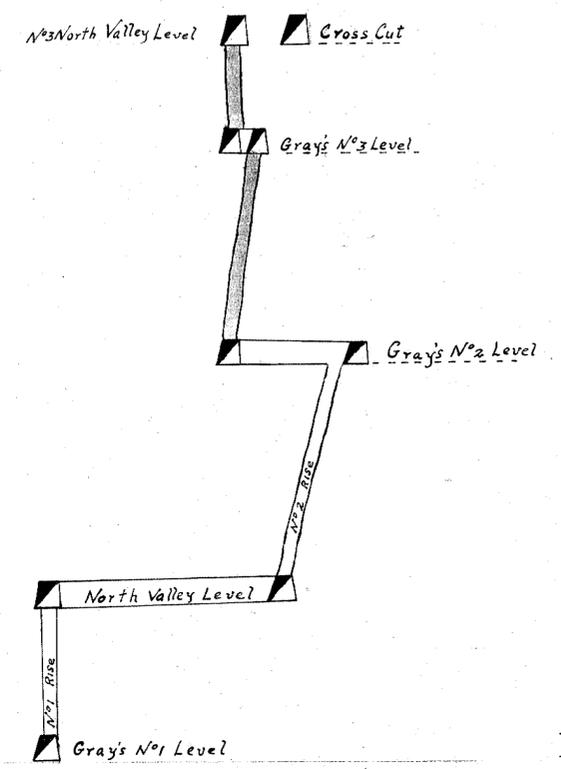

TRANSVERSE SECTION

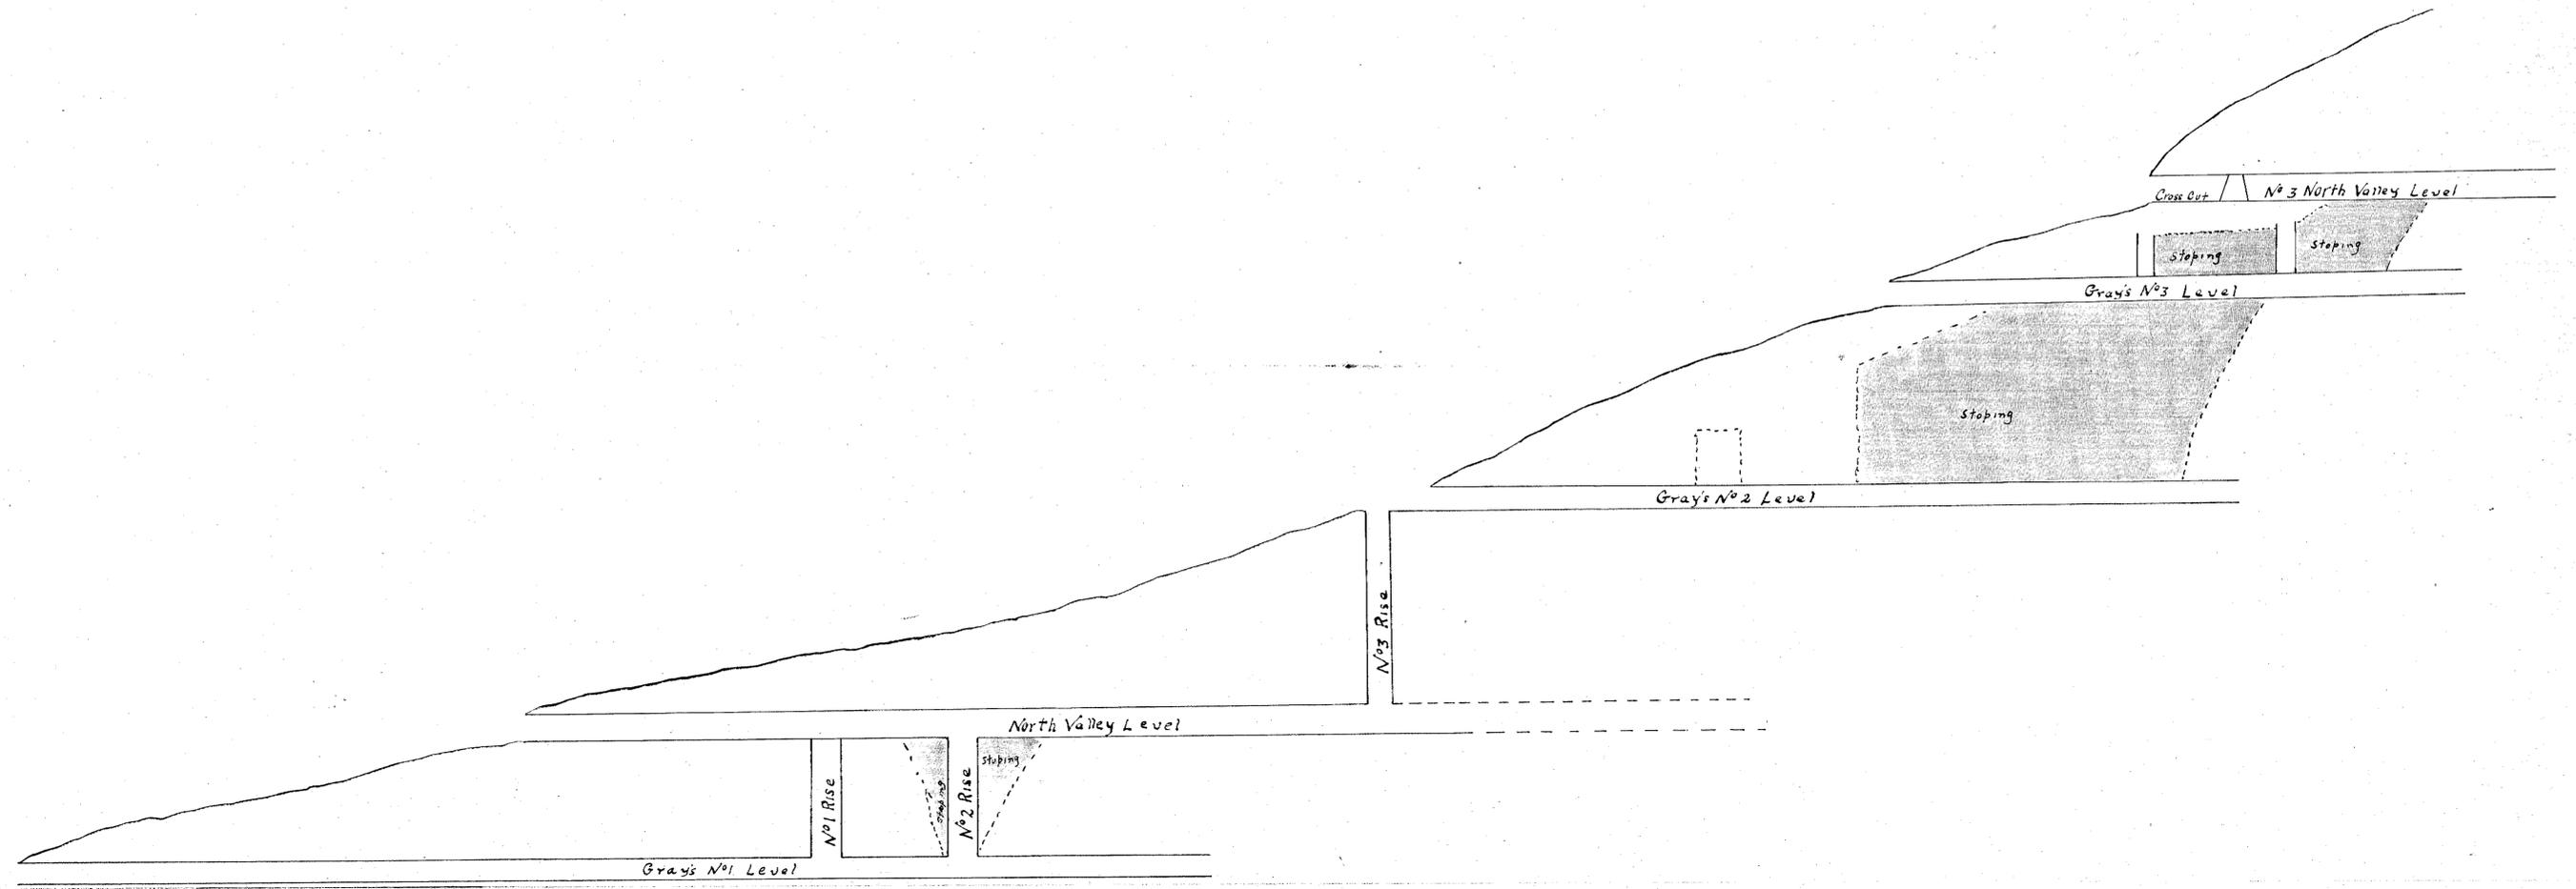

Work 1934
Surveyor W. D. Dink
Foot-cord 6" Head