

Mount Bischoff T. M. Co.

2/2/94





North Valley

Scale 50 Feet to an Inch

Lanier Jones,
Mining Surveyor,
Wheaton.
January 29th 1894.

217-140

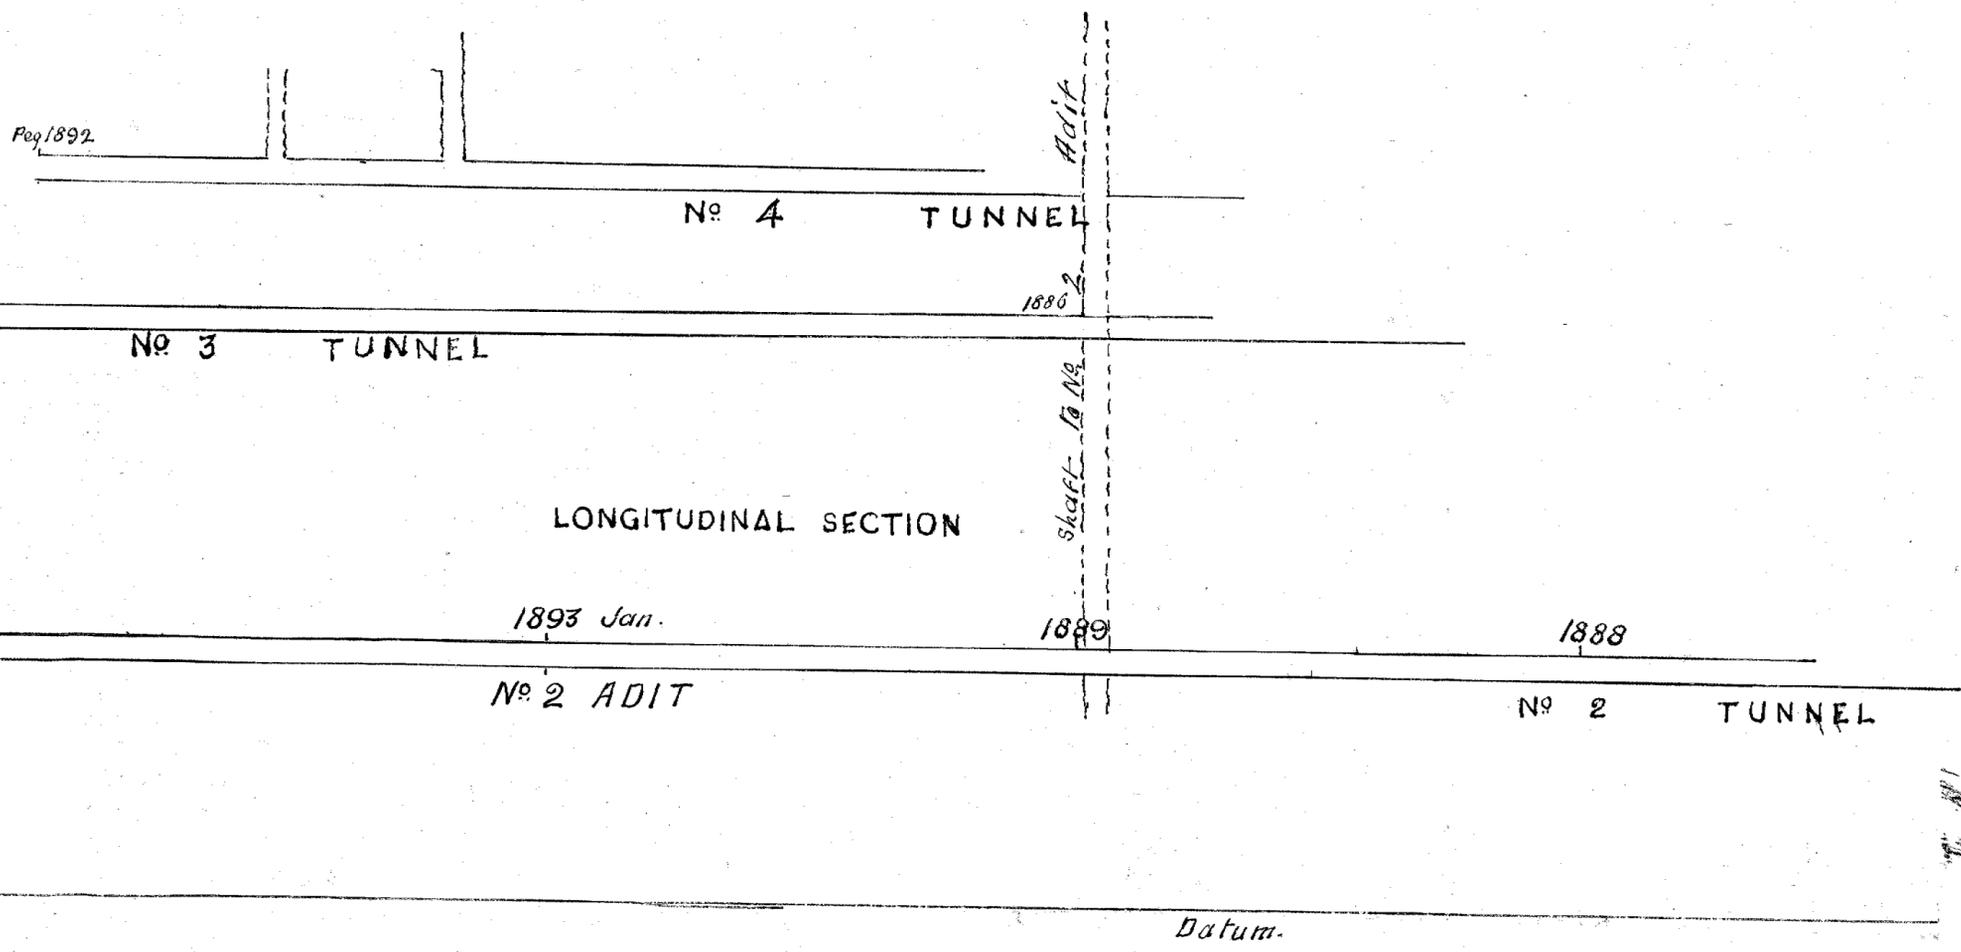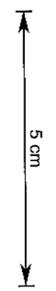

PEG JAN 1894.

217-140

1894