


MT BISCHOFF T.M.CO.REG.


NORTH WEST LODGE

— SCALE 25 FT TO 1 INCH —

5 cm

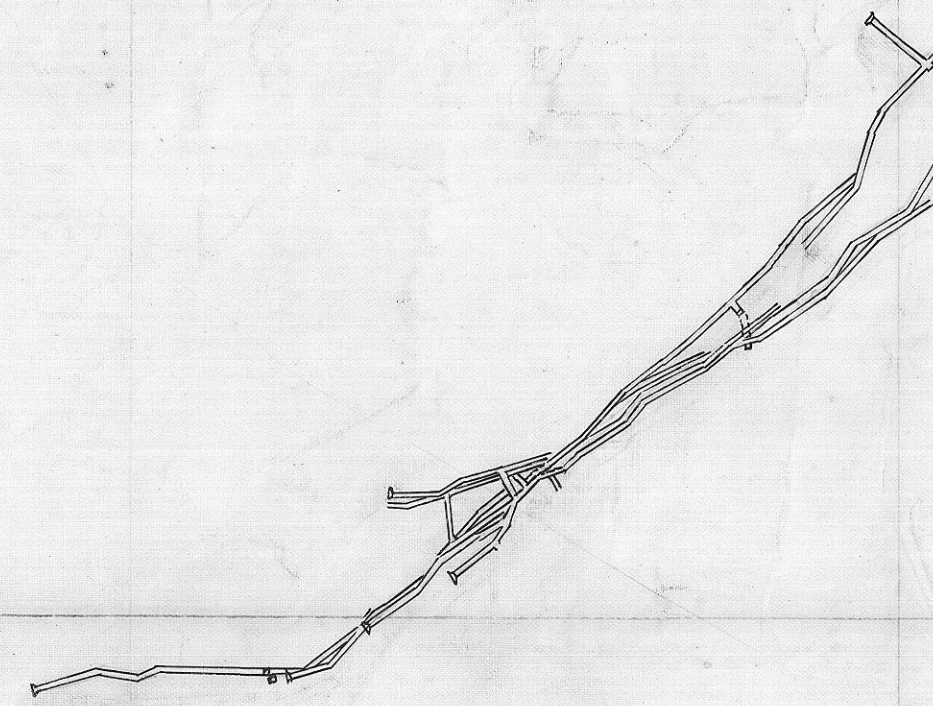

217-44

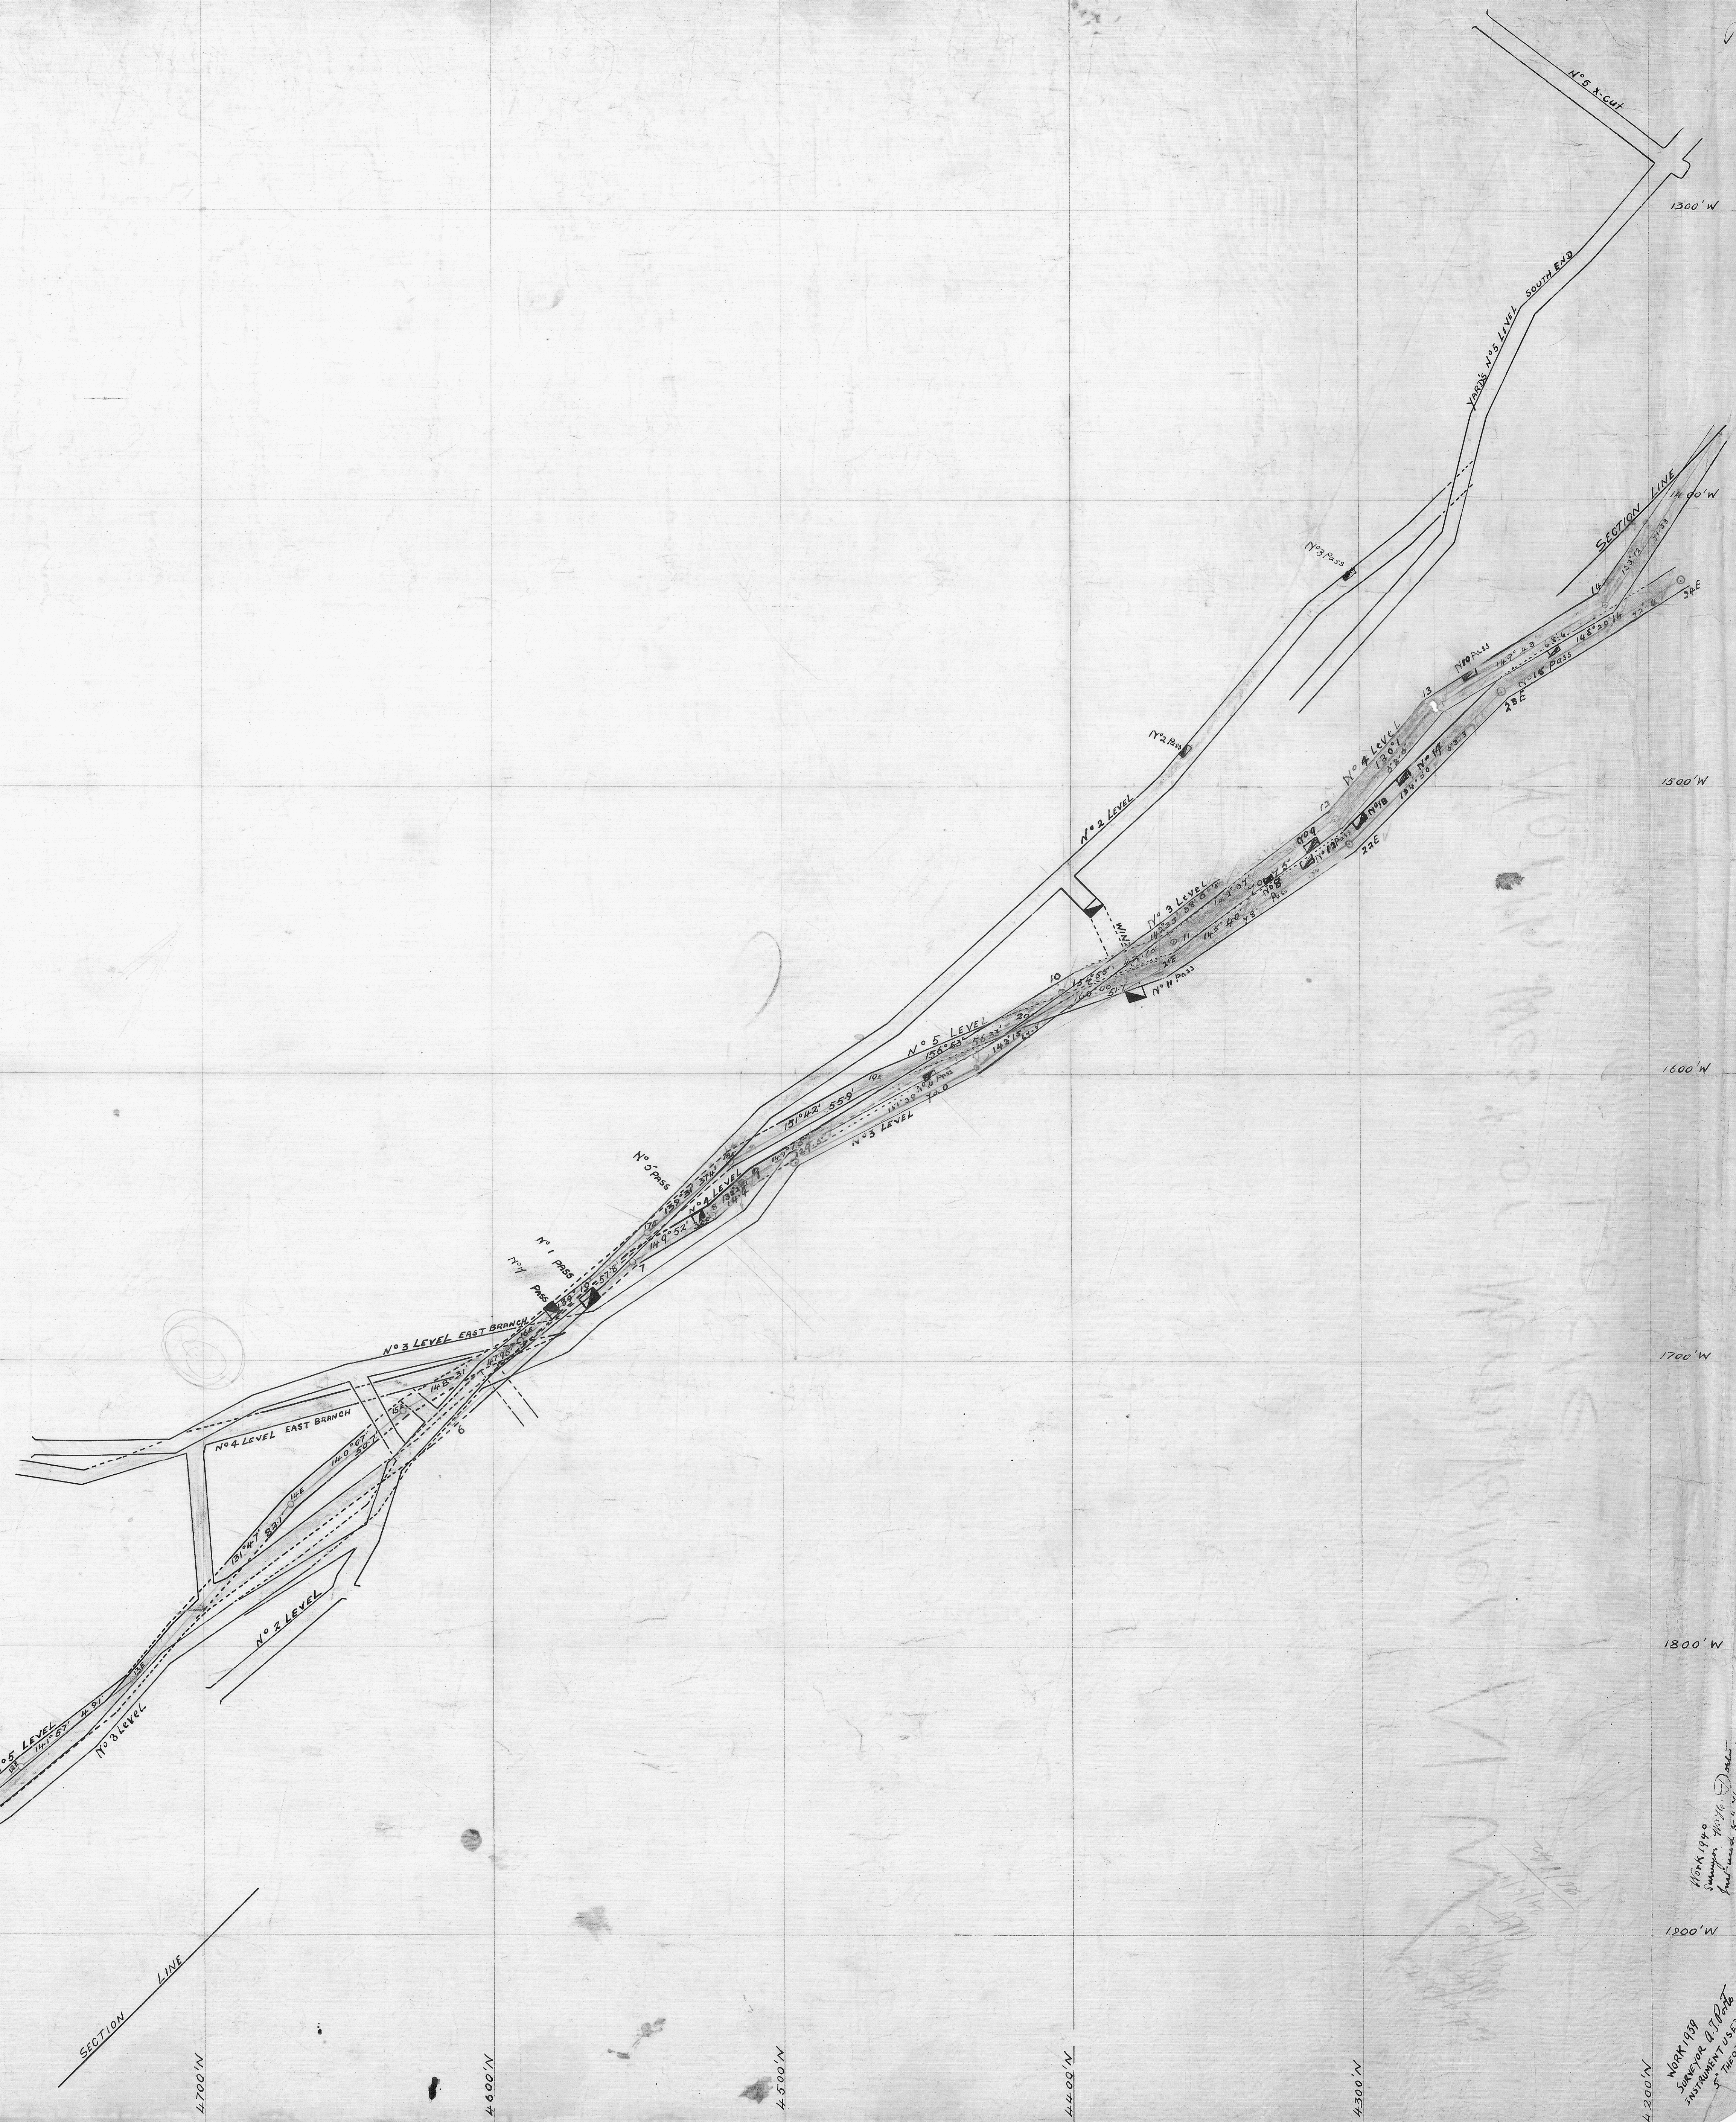

W.M. 1940
10th Nov 1942

W.M. 1940
10th Nov 1942

W.M. 1940
10th Nov 1942