




MT BISCHOFF T.M.CO REG
NORTH WEST LODGE

Scale 25 ft = 1 Inch

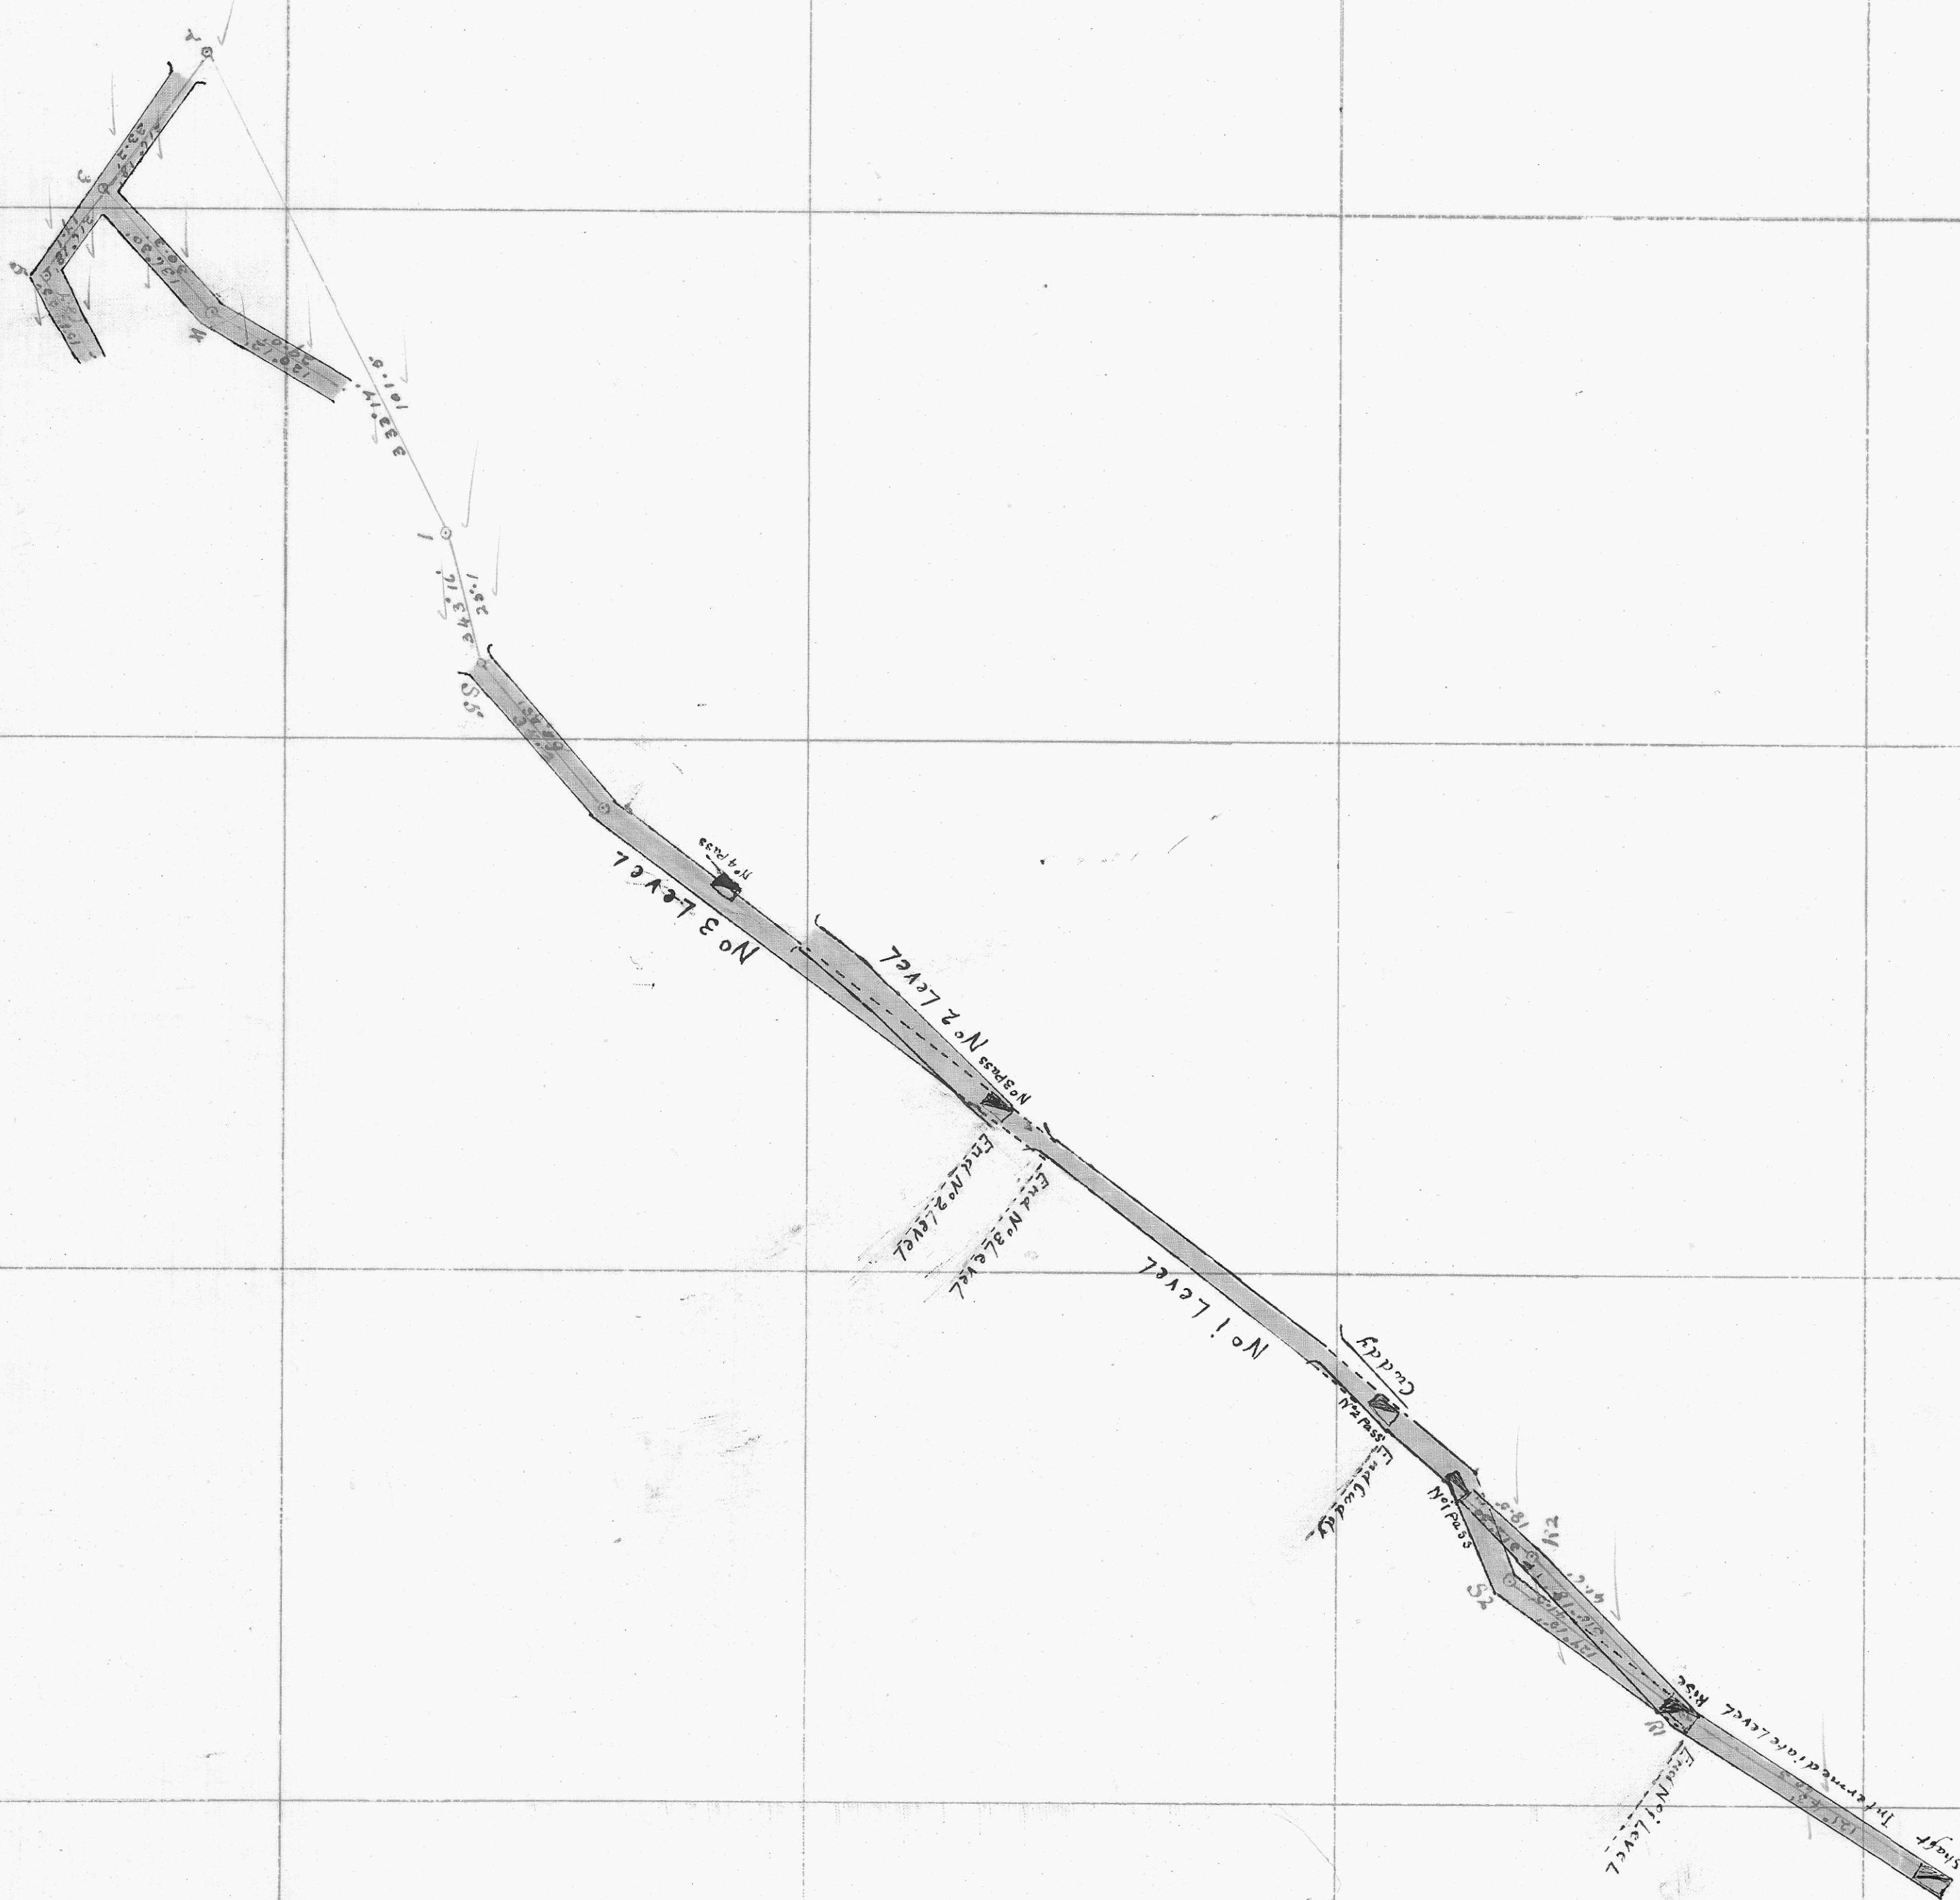

Work 1932
Surveyor W. Porter
Just used 4" theod
10/4/33