


MT BISCHOFF T.M.CO.REG.

NORTH WEST LODE


LONGITUDINAL SECTION

SCALE 25 FT TO 1 INCH

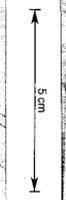

27-44

Work 1935
Survey M.H. Dore
Int. and 6" Hydraulic

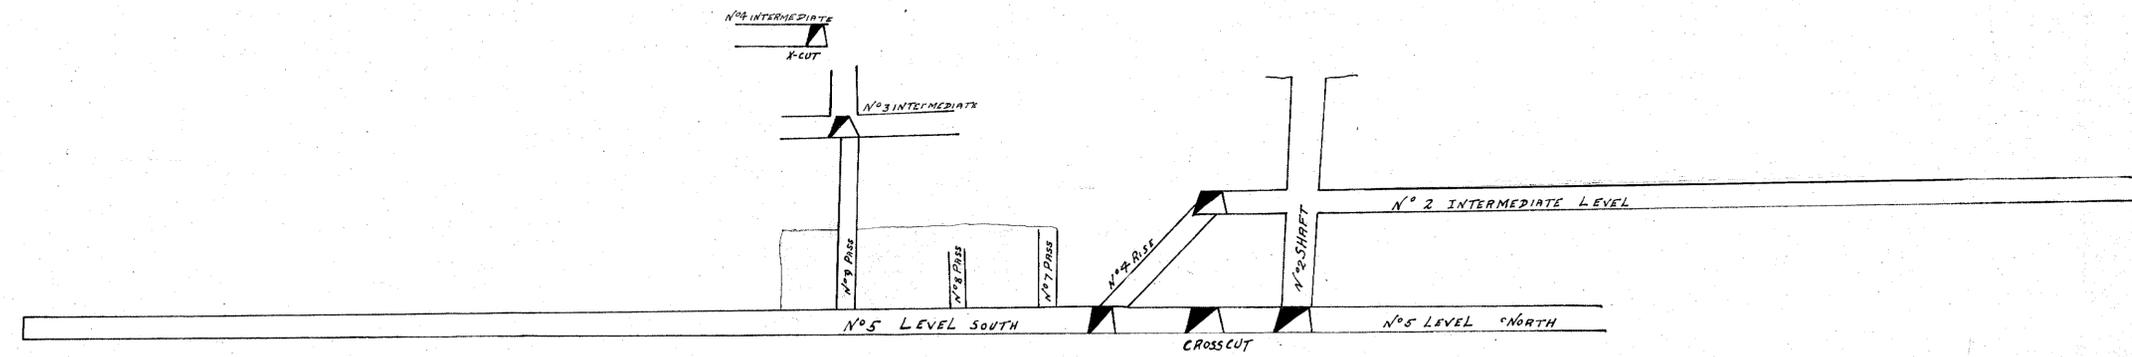

27-44