



— **MT BISCHOFF T.M.CO.REG.** —

— **BROWN FACE SOUTHLODE** —


217-145

— LONGITUDINAL SECTION —

— SCALE 25 FT TO 1 INCH —

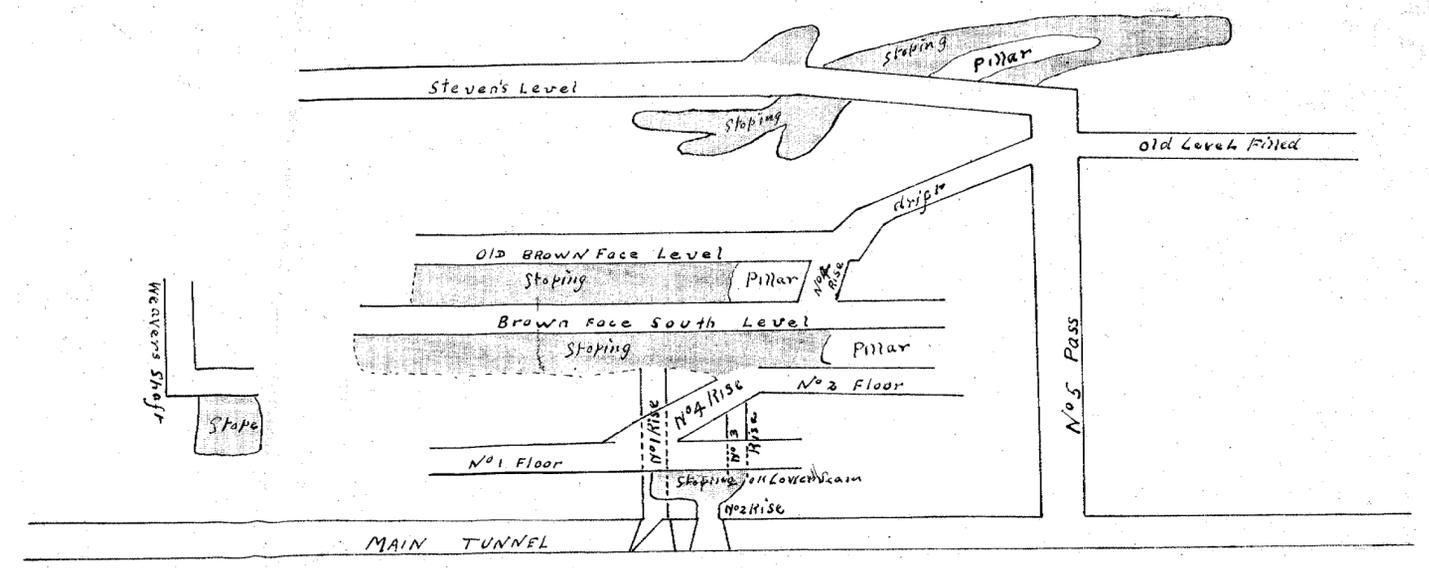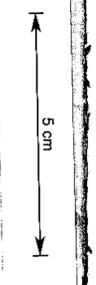

217-145

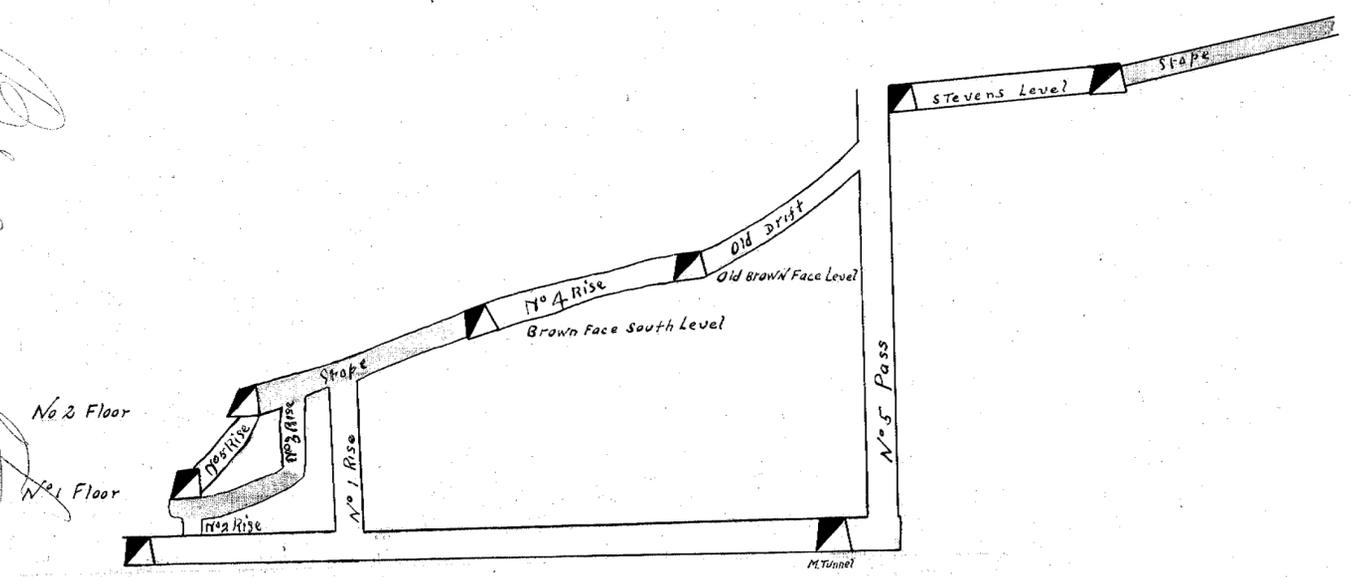

Transverse Section.

4/10/1934  
 Surveyed by M. D. Parks  
 with 5" theod and compass

*Brown Face*