


— MT BISCHOFF T. M. CO. REG. —

— BROWN FACE —

— LONGITUDINAL SECTION —

— Scale 25 Ft to 1 Inch —

*additions to 21.12.23.
Mt. Bischoff 7.4.24.*

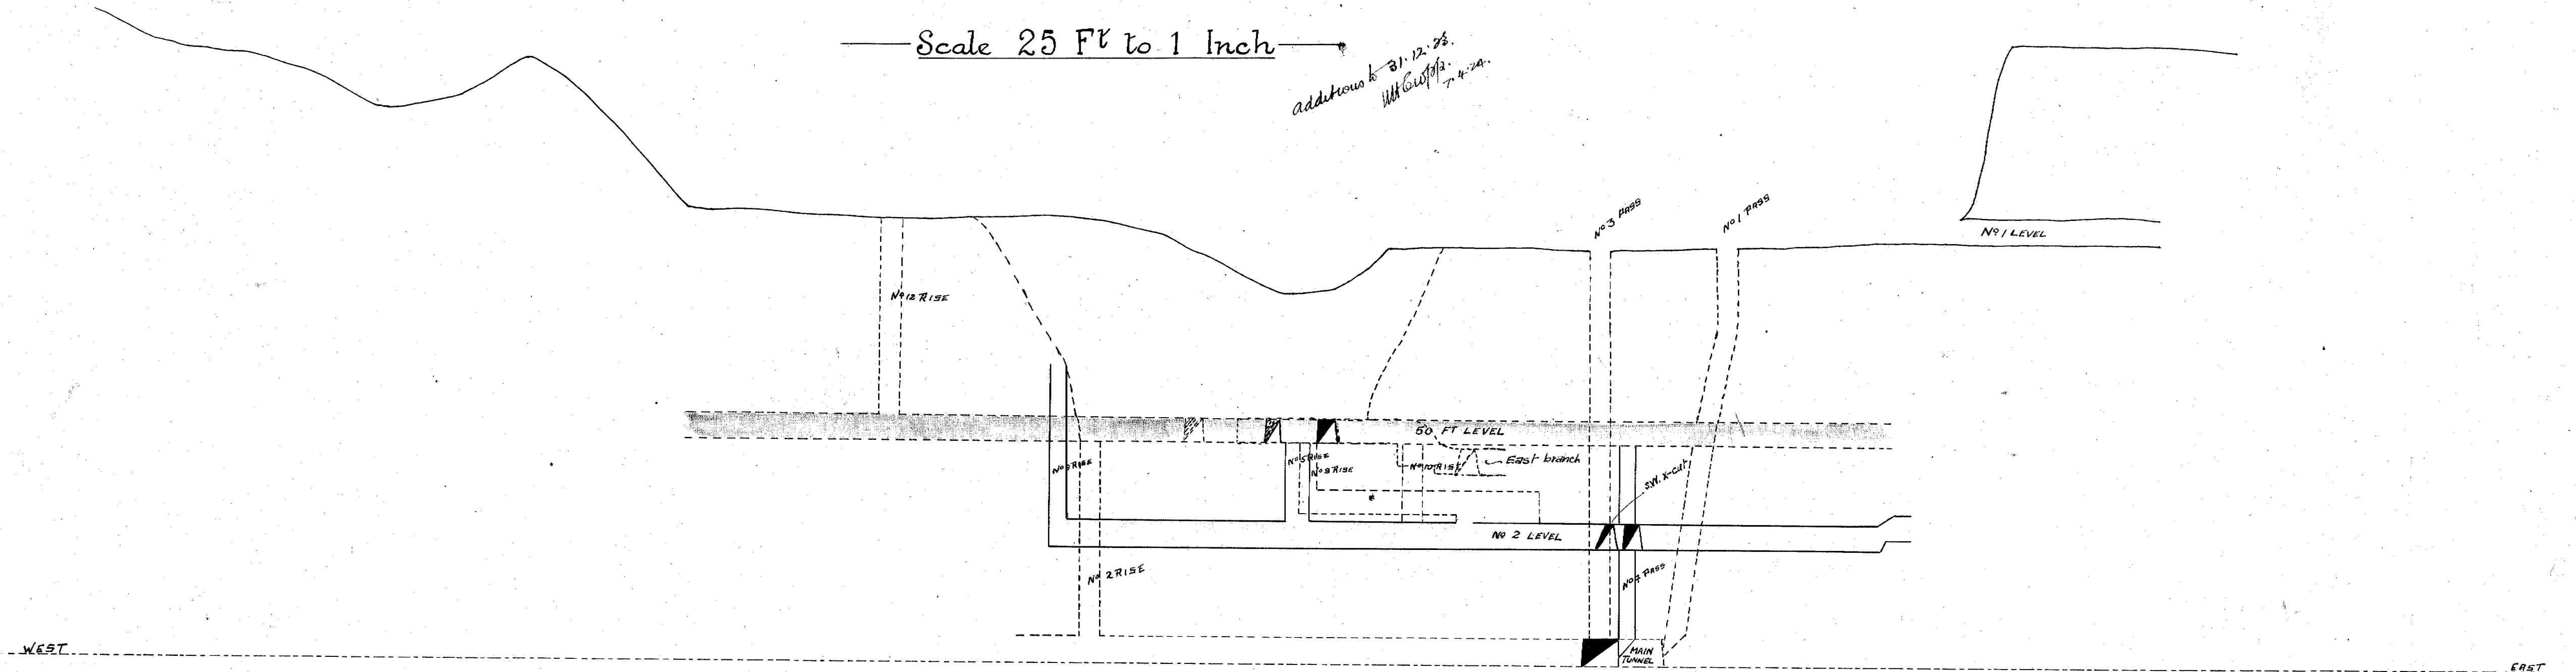

*H. Somerville,
Mine Surveyor
22.3.23.*

H. 23