


217-48

5 cm

217-48


Work 1938  
Surveyor W. H. D. etc.  
but used 5" theodolite

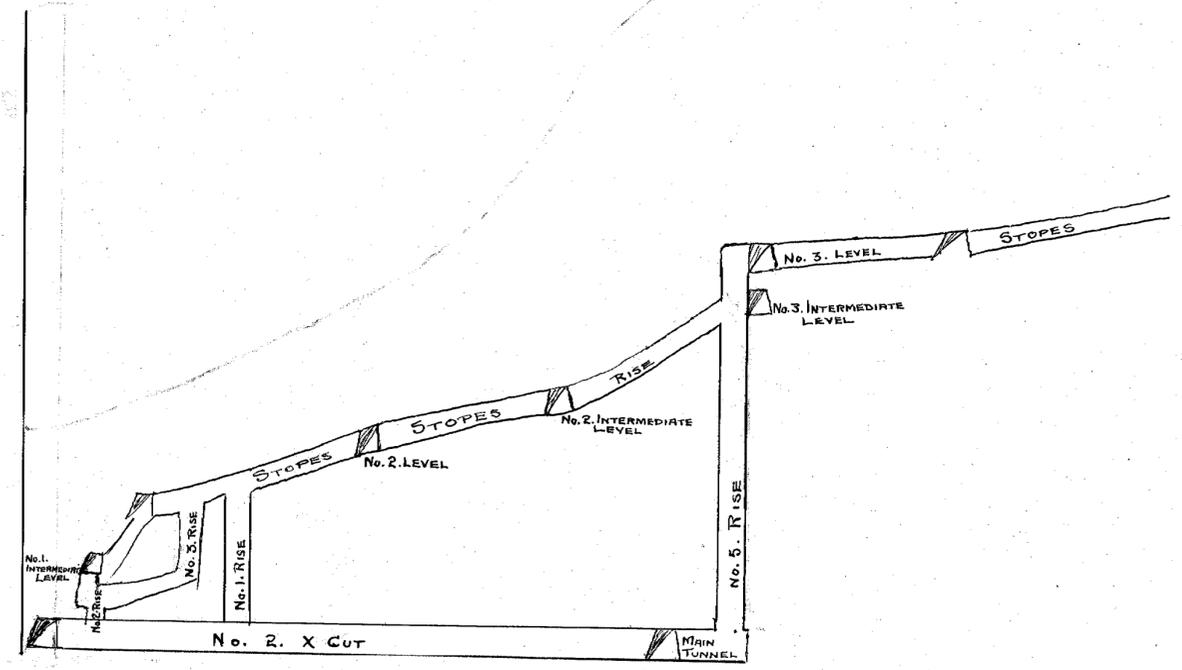

TRANSVERSE SECTION

— MT BISCHOFF T M CO REC —  
**BROWN FACE SOUTH LODE**

— SCALE 25 FT TO 1 INCH —

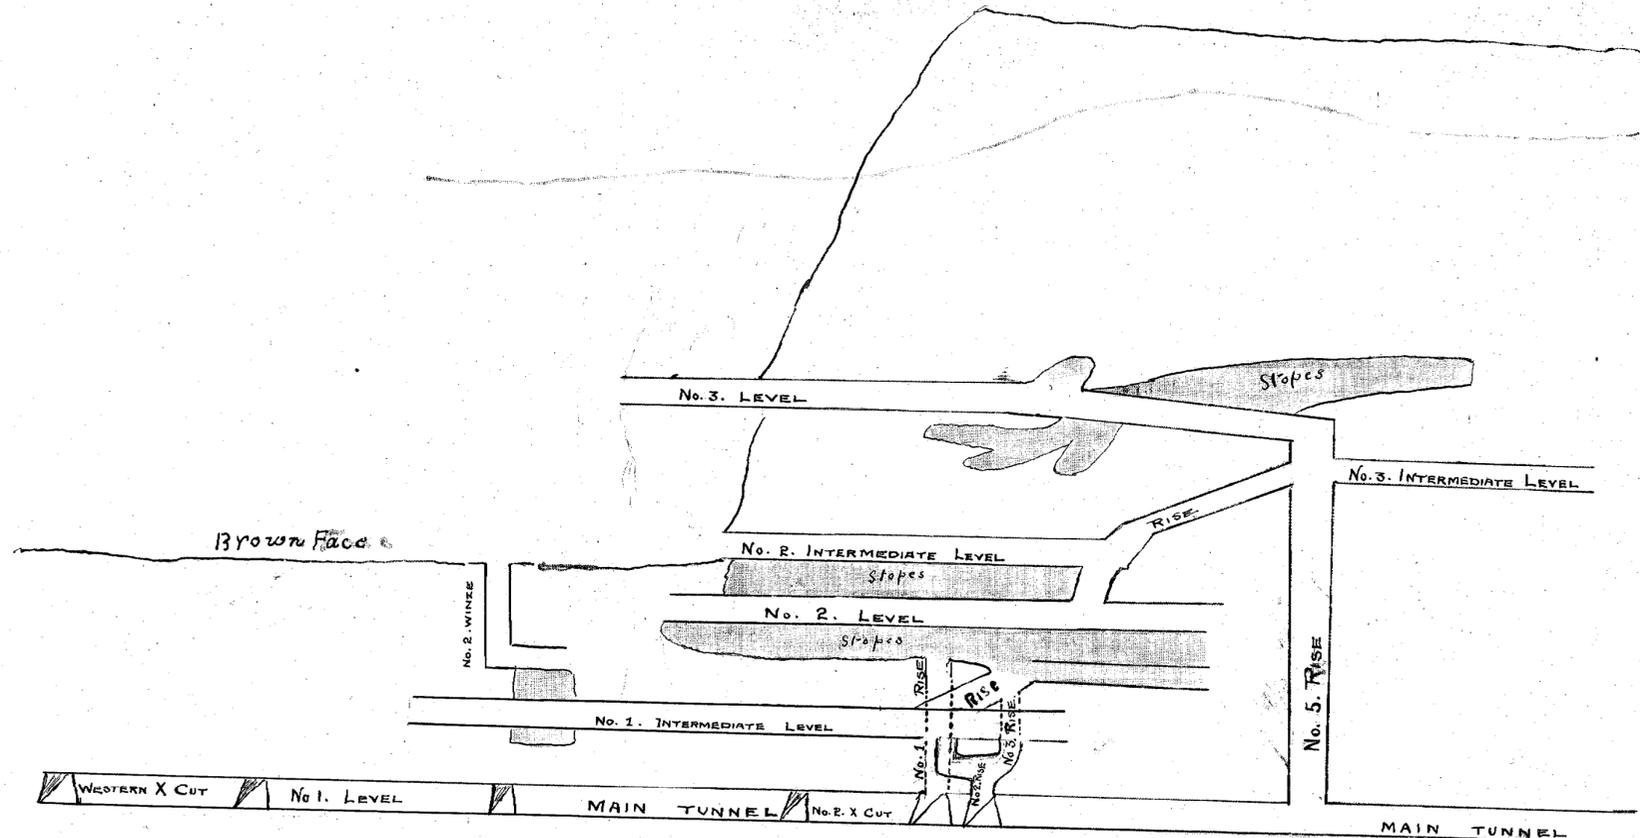

LONGITUDINAL SECTION