


— Mt. Bischoff T. No. 12 Reg. —

— **BROWN FACE** —

— LONGITUDINAL SECTION —

— Scale: 25 Ft to 1 Inch —

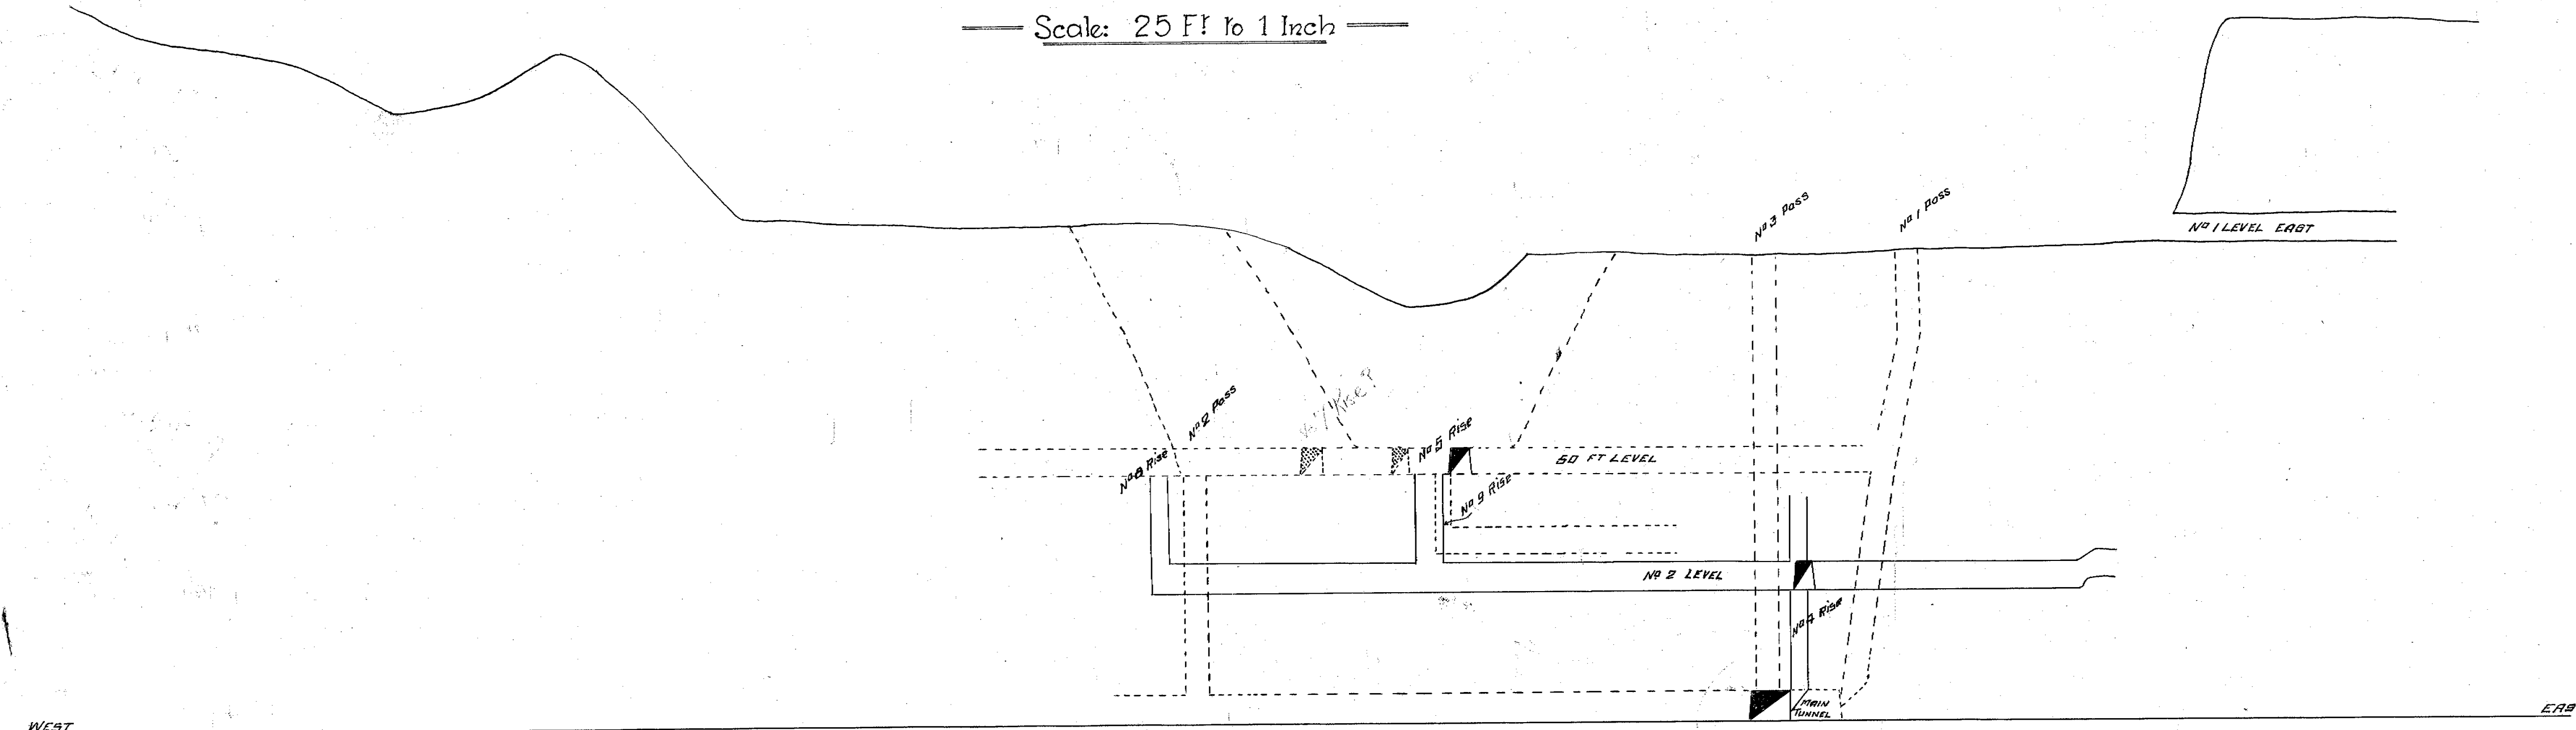

217-149

5 cm

217-149

Honolulu,  
Hawaii  
14-3-22