

217-50

217-50

5 cm


Work 1933  
Surveyor W. H. P. [unclear]  
Instrument used 5" theodolite

2100N

2000N

1900N

1800N

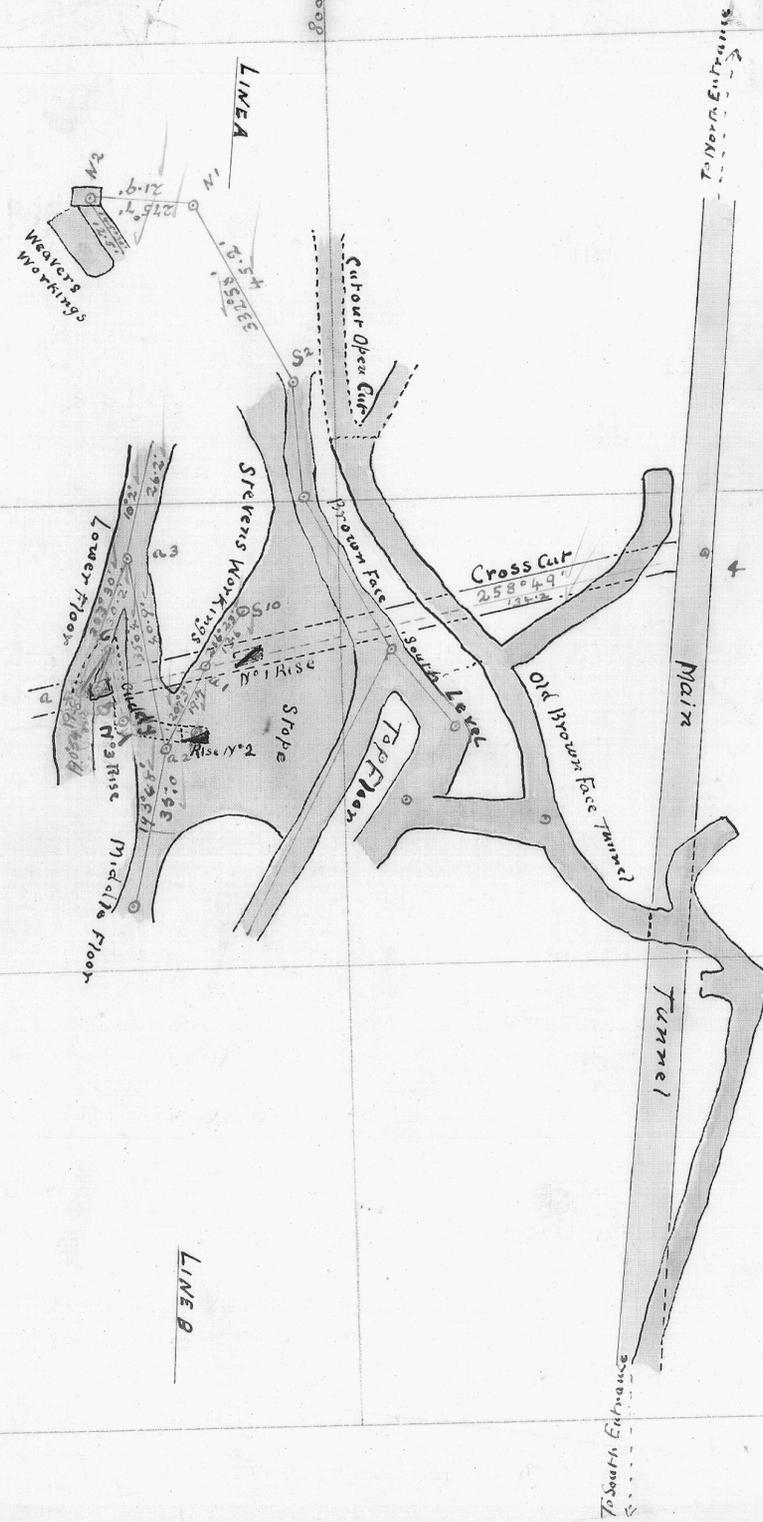

— MT BISCHOFF T. M. CO REG. —

— **BROWN FACE SOUTH LODE** —

— SCALE 25 FT TO 1 INCH —

*Ev. [unclear]*  
25/6/24