

217-51

5 cm


217-51

— MT BISCHOFF T.M.CO.REG —

— BROWNFACE SOUTHLODE —

SCALE 25 FT TO 1 INCH

2200 N
2100 N
2000 N
1900 N
1800 N
M 000 W
800 W
700 W
600 W

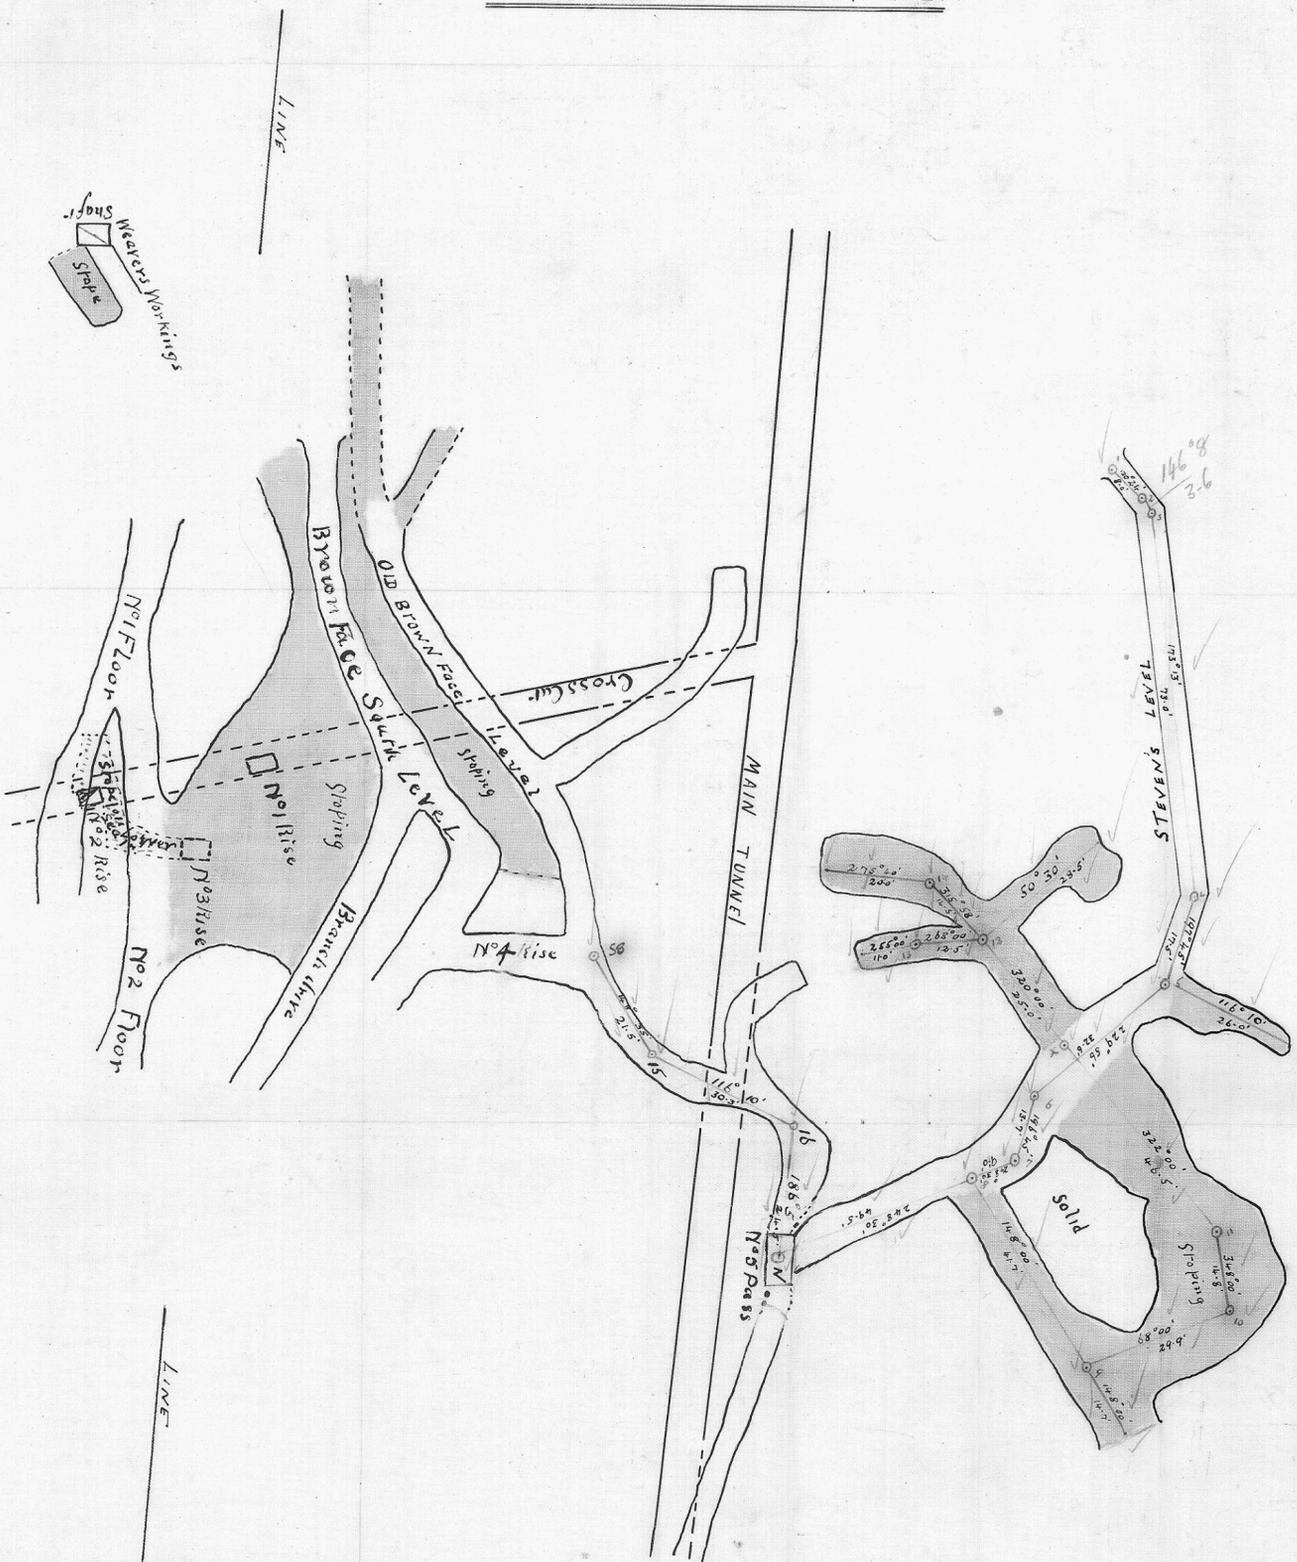

End of 11/8/35

*Work 1934
Surveyor M.D. etc.
Just used 5" theodolite and compass*