

956th Bischoff L. 956. Co Reg.

BROWN FACE SOUTH LODE


217-52

LONGITUDINAL SECTION


SCALE 25 FT TO 1 INCH

5 cm

217-52

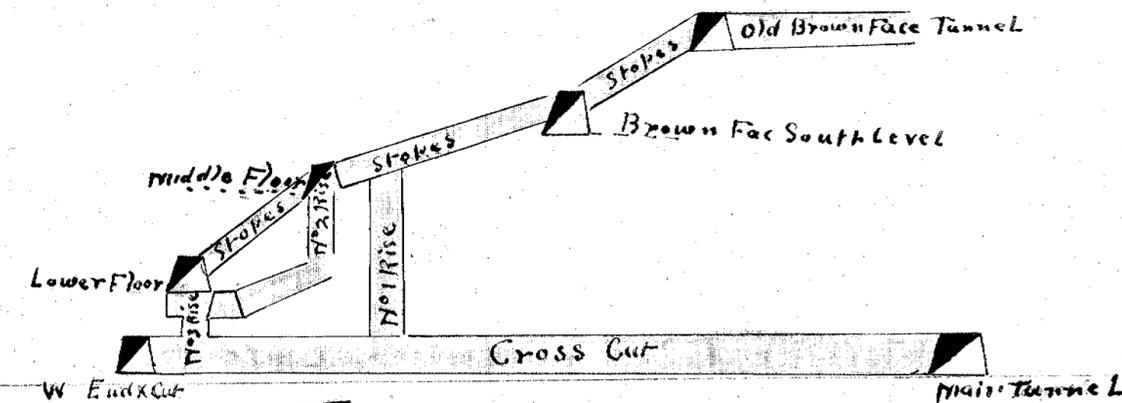

Transverse Section

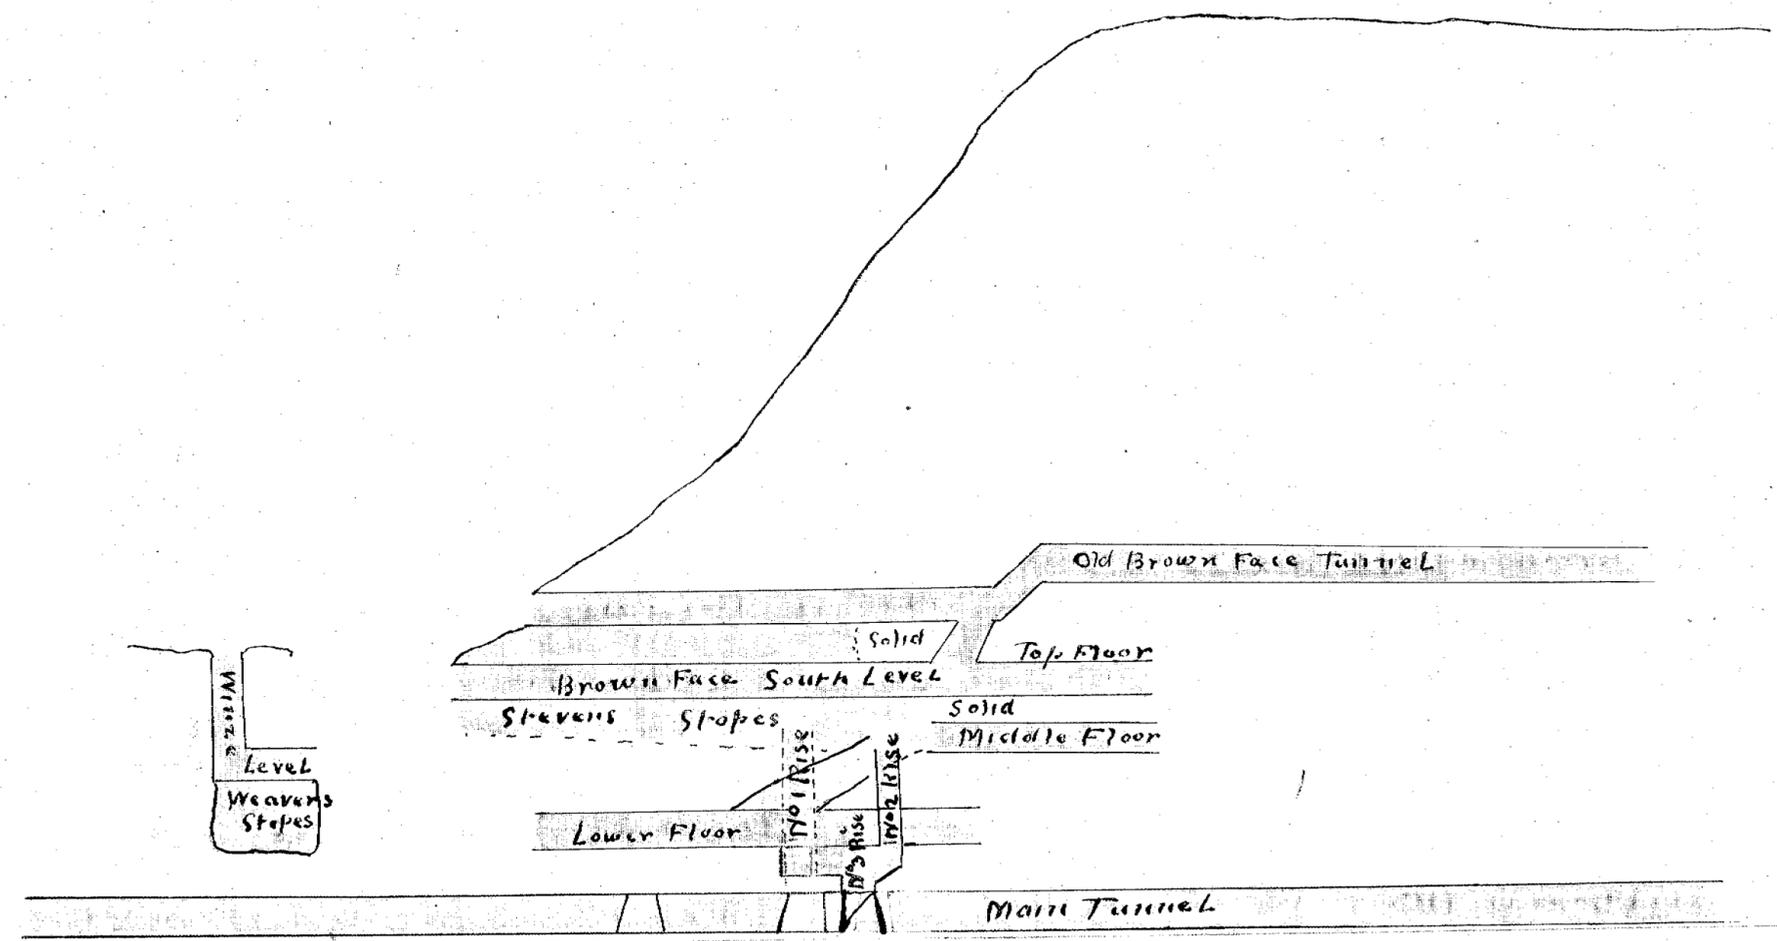

Work 1933
Surveyor W. G. Dorte
Instrument used 5" theodolite