


— MT BISCHOFF T. M. CO. REG. —

— **BROWN FACE** —

— **TRANSVERSE SECTION** —

— Scale: 25 Feet to 1 Inch —

*Additions to St. 12-23
Mt. Bischoff
7-14-24*

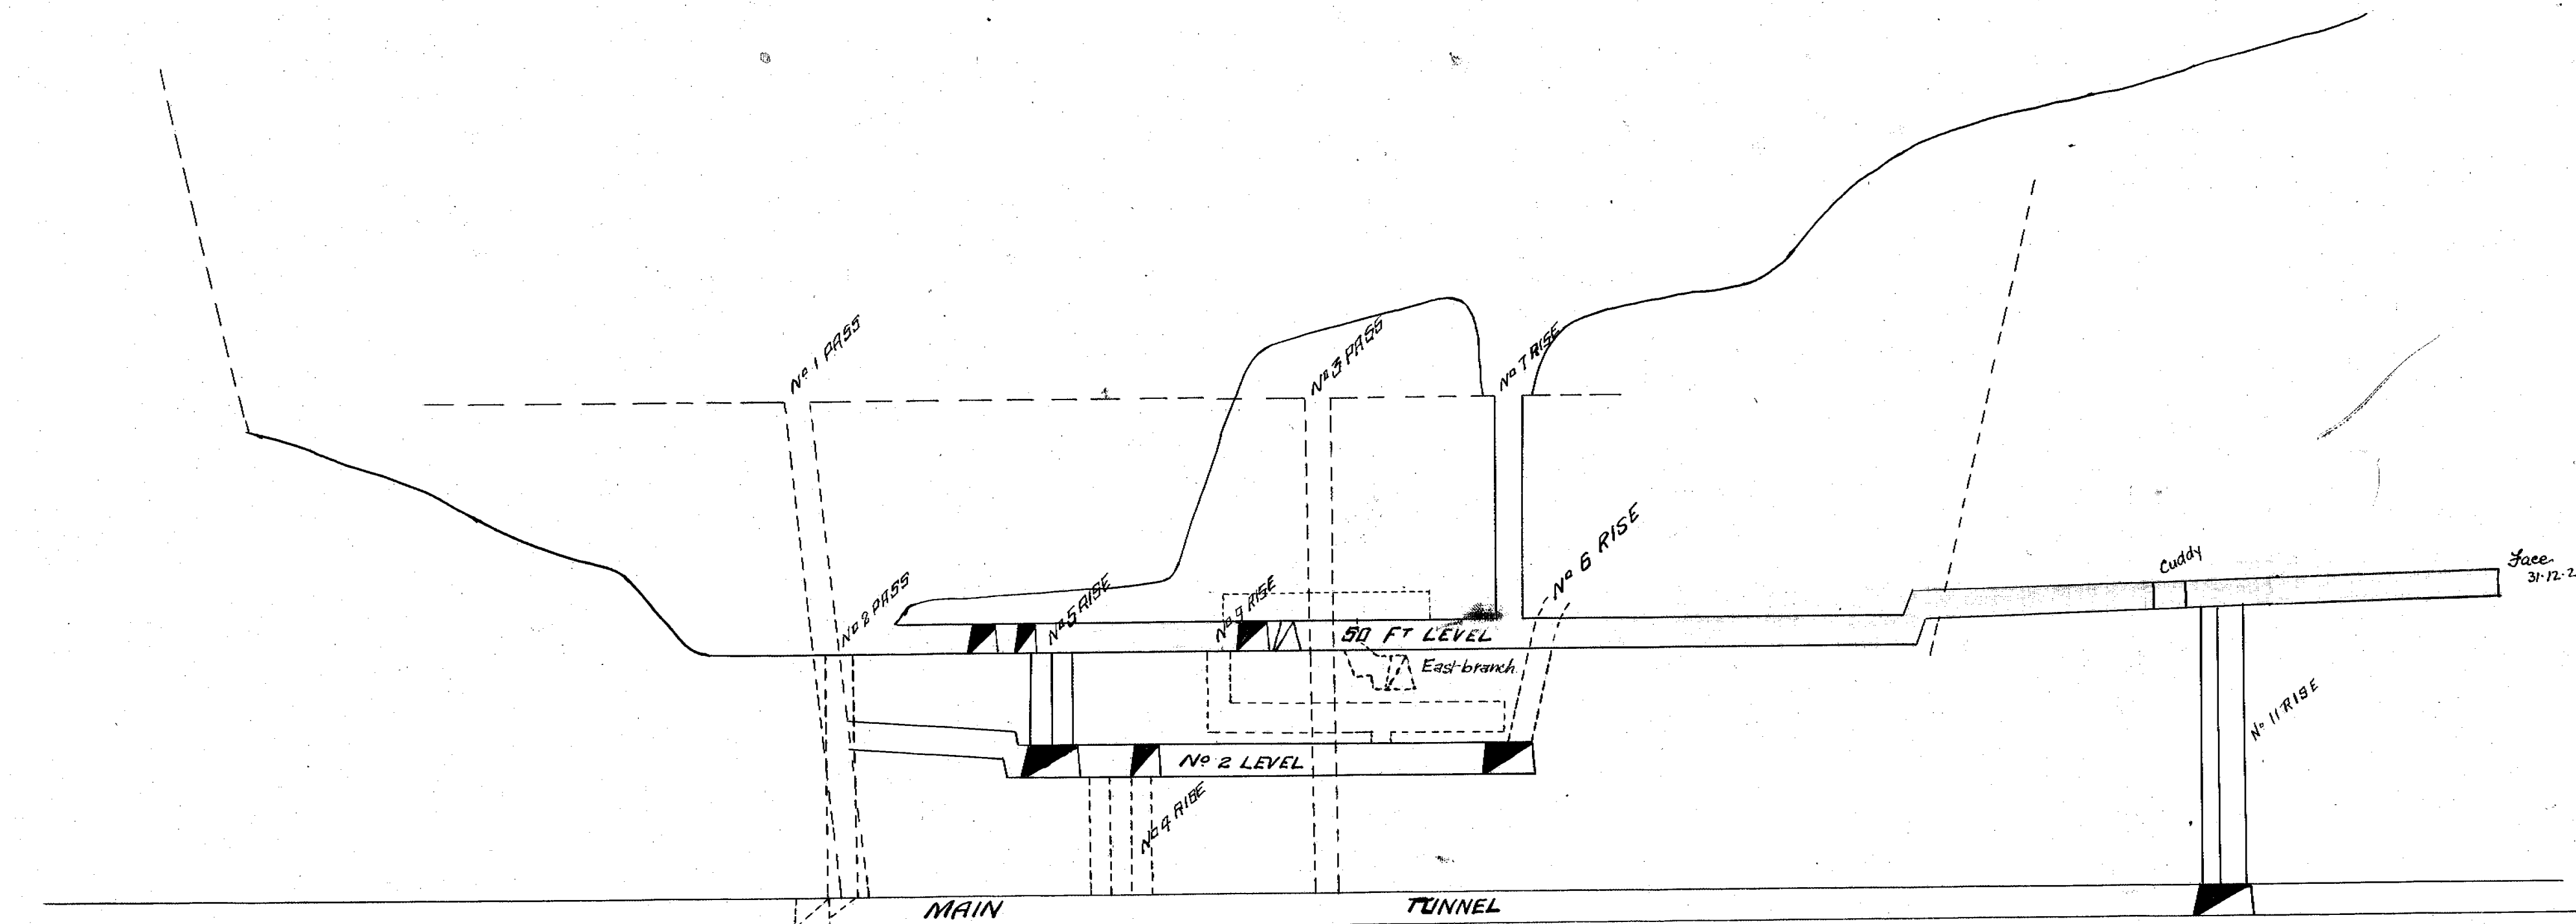

5 cm

*Stonerville
Mine Surveyor
22-3-23*

*BB
14-9-23*

217-53

217-53