


217-54

— MT BISCHOFF T.M.CO.REG —

— WHEAL WORKINGS —

— SCALE 25 FT TO 1 INCH —

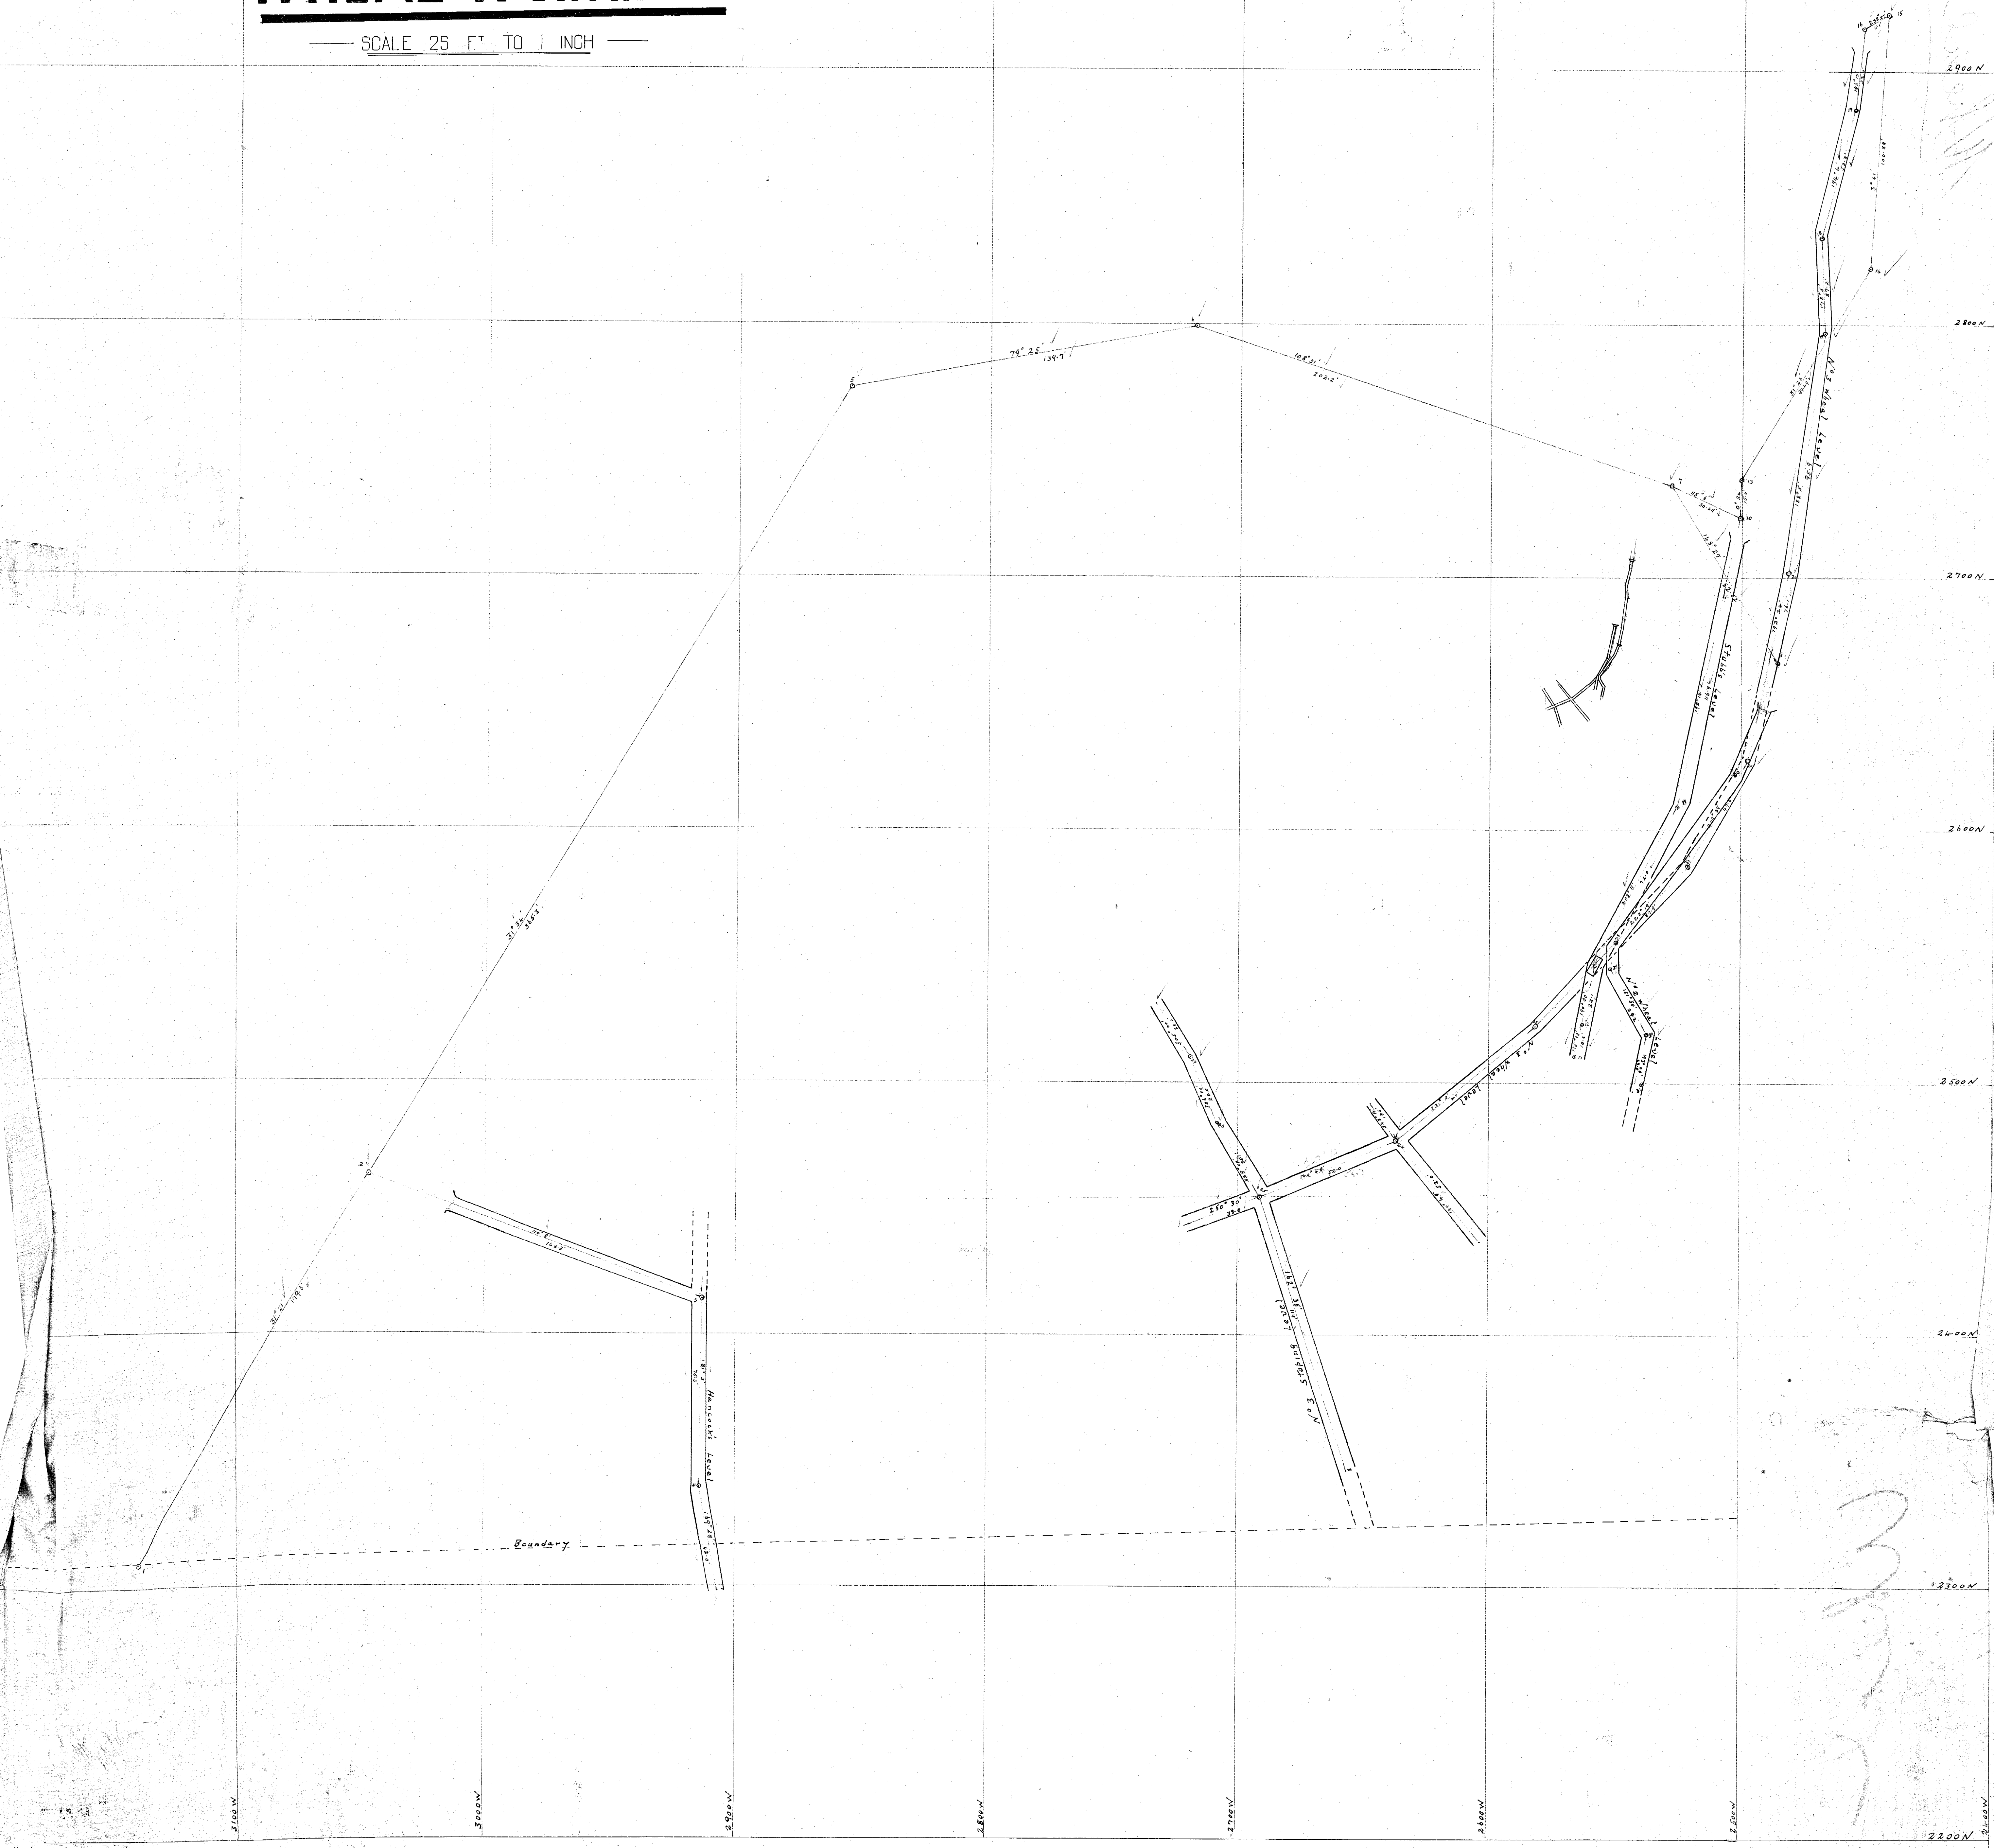

Feb 1934
 Surveyor W. D. Miller
 Met and 5th Thos and Compas