


2/2/94



Arthur B. Smith
4081 nat

217-59

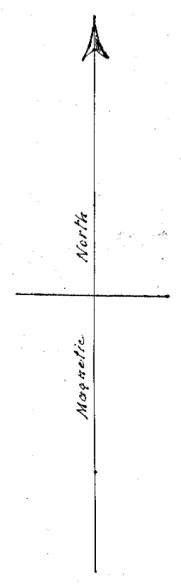


The Mount Bischoff T. M. Co

Scale 50 Feet to one Inch.

18 94

PLAN

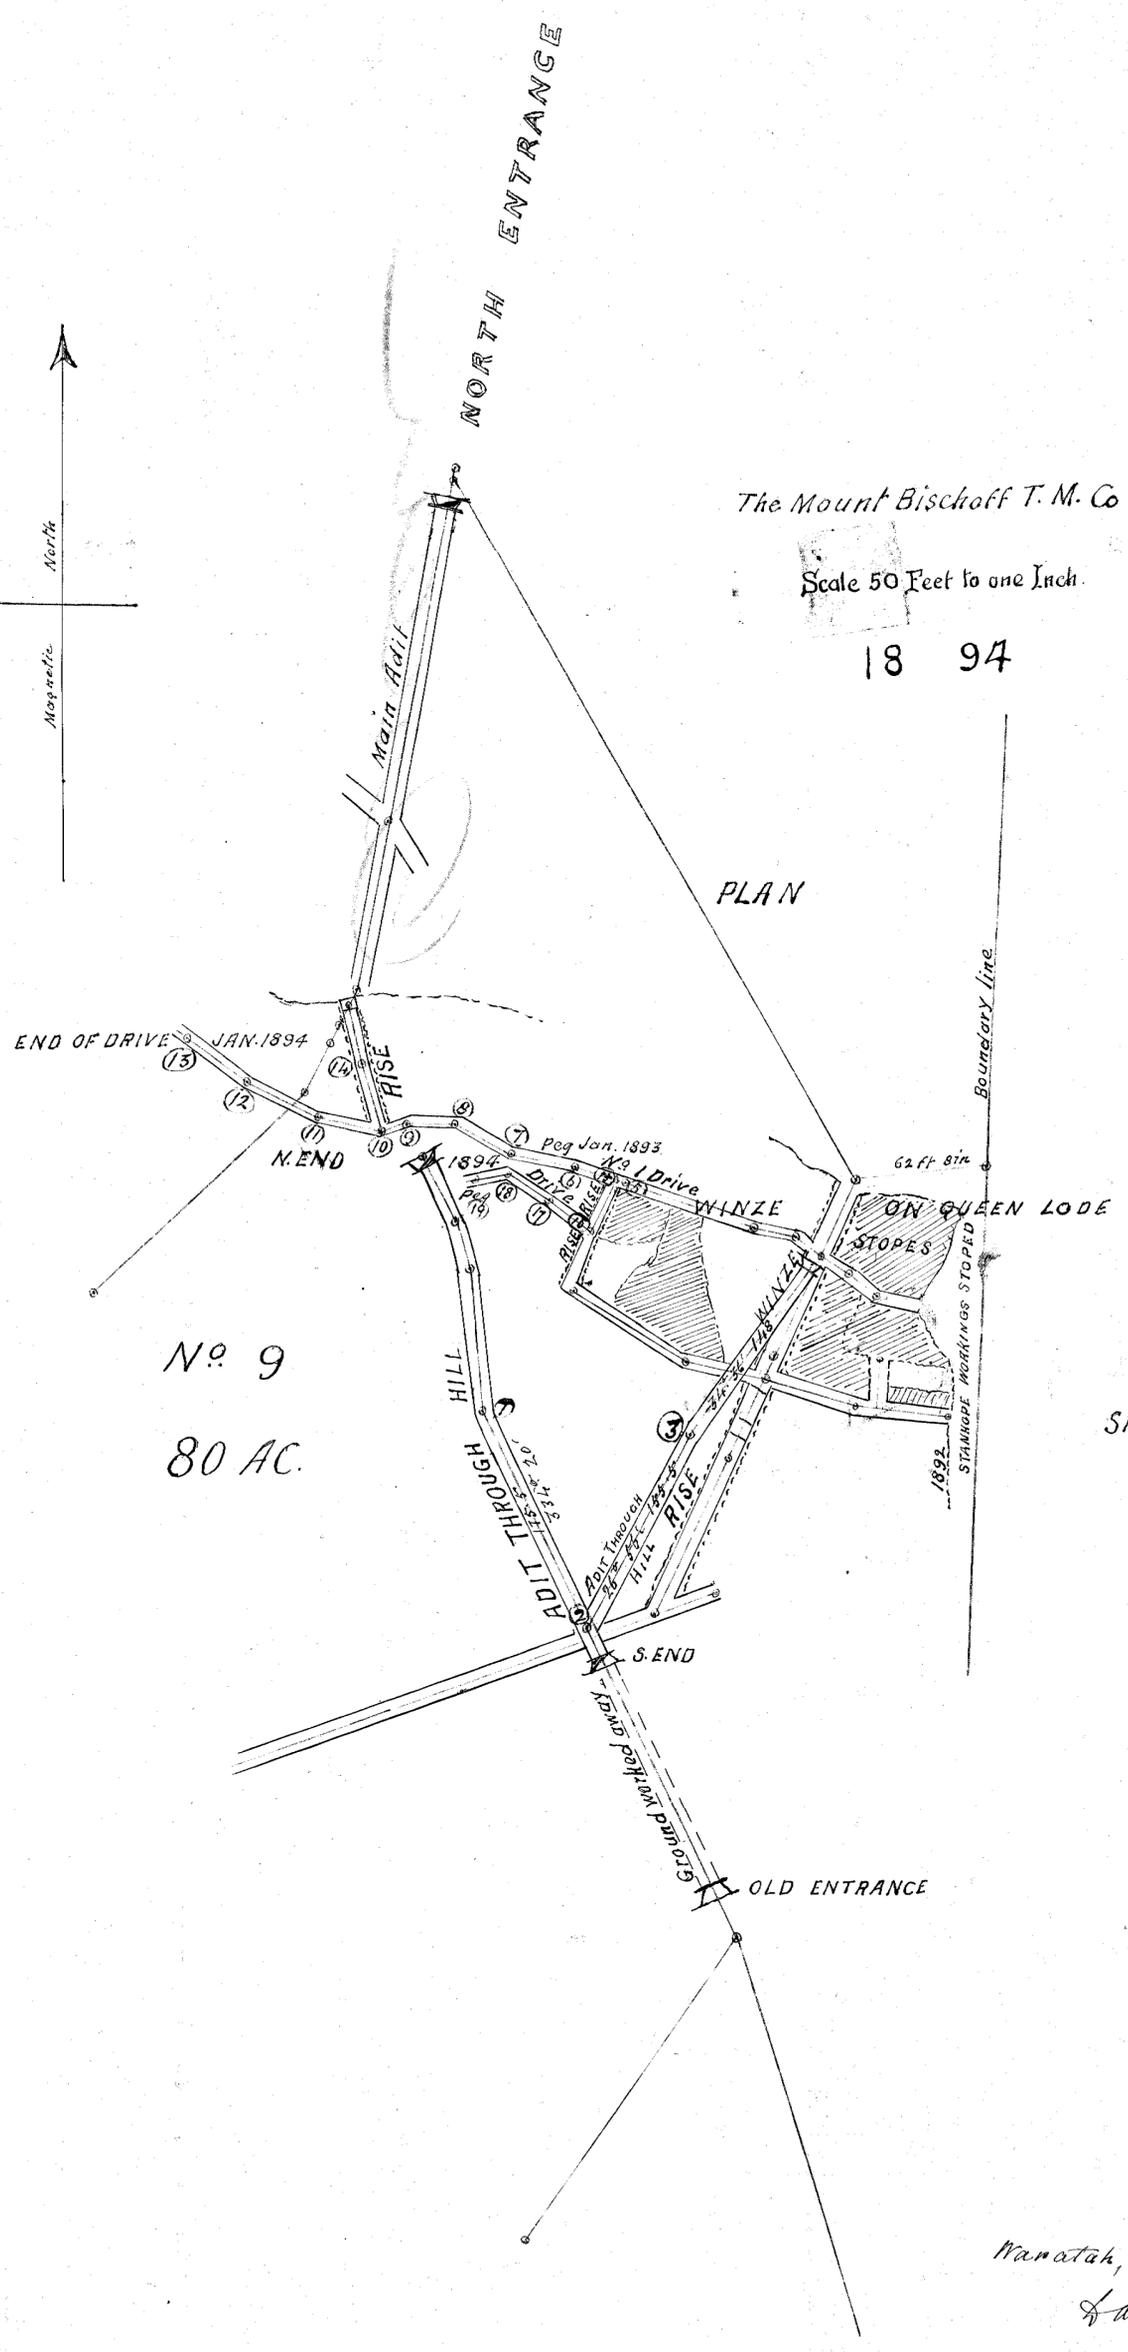

No 9
80 AC.

No 36 80 AC.

Stanhope T. M. Co.



217-59

Nanatak, Jan. 29th 1894.

David Jones,
District Surveyor

Owner Prop

182