



Mount Bischoff
Jan 1893

Jan 1893
Mount Bischoff


217-60

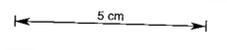

PLAN OF MT BISCHOFF T. M. COMPANY'S UNDERGROUND WORKS

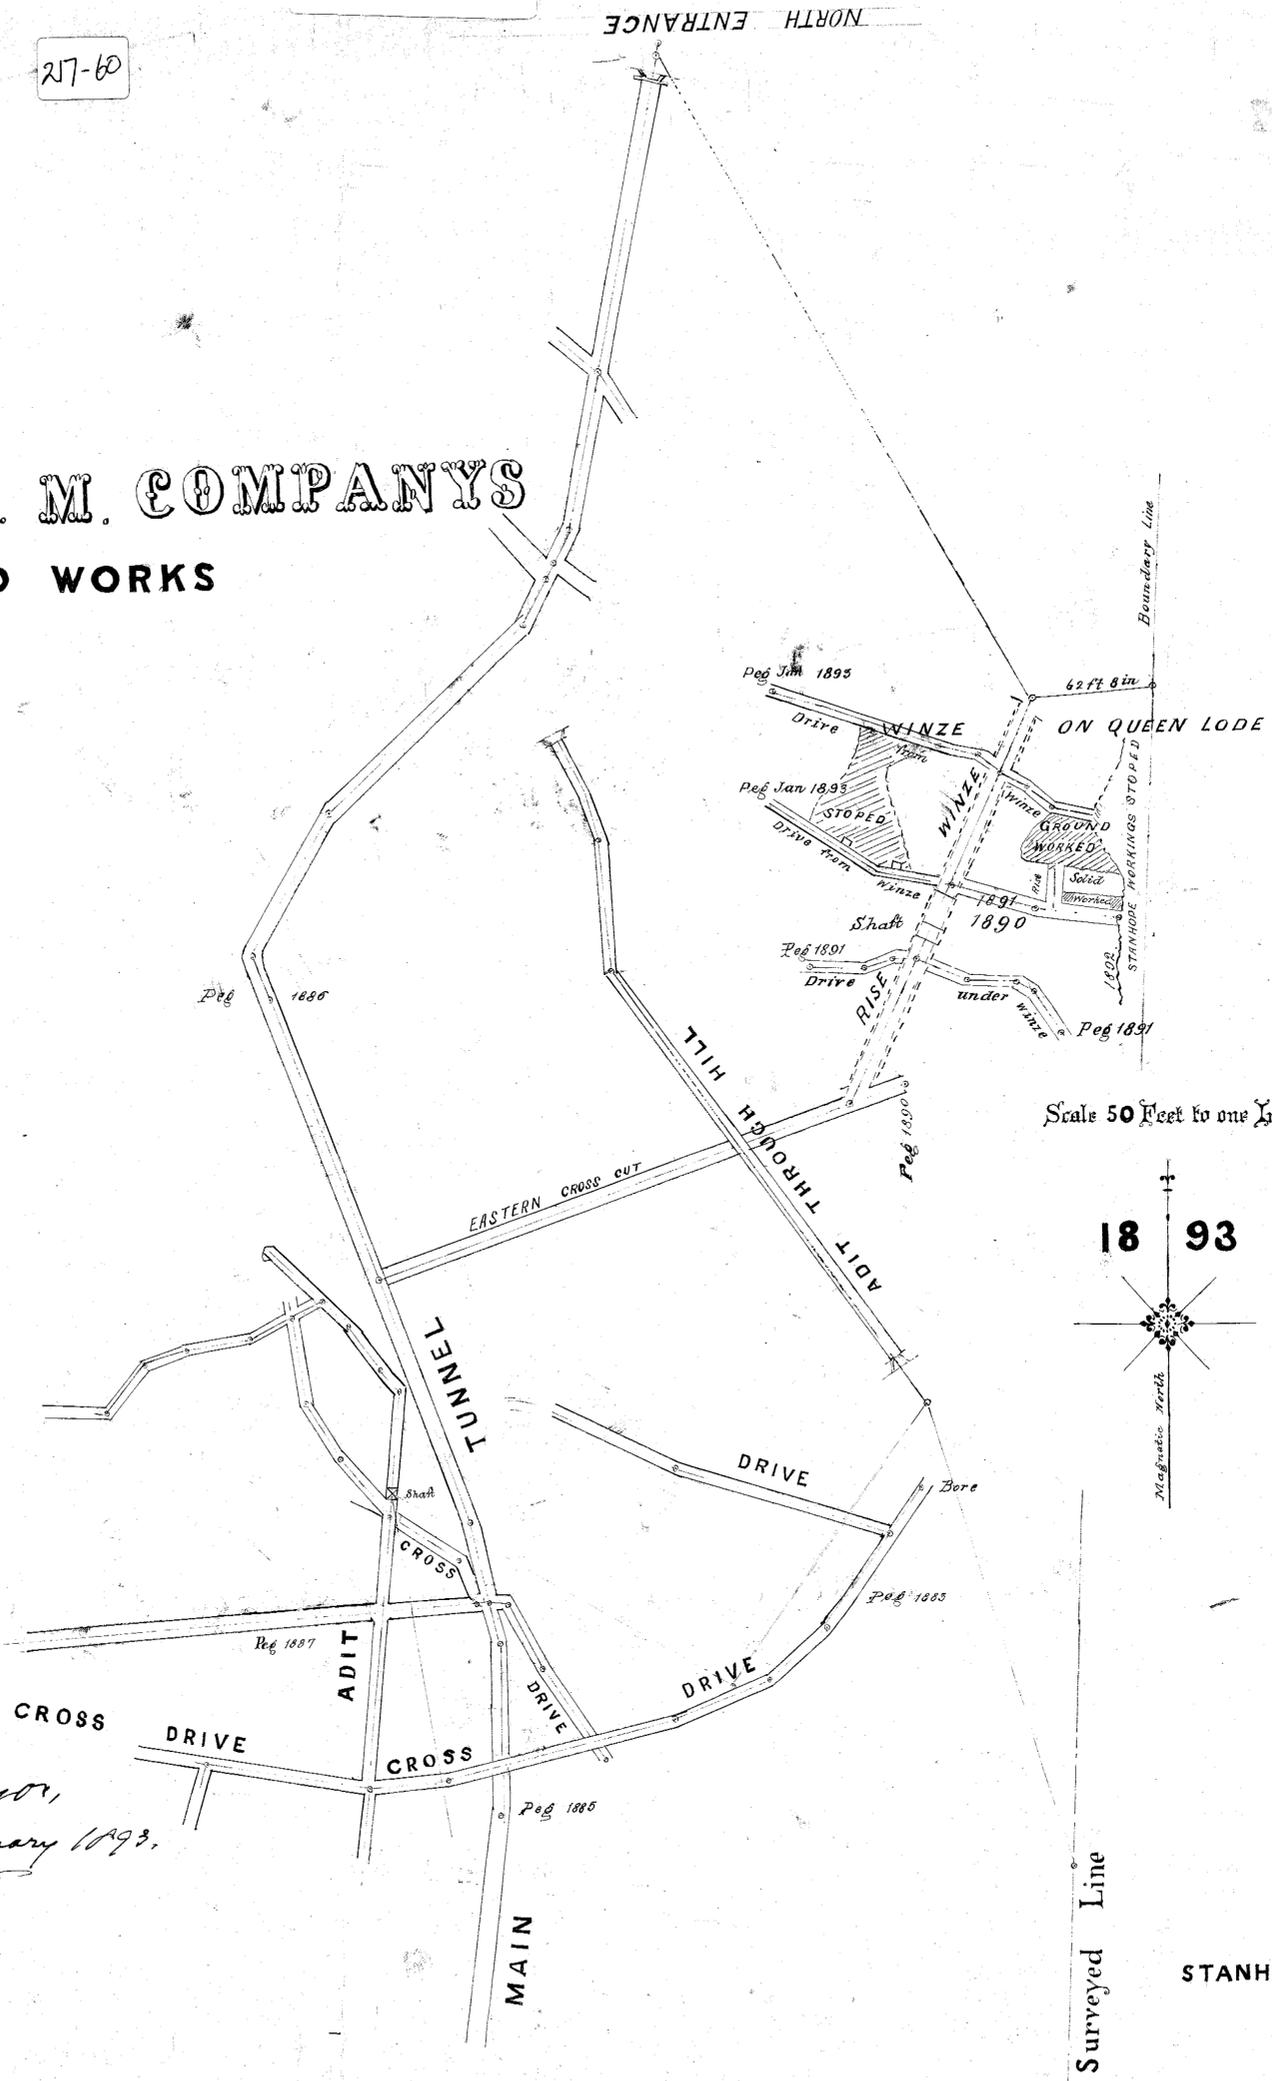

Scale 50 Feet to one Inch

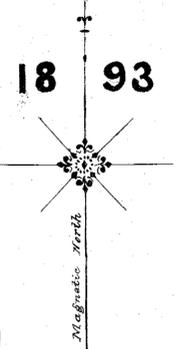

*David Jones,
District Surveyor,
Perth, January 1893.*

Surveyed Line

STANHOPE T. M. COMPANY