



217-63



Mt. BISCHOFF T. M. Co. Reg.

QUEEN = WORKINGS


UNDERGROUND WORKINGS TO DEC 31 1924.

SCALE 25 FT. TO 1 IN.

W. H. M. Co. Surveyor

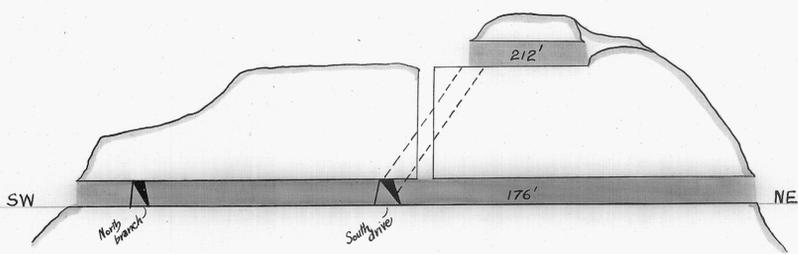
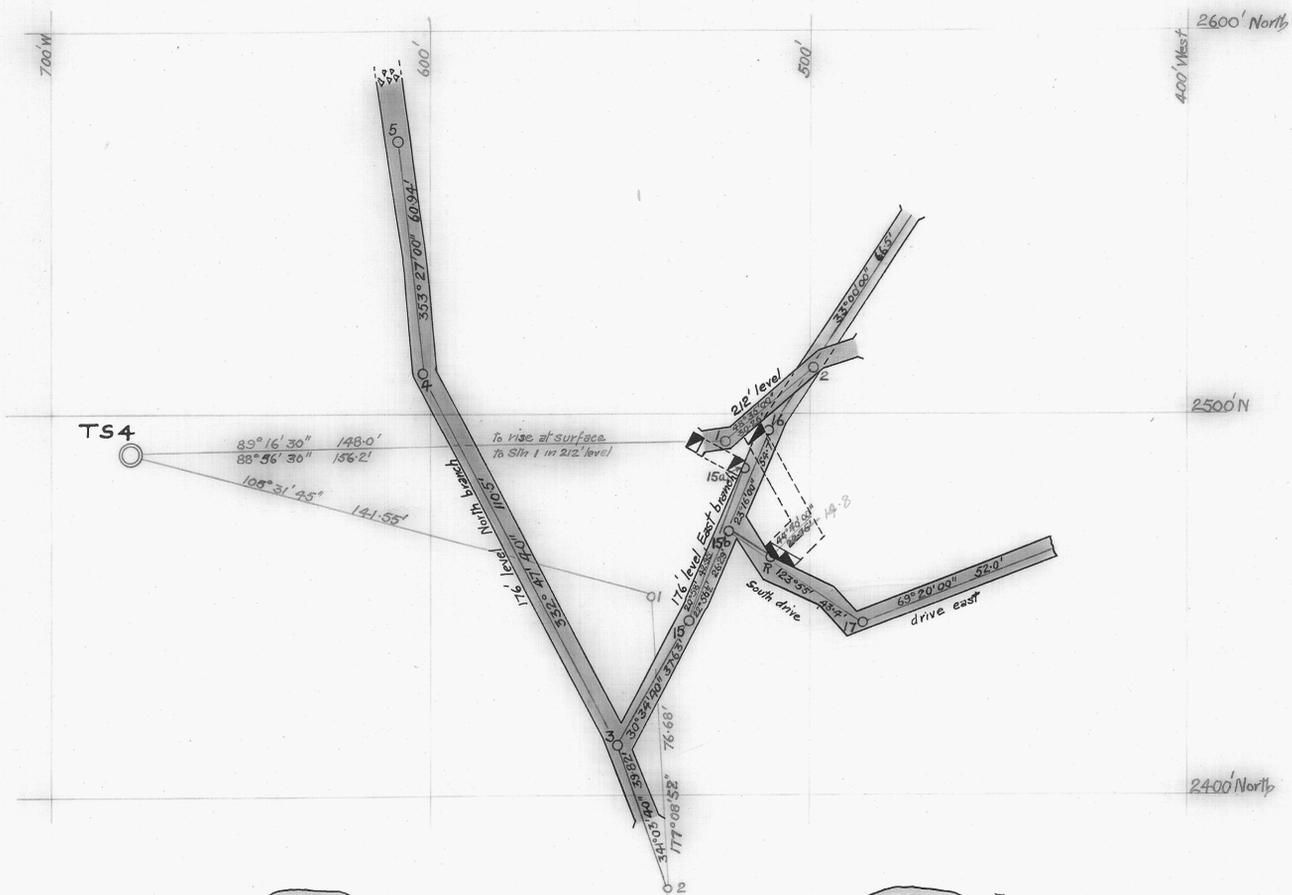


LONGITUDINAL SECTION

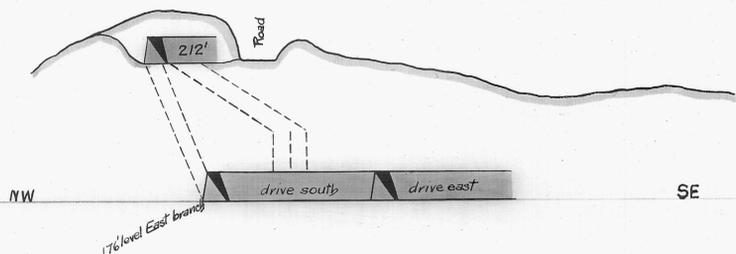


TRANSVERSE SECTION

HAPPY LODGE

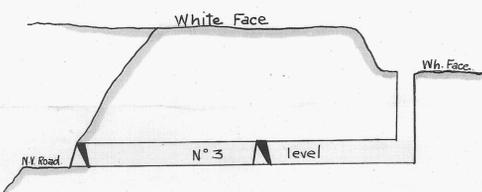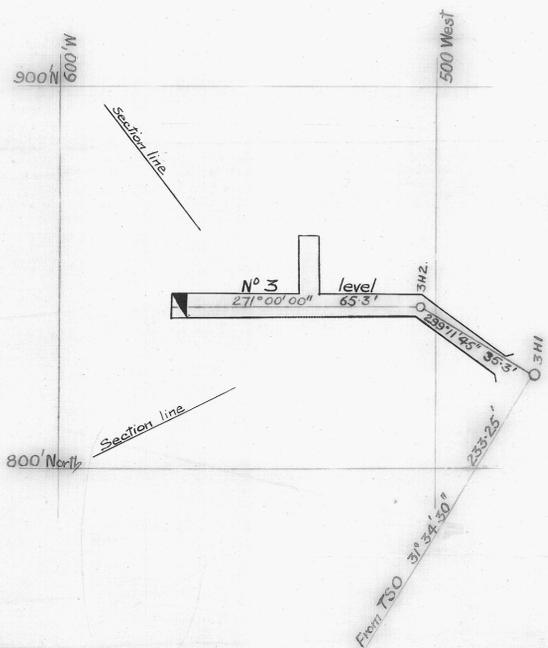

LONGITUDINAL SECTION

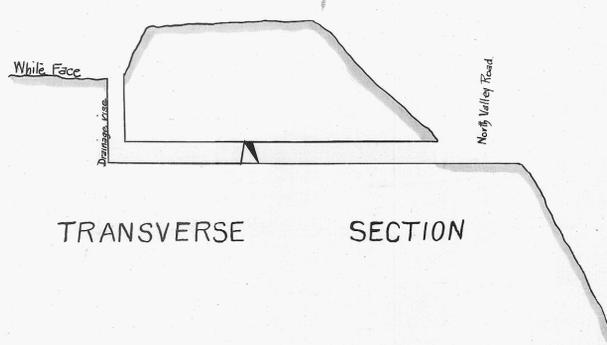

TRANSVERSE SECTION