


217-67

5 cm

217-67

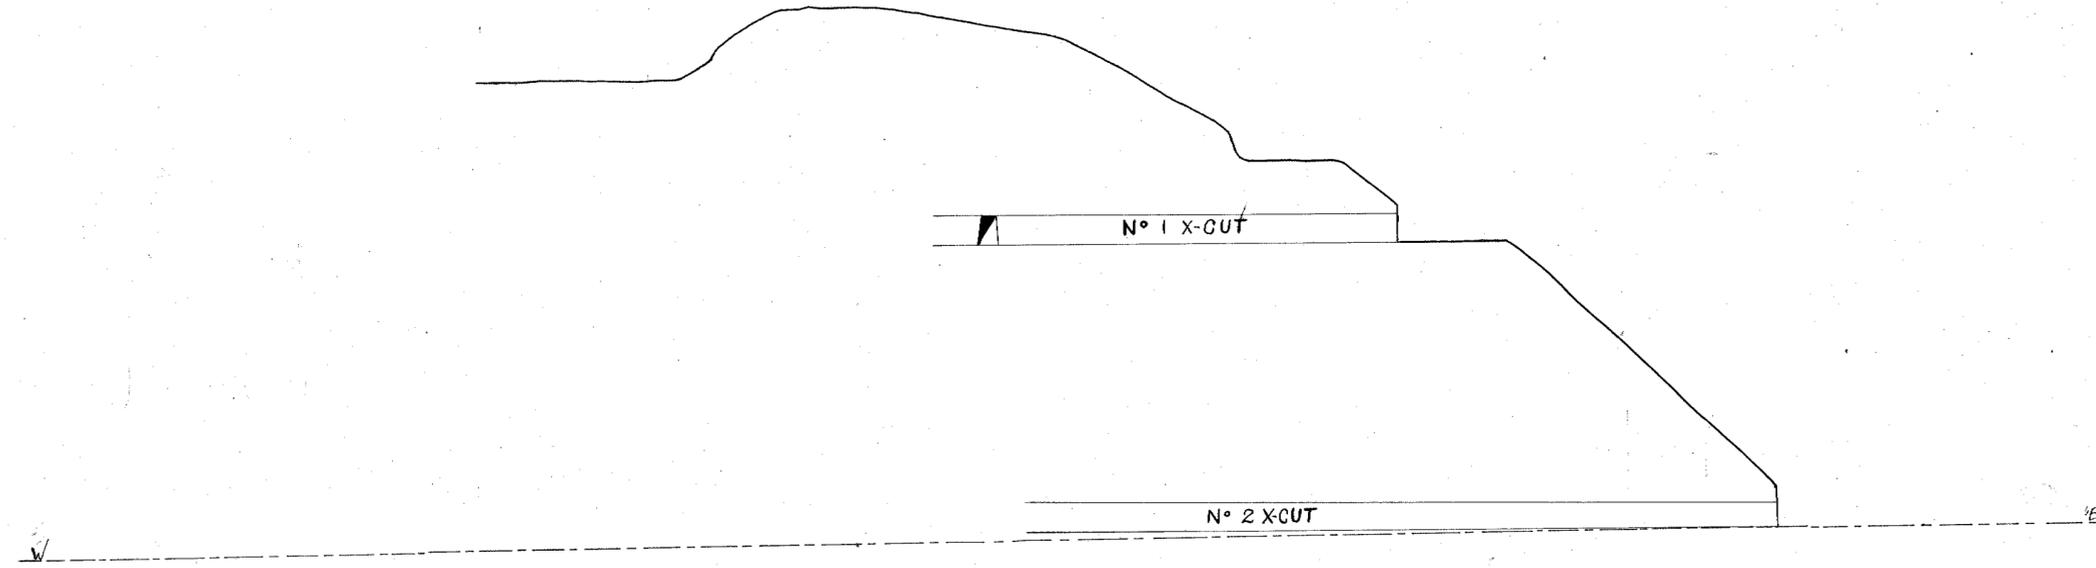

— MT BISCHOFF T. M. CO. REG. —

— HAPPY LODGE —

— TRANSVERSE SECTION —

— SCALE 25 FT TO 1 INCH —

Handwritten notes:
 as shown
 for plan to go
 16-9-73
 [Signature]