


Mt. BISCHOFF T. M. Co. Reg.

HAPPY LODE


UNDERGROUND WORKINGS TO DEC. 31 1923.

*Mt. Bischoff
Company Summary
25-2-24.*

SCALE 25 FT. TO 1 IN.

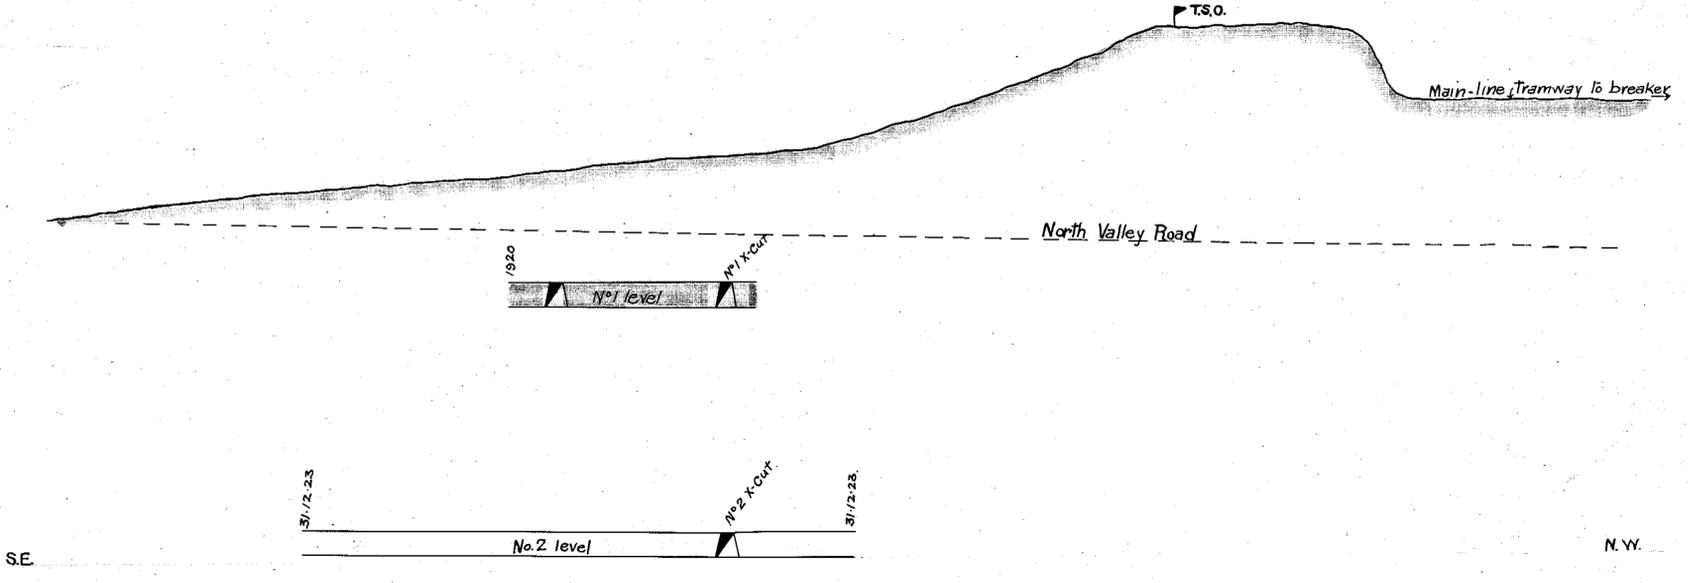

LONGITUDINAL SECTION

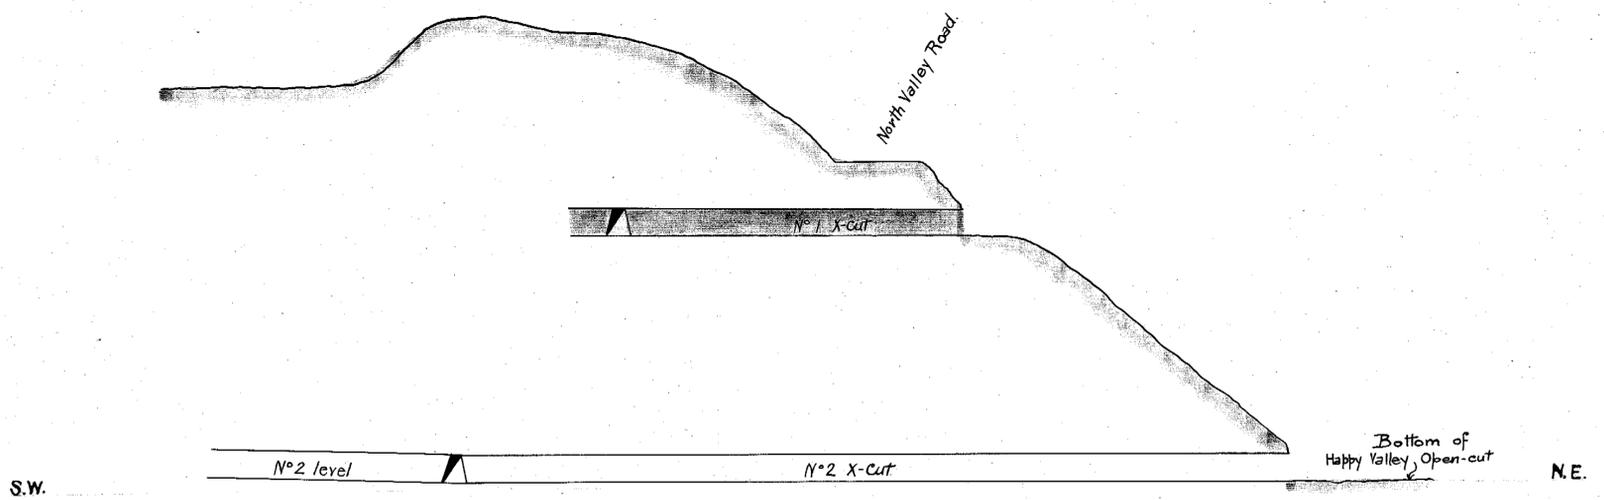

TRANSVERSE SECTION

Handwritten notes at bottom left.

Handwritten notes at bottom right.