


1929.

MT. BISCHOFF T.M.C. REG.

NEW ENTRANCE HAPPY NO. 1 LEVEL.

SCALE 25 FT = 1 IN.

217-69

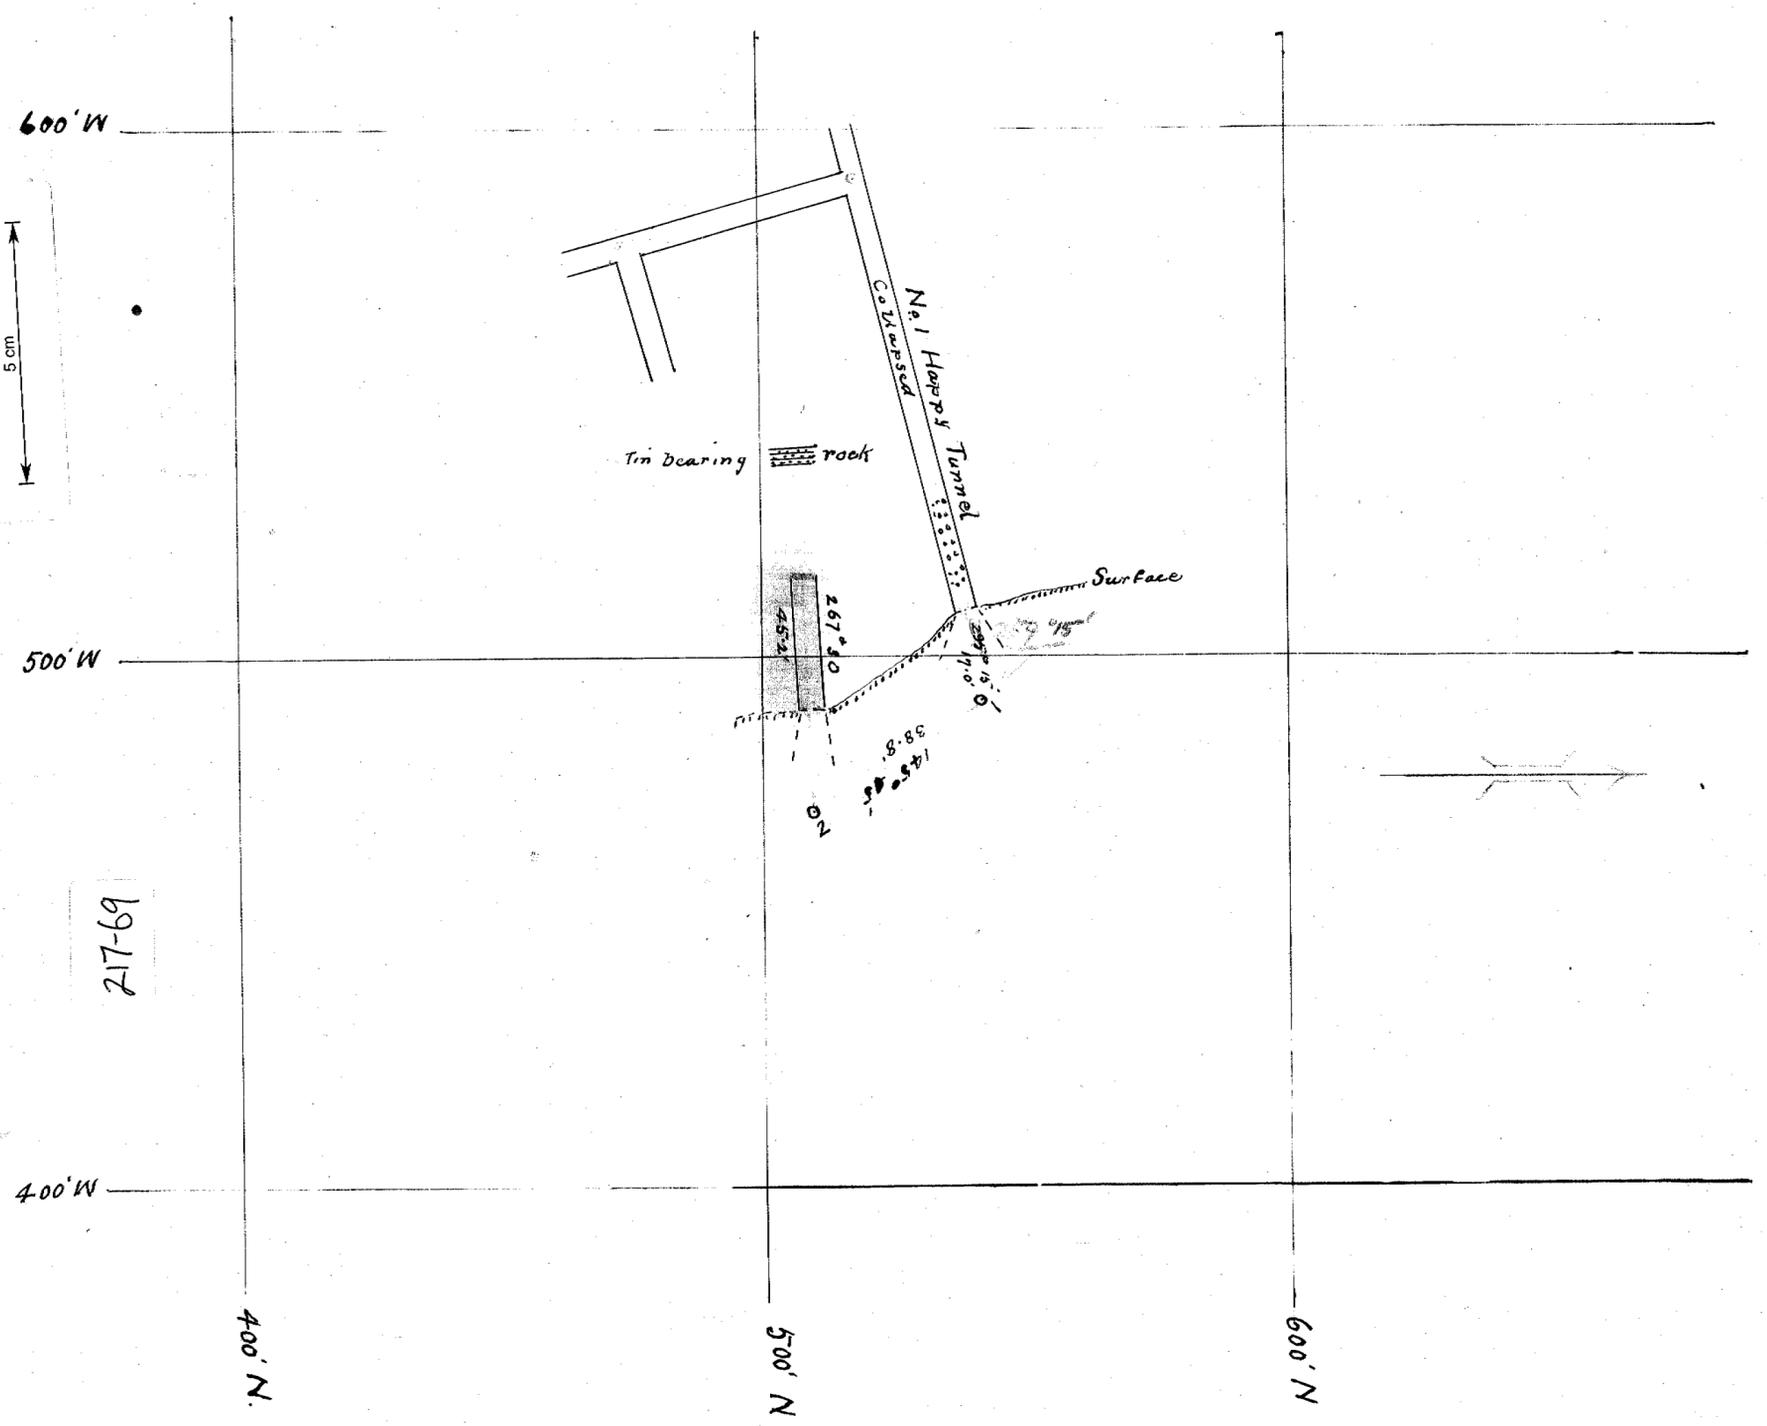

217-69

J. H. Lavings
Surveyor.

E.H.
17-5-30