



*Happy Valley*

217-70

Section


Mt. BISCHOFF T. M. Co. Reg.

# HAPPY LODE

UNDERGROUND WORKINGS TO DEC. 31 1923.

SCALE 25 FT. TO 1 IN.

*W. K. Jacobs  
Boundary Surveyor  
25.2.24.*

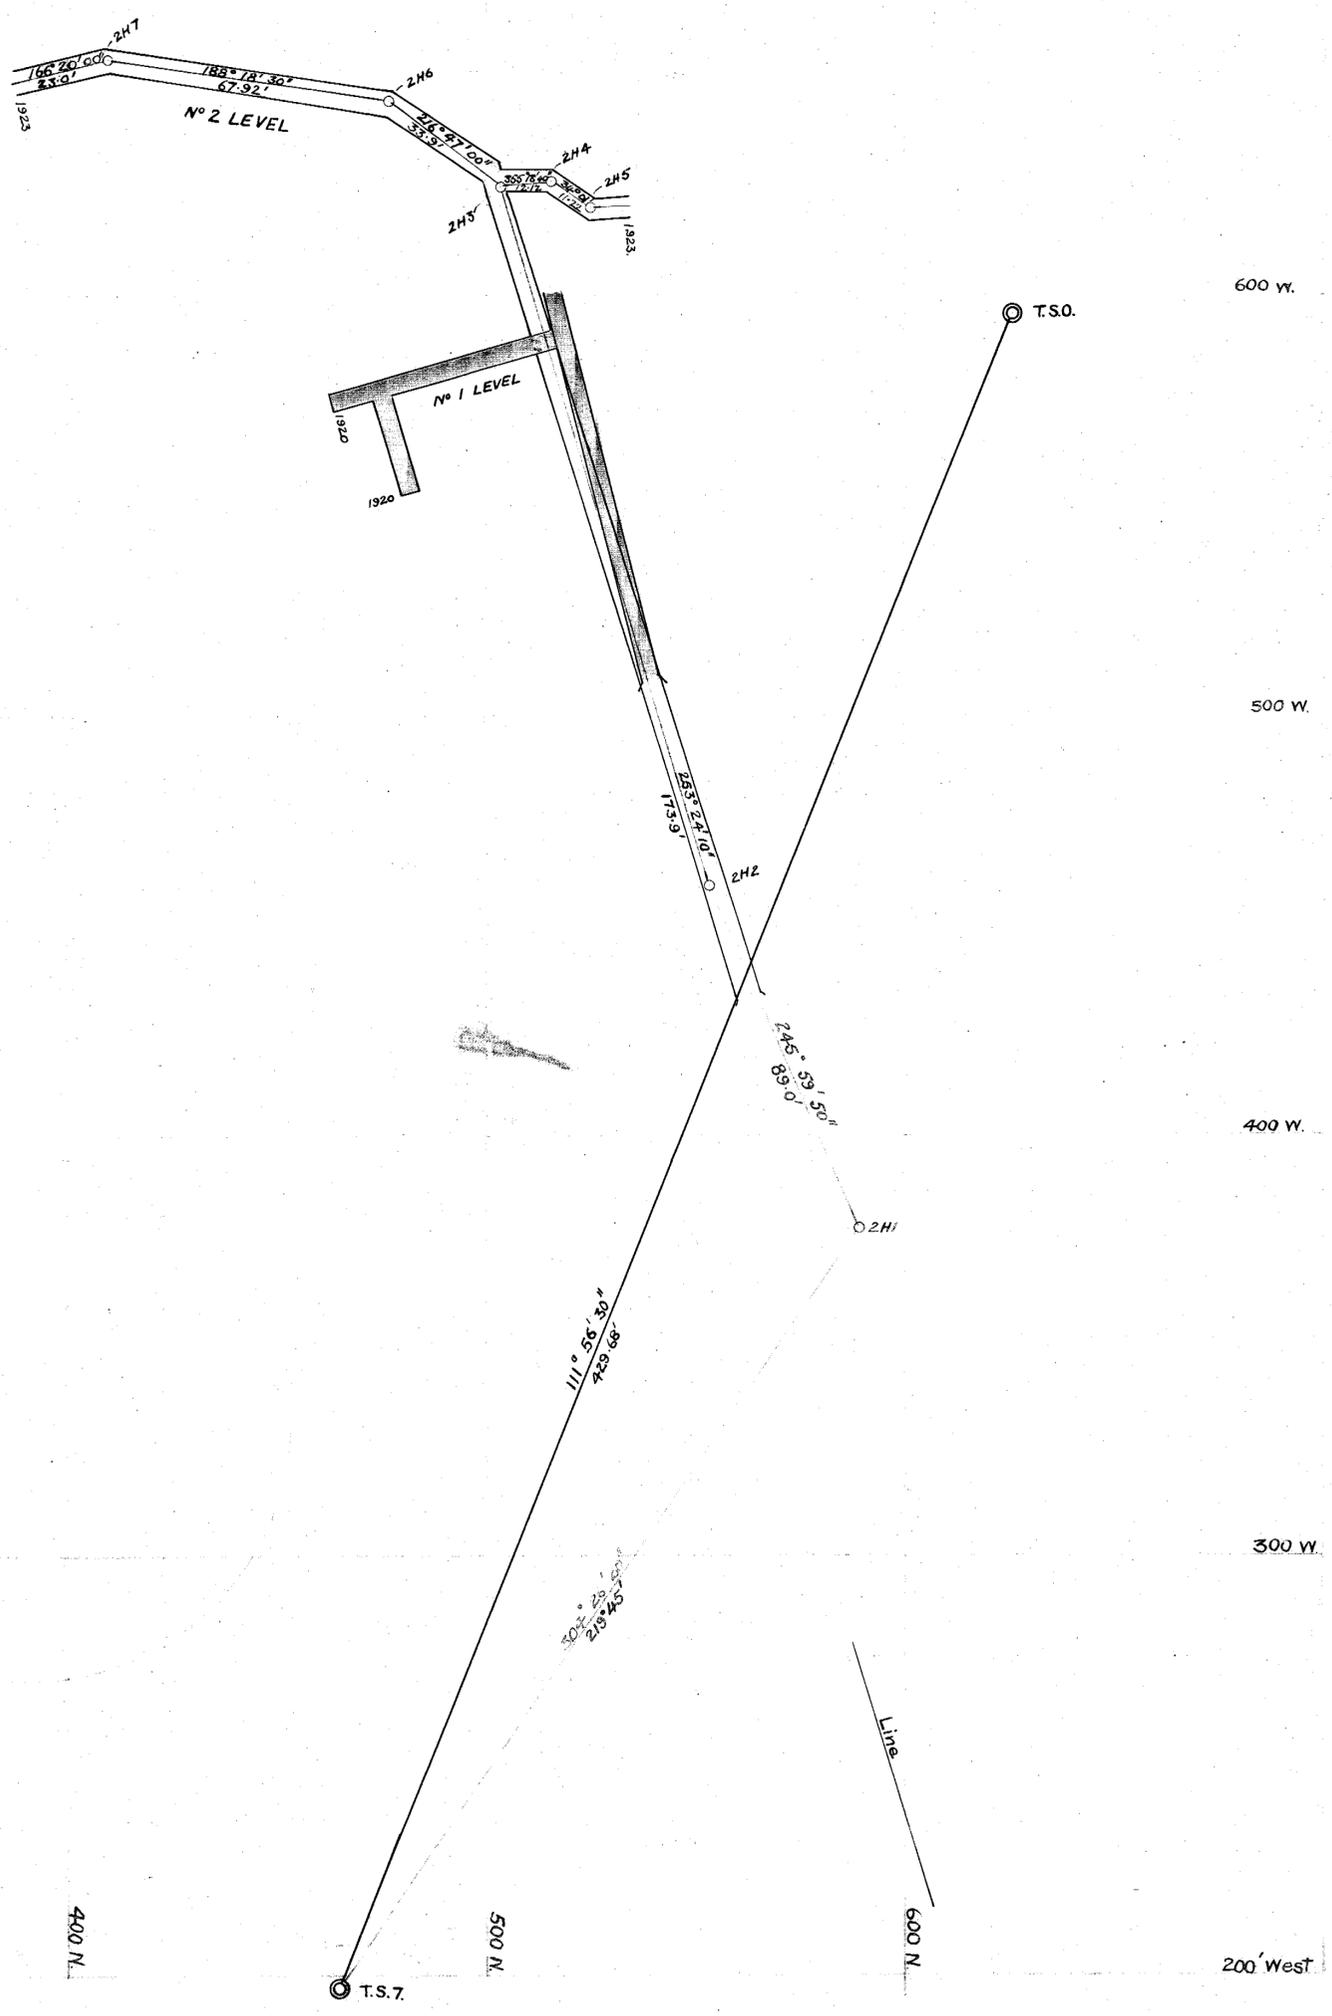

300' North

400 N.

500 N.

600 N.

200' West

T.S.7

T.S.0