


— MT BISCHOFF T. M. CO. REG. —


— HAPPY LODE —

— SCALE 25 FT TO 1 INCH —



217-71

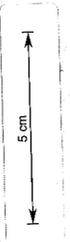

217-71

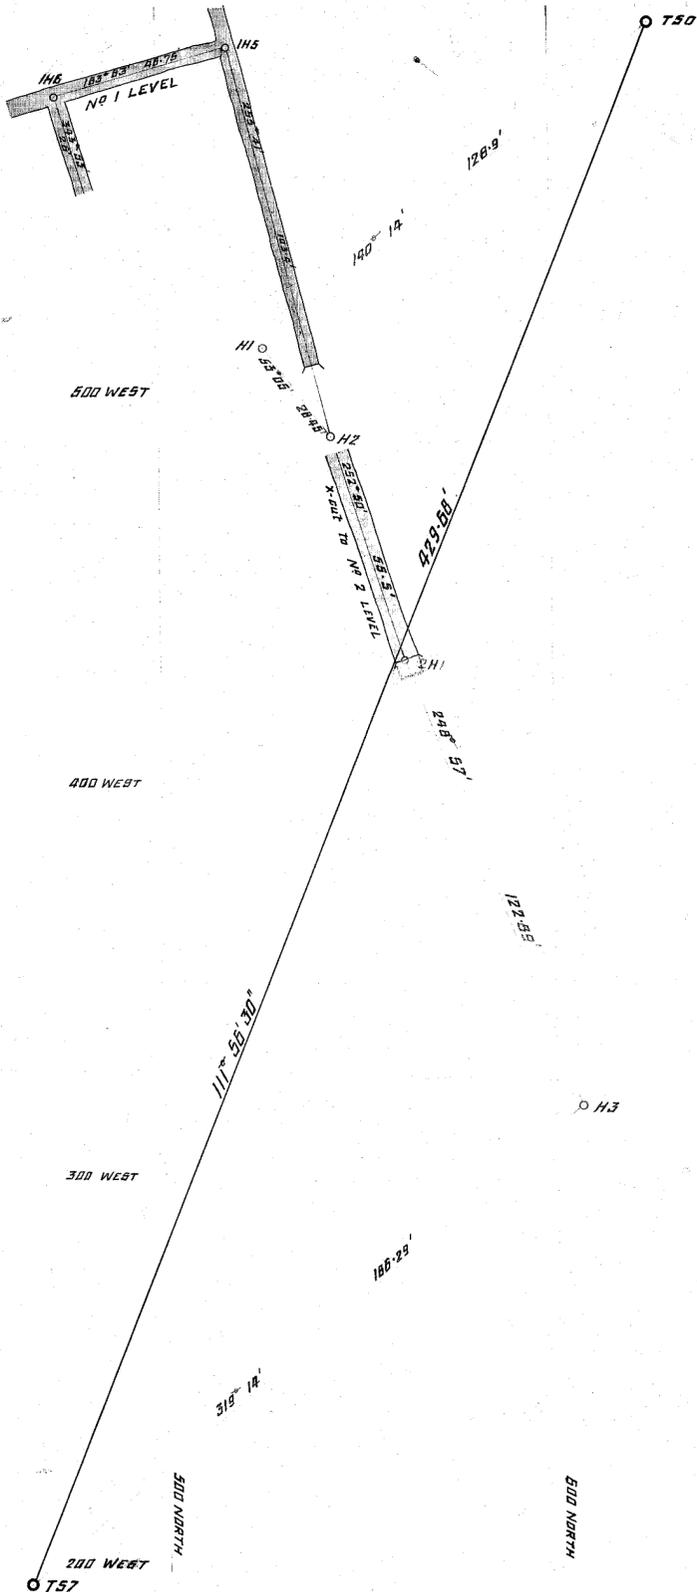

— PLAN —

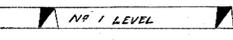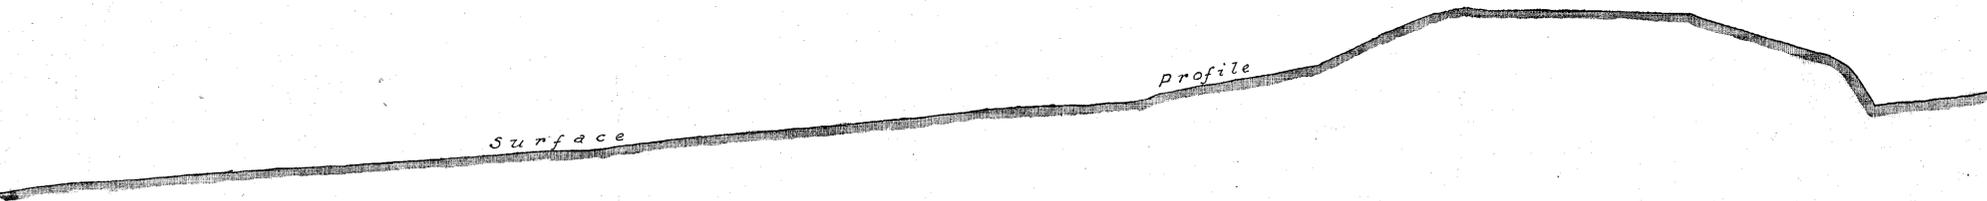

— LONGITUDINAL

SECTION —

Certified Correct Copy
Monerville
Mine Surveyor
Luigi W. ... General Mine Manager