


CROSS LODE

LONGITUDINAL SECTION

SCALE 25 FT TO 1 INCH

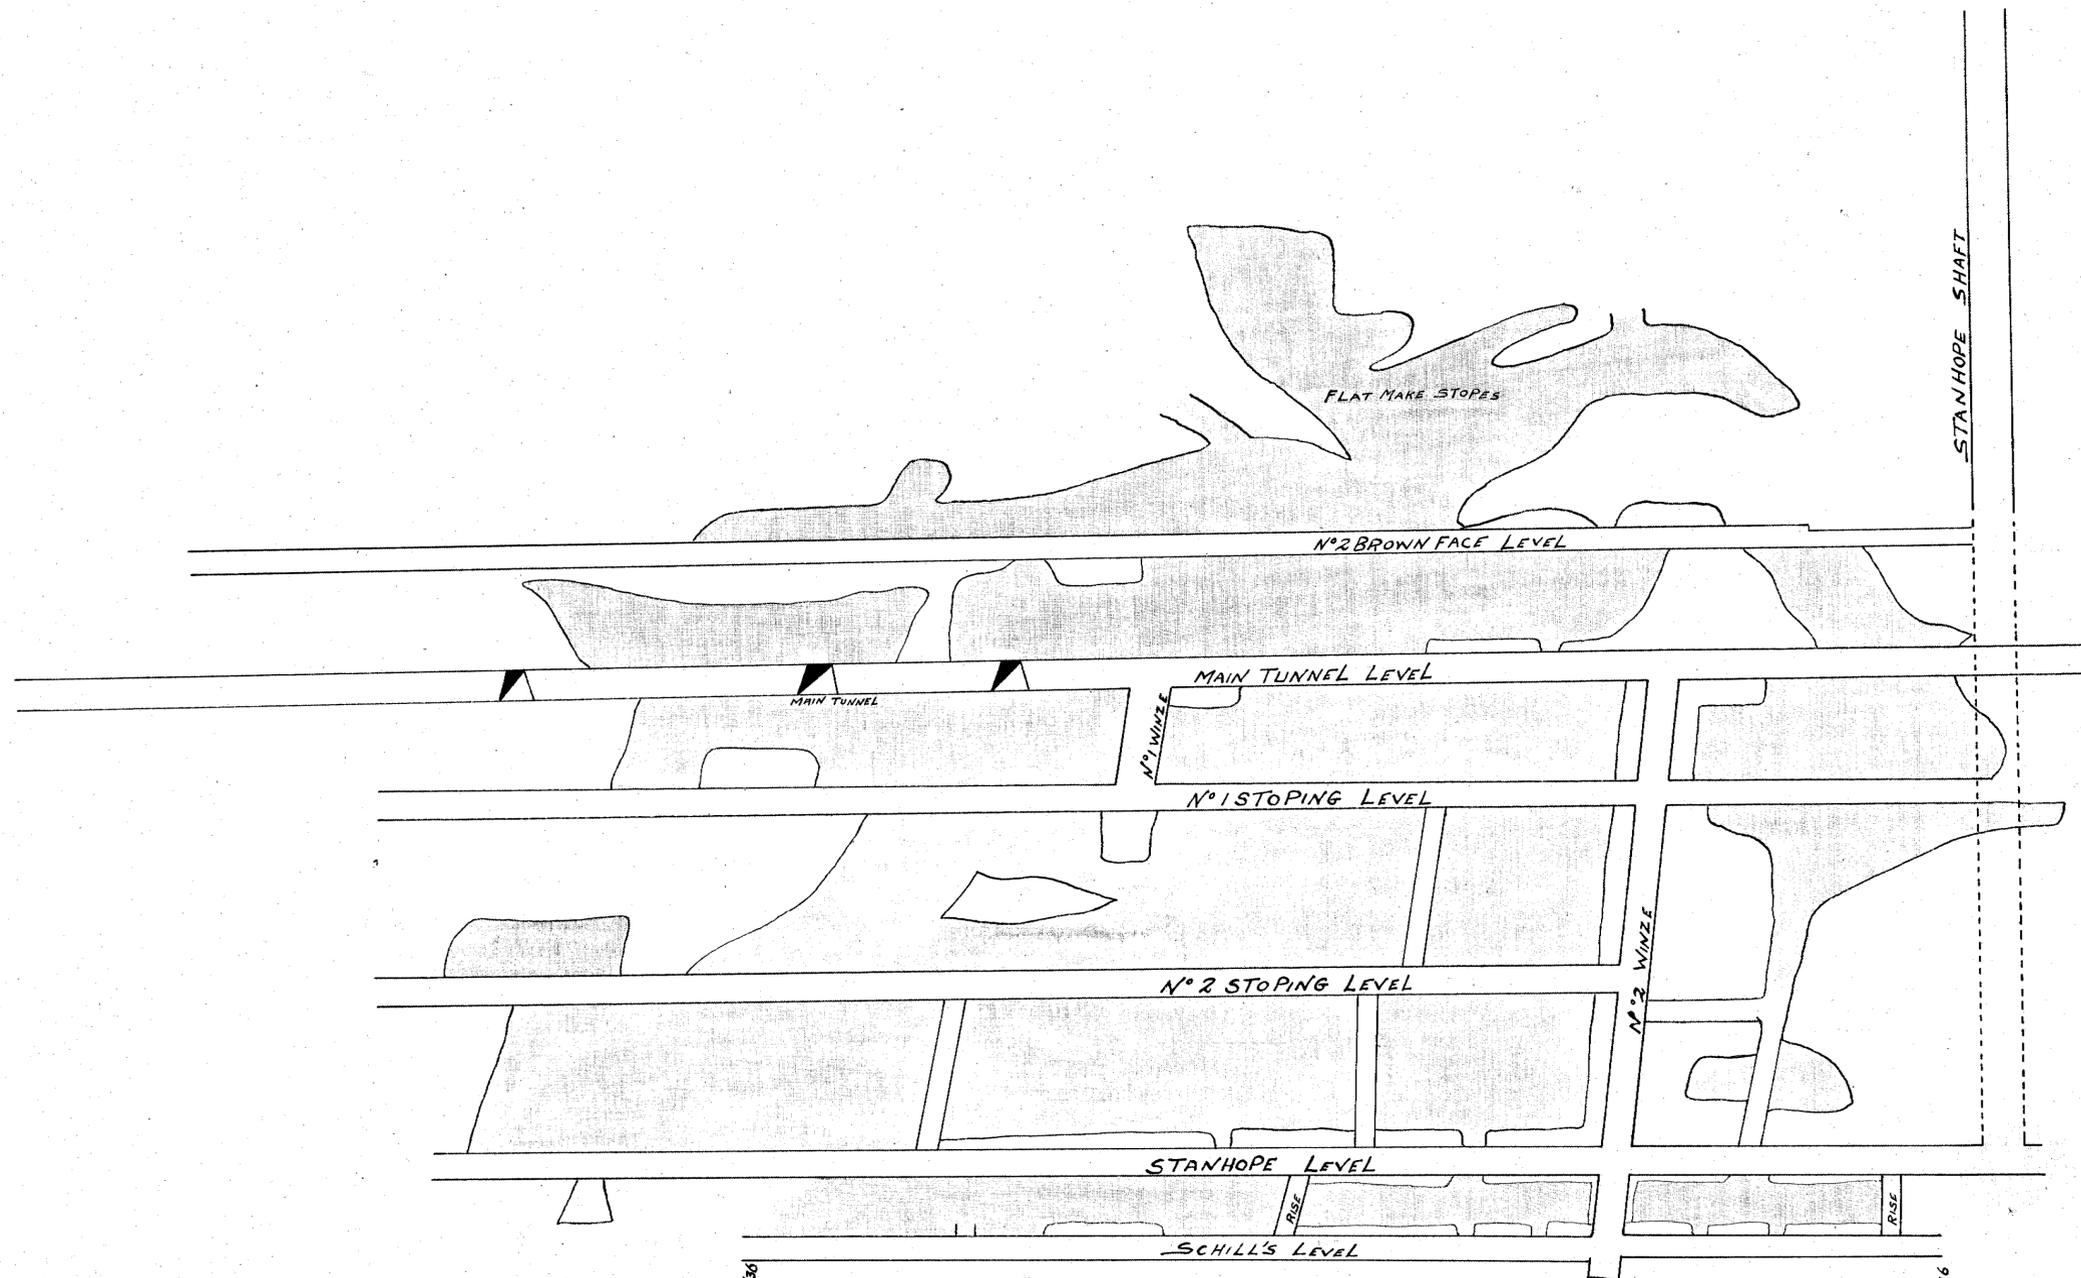

5 cm

217-73

217-73

Plan & Ex.  
C.M.D.  
29/4/37

WORK 1936 G.P. DATE  
SURVEYOR  
INITIATED 5/11/36  
DATE 7/1/37  
7.0 work done during 1937

30/10/36

30/10/36